

LEGEND	
AM	AMMETER
CPT	CONTROL POWER TRANSFORMER
CT	CURRENT TRANSFORMER
DO	DRAW-OUT MOUNTED
ED	ELECTRICALLY OPERATED
FSS	FIRST START SENSOR
GC	GENSET COMMONS CARD
GOM	GENSET COMMUNICATION MODULE
HZ	FREQUENCY METER
IIS	ISOSYNCHRONOUS LOAD SHARING CONTROL
MSS	MASTER START SENSOR
NGR	NEUTRAL GROUND RESISTOR
PLC	POWER FACTOR METER CONTROLLER
PLC	PROGRAMMABLE LOGIC CONTROLLER
PLC	PLC MAINS TRANSFORMER
SEL SW	SELECTOR SWITCH
15	SYNCHRONIZER
VM	VOLTMETER
WHM	WATT-HOUR METER
WM	WATTMETER
XDR	TRANSJUDER
21	UNDERVOLTAGE RELAY
22	UNDERVOLTAGE RELAY
32	DIRECTIONAL POWER RELAY
40	LOSS OF EXCITATION RELAY
47	NEGATIVE SEQUENCE VOLTAGE RELAY
50/51	TIME OVERCURRENT RELAY
51G	GROUND TIME OVERCURRENT RELAY
52-GN'	GENERATOR PARALLELING CIRCUIT BREAKER
59	OVERVOLTAGE RELAY
81	OVER/UNDER FREQUENCY RELAY
86	CONTROL POWER WIRES
-----	CONTROL SIGNAL OR DATA WIRES
-----	ETHERNET WIRE
-----	MODBUS+ WIRE
-----	MODBUS WIRE
-----	POWER CABLING
-----	POWER SYSTEM BUS
□	FUSE
□	PHYSICAL ENCLOSURE

- NOTES:
- INTERCONNECTION WIRING TO BE 14 AWG STRANDED WIRE MINIMUM. AC AND DC CONTROL WIRES TO BE RUN IN SEPARATE CONDUITS.
 - BATTERY CHARGER TO BATTERY WIRING TO BE SIZED FOR CHARGER OUTPUT AND LENGTH OF RUN.
FOR DC CONNECTIONS: USE 14 AWG OR LARGER FOR WIRE UP TO 40 FEET.
USE 12 AWG OR LARGER FOR WIRE UP TO 50 FEET.
USE 10 AWG OR LARGER FOR WIRE UP TO 100 FEET.
FOR AC CONNECTIONS: USE 14 AWG OR LARGER FOR WIRE UP TO 100 FEET.
 - CUSTOMER USE OF THE REMOTE EMERGENCY STOP, REMOTE START CONTROL, REMOTE PEAK SHAVE, AND REMOTE BASE LOAD FUNCTIONS ARE OPTIONAL. IF USED CUSTOMER SHOULD SUPPLY A N.O. DRY CONTACT THAT CLOSSES TO ACTIVATE.
 - PLC N.C. MALFUNCTION CONTACT WILL CLOSE IN EVENT OF A PLC FAILURE.
 - MODBUS PLUS (MB+) NETWORK WIRING - WIRE MUST BE ONAN A008E026 OR SQUARE D MODICON P/N 490NAA27103. CONSULT FACTORY IF DISTANCE FROM POWER SECTIONS TO MASTER CONTROL EXCEEDS 1500 FEET.
 - NET DATA WIRES TO BE MINIMUM 22 AWG NEMA LEVEL IV TWISTED PAIR COMMUNICATIONS CABLE. ONAN PART NUMBER A000Y856 (PVC) OR A000Y855 (PLENUM RATED) IS RECOMMENDED. CONNECTIONS ARE NOT POLARITY SENSITIVE. CONSULT THE FACTORY IF SUM OF DISTANCES FROM EACH GENSET TO THE MASTER CONTROL EXCEEDS 4600 FEET. DO NOT RUN IN CONDUIT WITH OTHER INTERCONNECT WIRES.
 - THE BREAKER TRIP COIL IS OPERATED BY A DRY CONTACT IN THE MASTER CONTROL. THE BREAKER CLOSE COIL IS OPERATED BY A DRY CONTACT IN THE MASTER CONTROL. CONTROL POWER FOR BREAKER CLOSE AND MOTOR OPERATION IS PROVIDED IN THE SWITCHGEAR. CONTACTS ARE RATED 10A, 120VAC/28VDC
 - ALL DEVICES NAMED WITH 'N'- THE 'N' IS REPLACED WITH THE GENSET# (TB11-GN' FOR GEN.#1 IS TB11-G1, GEN.#2 IS TB11-G2, ETC.)
 - NET DATA AND PARALLELING CABLES- CONNECT AS A DAISY CHAIN TO GEN.#2. THEN FROM GEN.#2 TO GEN.#3. ETC. GCM SWITCH S3 SET TO 'TERM' POSITION ON LAST GENSET ONLY.
 - PULL 20% EXTRA WIRES ON ALL RUNS FOR SPARES.
 - TOC 'A' SHOWN WITH CIRCUIT BREAKER IN THE RACKED OUT POSITION

PC NO.	LT# NO.	REVISION	ZONE	BRK	CHRG	APPRV	DATE	PC NO.	LT# NO.	REVISION	ZONE	BRK	CHRG	APPRV	DATE	
								PC104235	01	- PRODUCTION RELEASE ASBUILT			VS	VS	KT	08/25/10

PC NO.	LT# NO.	REVISION	ZONE	BRK	CHRG	APPRV	DATE

PROJECT: ARECIBO OBSERVATORY SWITCHGEAR
 NOTES:
 DISTRIBUTOR: CUMMINS CARIBBEAN
 7071681

DO NOT SCALE PRINT	SW ID	GENSET	DATE
			02/19/10
			02/19/10

SCALE TO: AUTOCAD DWG

THIS DOCUMENT IS THE PROPERTY OF CUMMINS. IT IS TO BE USED ONLY FOR THE PROJECT AND NOT BE REPRODUCED OR TRANSMITTED IN ANY FORM OR BY ANY MEANS, ELECTRONIC OR MECHANICAL, INCLUDING PHOTOCOPYING, RECORDING, OR BY ANY INFORMATION STORAGE AND RETRIEVAL SYSTEM.


PART NO.	NAME	DATE	SITE CODE
DR	V.SIVAN	02/19/10	PGA
CHK	V.SIVAN	02/19/10	PGA
APPROVED	K. TAJUMASI		

DESCRIPTION OF MATERIAL: PCL2004R-772F

TITLE: CUMMINS POWER GENERATION
 WD-INTERCONNECTION





DWG NO. A030S864

SHEET 1 of 7

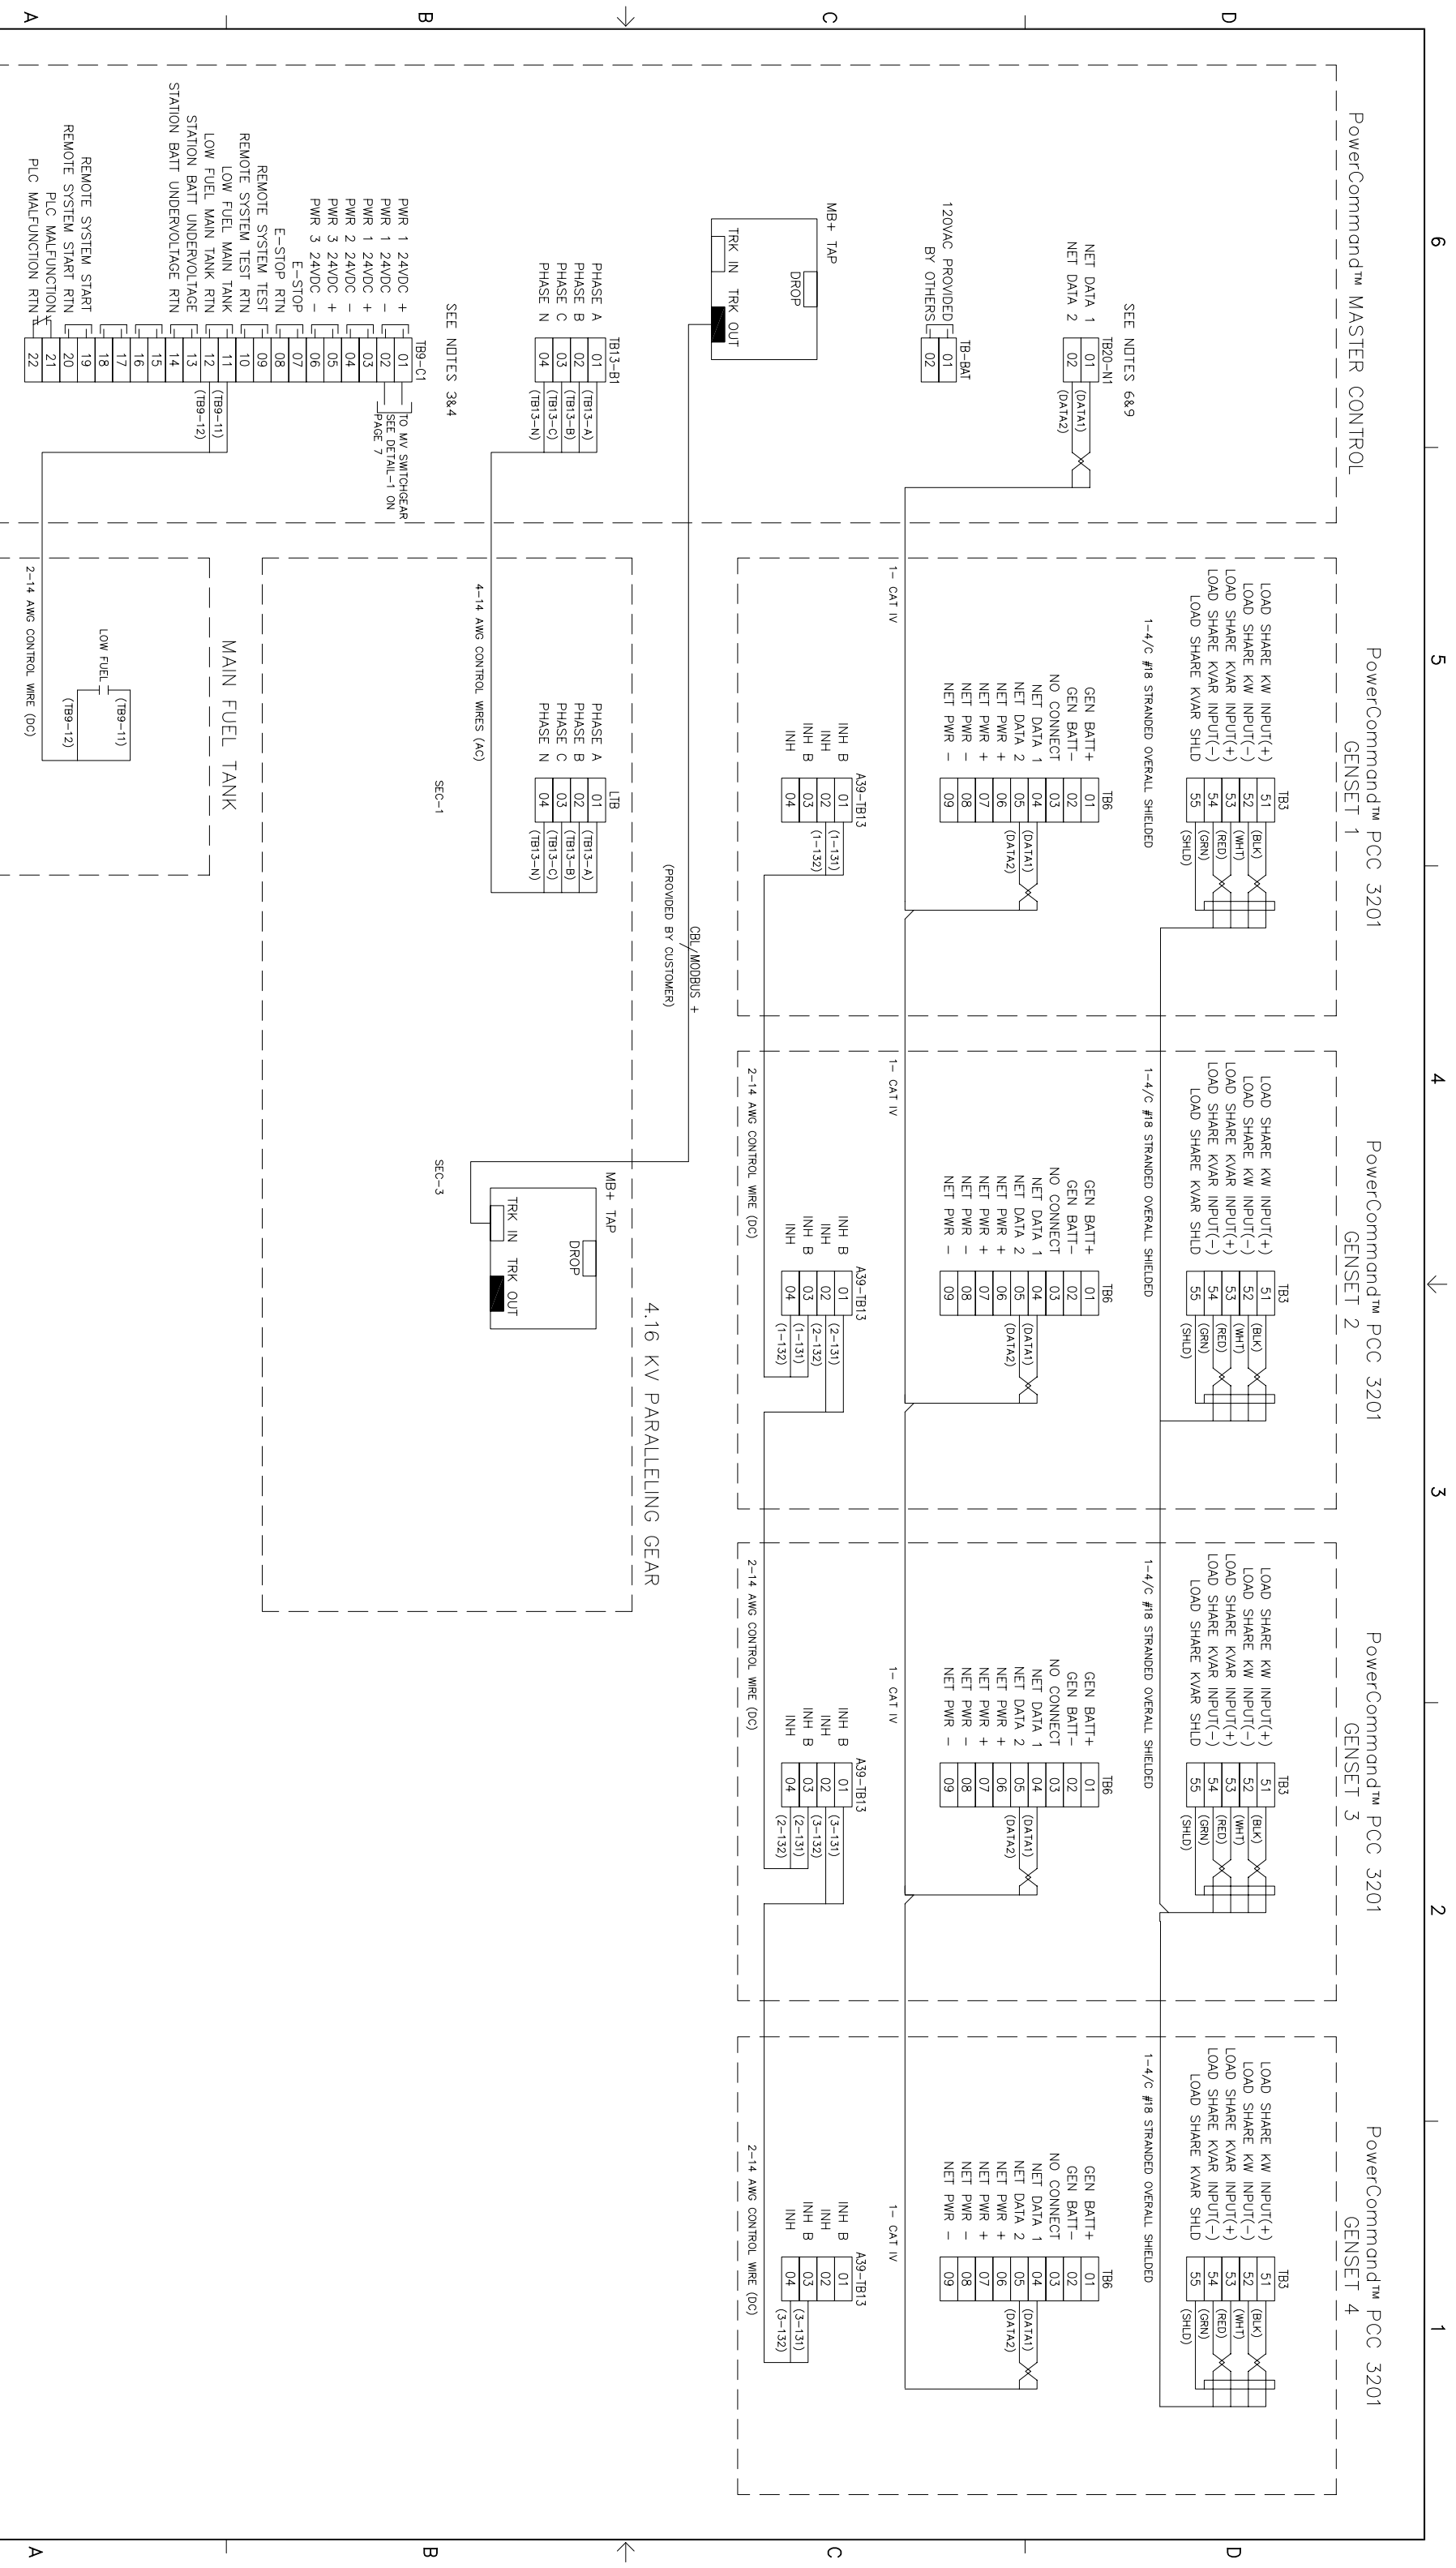

PC NO.	LTN NO.	REVISION	ZONE	DATA	CHNG	APPRV	DATE	PC NO.	LTN NO.	REVISION	ZONE	DATA	CHNG	APPRV	DATE	PC NO.	LTN NO.	REVISION	ZONE	DATA	CHNG	APPRV	DATE	
								PC104235	01	-	PRODUCTION RELEASE ASBUILT													
PROJECT: ARECBO OBSERVATORY SWITCHGEAR												PROJECT: ARECBO OBSERVATORY SWITCHGEAR												
GENSET INTERCONNECT 2												GENSET INTERCONNECT 2												
DISTRIBUTOR: CUMMINS CARIBBEAN												DISTRIBUTOR: CUMMINS CARIBBEAN												
7071681												7071681												
DO NOT SCALE PRINT												DO NOT SCALE PRINT												
AUTOCAD DWG												AUTOCAD DWG												
SCALE TO												SCALE TO												
DATE: 02/19/10												DATE: 02/19/10												
APPROVED: K. TIMMANS												APPROVED: K. TIMMANS												
PCL2004R-772F												PCL2004R-772F												
SITE CODE: PGA												SITE CODE: PGA												
TITLE: WD-INTERCONNECTION												TITLE: WD-INTERCONNECTION												
DWG NO.: A030S864												DWG NO.: A030S864												
SHEET: 4 of 7												SHEET: 4 of 7												
DATE: 02/19/10												DATE: 02/19/10												

PowerCommand™ MASTER CONTROL DMC1

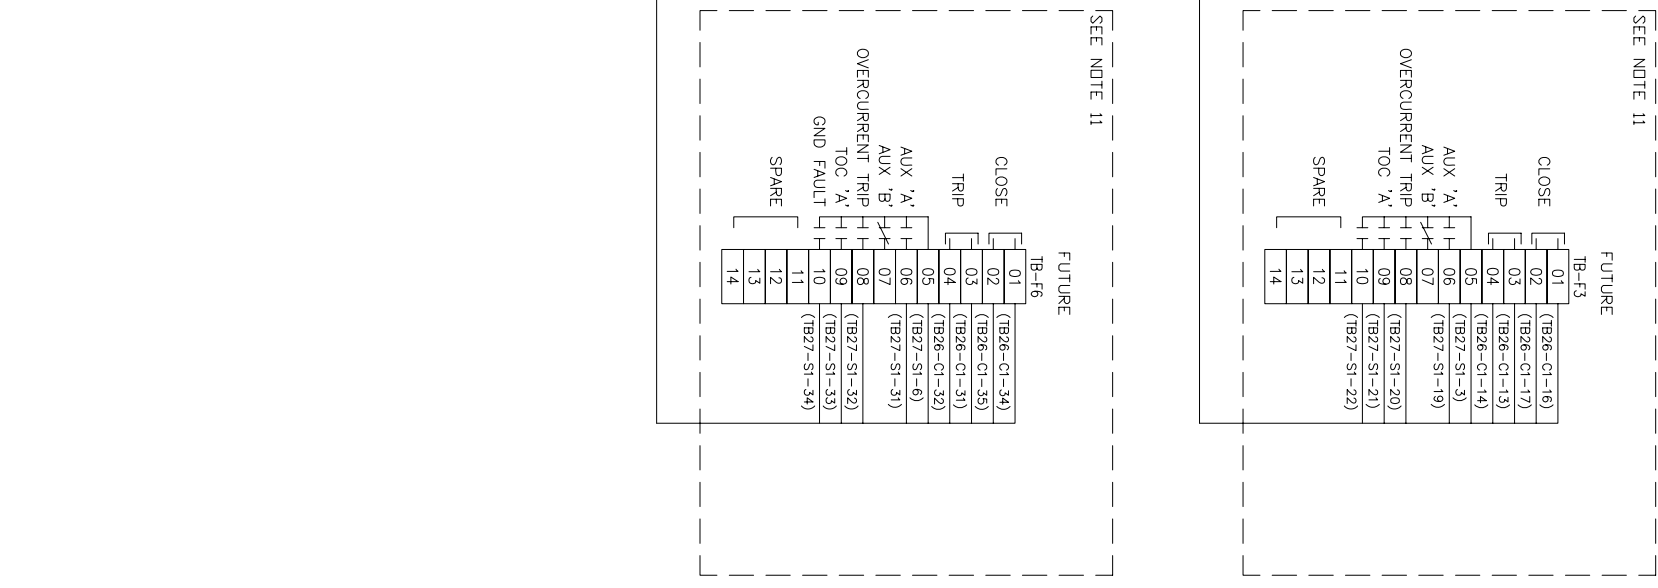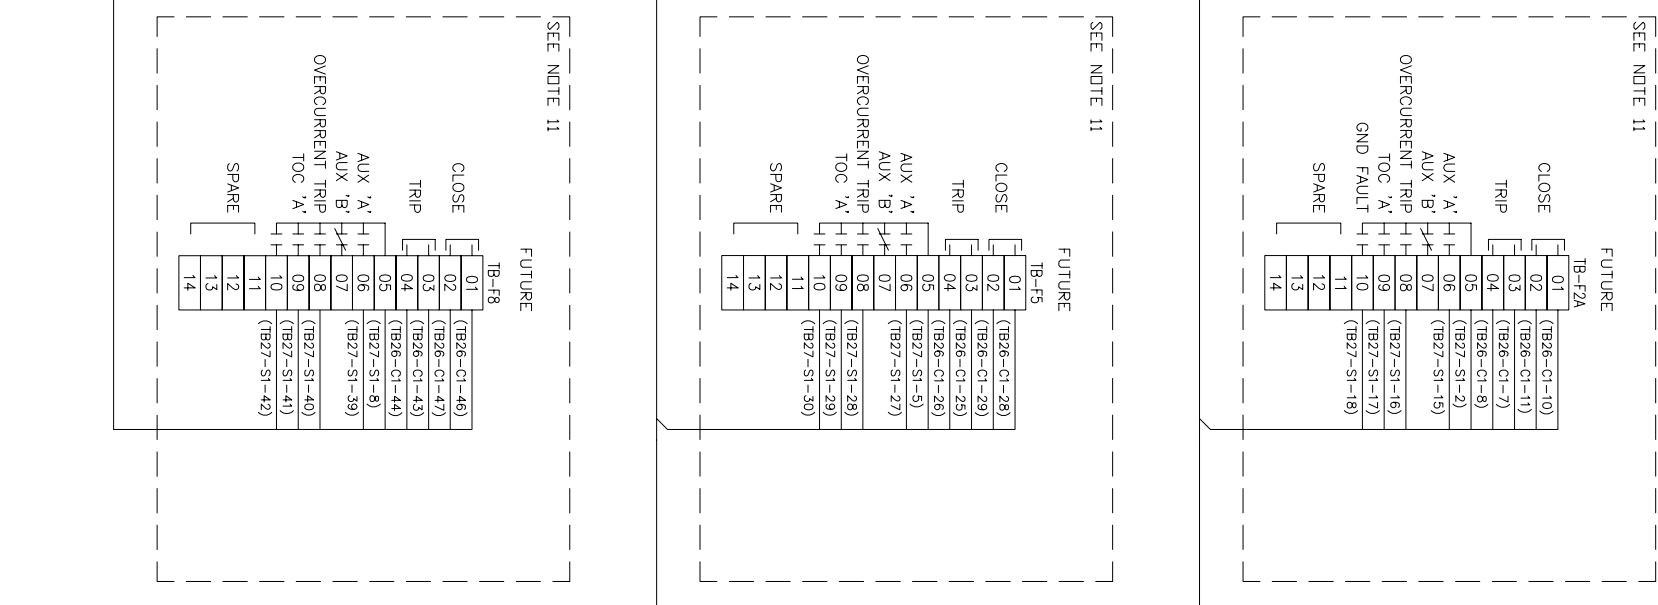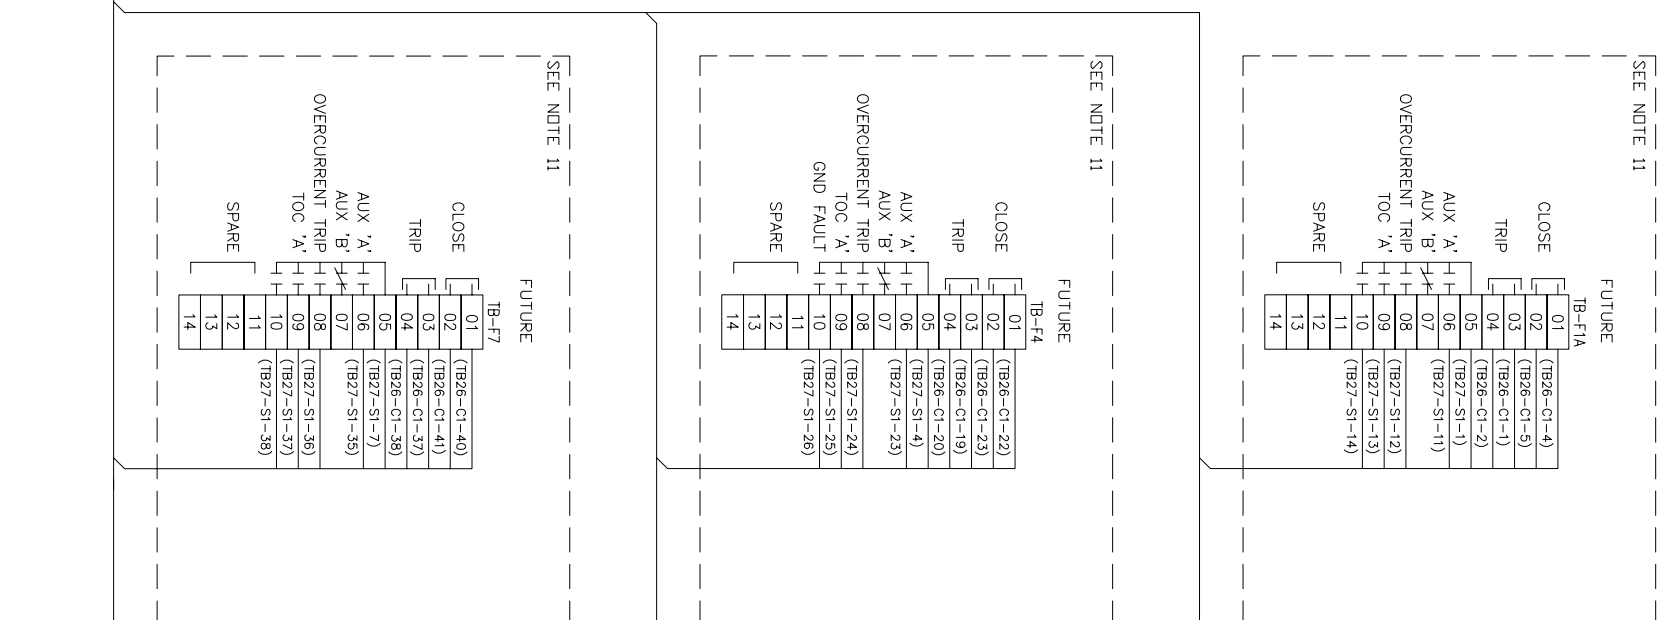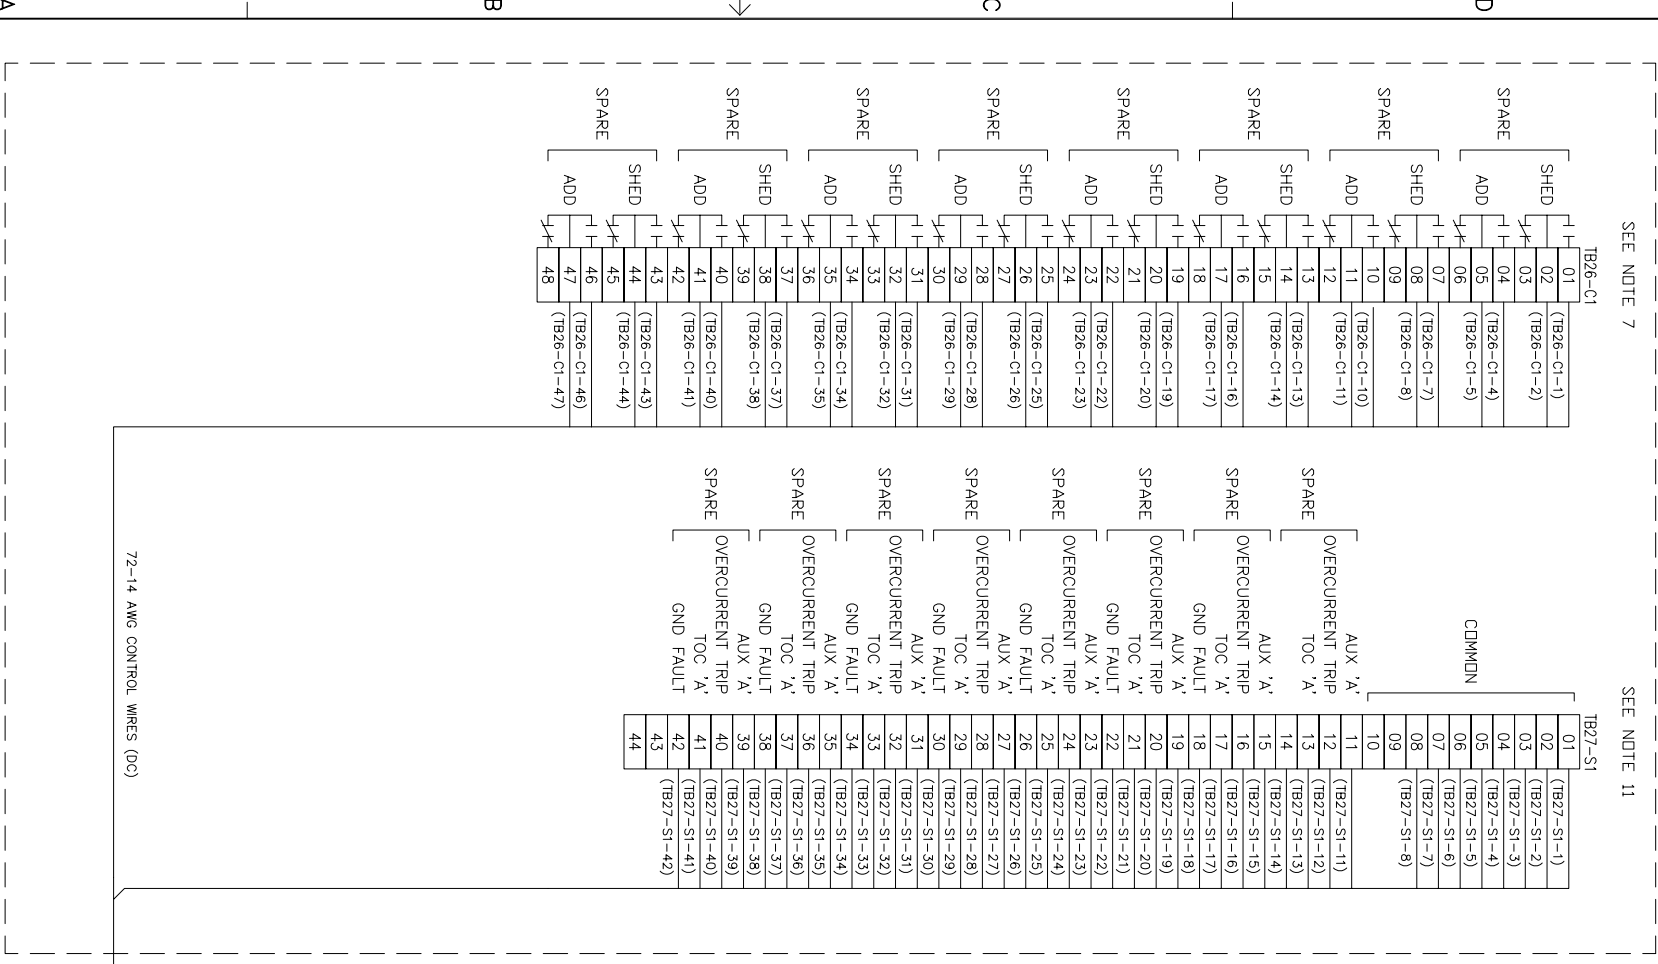

PC NO.	LTN NO.	REVISION	ZONE	DATA	CHG#	APPRV	DATE	PC NO.	LTN NO.	REVISION	ZONE	DATA	CHG#	APPRV	DATE
								PC104235	01	-	PRODUCTION	RELEASE	ASBUILT		

PROJECT:
 ARECIBO OBSERVATORY SWITCHGEAR
 A030S865_REV 01_SHT_
 DISTRIBUTOR:
 CUMMINS CARIBBEAN
 7071681

DO NOT SCALE PRINT		SCALE 1/2"		SCALE 1/4"	
AWG TOL		SCALE 1/2"		SCALE 1/4"	
AUTOCAD DWG					
<small>THIS DRAWING IS THE PROPERTY OF CUMMINS INC. AND IS LOANED TO YOU BY PERMISSION OF CUMMINS INC. IT IS NOT TO BE REPRODUCED OR TRANSMITTED IN ANY FORM OR BY ANY MEANS, ELECTRONIC OR MECHANICAL, INCLUDING PHOTOCOPYING, RECORDING, OR BY ANY INFORMATION STORAGE AND RETRIEVAL SYSTEM, WITHOUT THE WRITTEN PERMISSION OF CUMMINS INC.</small>					
REV	DATE	DESCRIPTION OF MATERIAL	DATE	REV	DATE
	02/19/10		02/19/10		02/19/10
DR	V.SIVAN			DR	V.SIVAN
CHK	V.SIVAN			CHK	V.SIVAN
APPROVED	K.TIMMANS			APPROVED	K.TIMMANS
PART NO.				PART NO.	
TITLE			SITE CODE		
WD-INTERCONNECTION			PGA		
CUMMINS POWER GENERATION			WD-INTERCONNECTION		
A030S864			A030S864		
5 of 7			5 of 7		

