DESCRIPTION	SHEET
TABLE OF CONTENTS	1
NETWORK DRAWING	2
NETWORK DETAIL	3
DMC MAIN 24VDC SCHEMATIC	4
DMC GEN 1 & 2 MAIN CONTROL	5
DMC GEN 3 & 4 MAIN CONTROL	6
BUS PT CONNECTION & PLC POWER	7
GENERATOR 1-4 PLC INPUTS	8
GENERATOR 1-4 PLC OUTPUTS	9
DMC FEEDER 1-8 STATUS	10
DMC FEEDER 1-8 LALS	11
SYSTEM AC METERING INPUT	12
SG 52-G3 AC SCHEMATICS	13
SG 52-G3 DC SCHEMATICS	14
SG 52-G4 AC SCHEMATIC	15
SG 52-G4 DC SCHEMATIC	16
SG 52-G1 AC SCHEMATIC	17
SG 52-G1 DC SCHEMATIC	18
SG 52-G2 AC SCHEMATIC	19
SG 52-G2 DC SCHEMATICS	20
SG 52-F1 AC SCHEMATIC	21
SG 52-F1 DC SCHEMATICS	22
SG 52-F2 AC SCHEMATIC	23
SG 52-F2 DC SCHEMATICS	24
SG 52-F1 & F2 IO SCHEMATICS	25
DMC DOOR PANEL LAYOUT	26
DMC DOOR PANEL LAYOUT BOM	27
DMC UPR REAR PANEL LAYOUT	28
DMC UPR REAR PANEL LAYOUT BOM	29
DMC LOWER REAR PANEL LAYOUT	30
DMC LOWER REAR PANEL LAYOUT BOM	31
DMC UPR LH PANEL LAYOUT	32
DMC UPR LH PANEL LAYOUT BOM	33
DMC FLOOR PANEL LAYOUT	34
DMC FLOOR PANEL LAYOUT BOM	35
SG S1A CELL PANEL LAYOUT	36
SG S1A CELL PANEL LAYOUT BOM	37
SG S1A DOOR PANEL LAYOUT	38
SG S1A DOOR PANEL LAYOUT BOM	39
SG S1B CELL PANEL LAYOUT	40

DESCRIPTION	SHEET
SG S1B CELL PANEL LAYOUT BOM	41
SG S1B DOOR PANEL LAYOUT	42
SG S1B DOOR PANEL LAYOUT BOM	43
SG S2A CELL PANEL LAYOUT	44
SG S2A CELL PANEL LAYOUT BOM	45
SG S2A DOOR PANLE LAYOUT	46
SG S2A DOOR PANEL LAYOUT BOM	47
SG S2B CELL PANEL LAYOUT	48
SG S2B CELL PANEL LAYOUT BOM	49
SG S2B DOOR PANEL LAYOUT	50
SG S2B DOOR PANEL LAYOUT BOM	51
SG S3A CELL PANEL LAYOUT	52
SG S3A PANEL LAYOUT BOM	53
SG S3A DOOR PANEL LAYOUT	54
SG S3A DOOR PANEL LAYOUT BOM	55
SG S3B CELL PANEL LAYOUT	56
SG S3B CELL PANEL LAYOUT BOM	57
SG S3B DOOR PANEL LAYOUT	58
SG S3B DOOR PANEL LAYOUT BOM	59
SG S4A CELL PANEL LAYOUT	60
SG S4A CELL PANEL LAYOUT BOM	61

PC NO.	LTR	NO.	REVISION	ZONE	DRA	CHKR	APRV	DATE
PC104235	01	A	PRODUCTION RELEASE AS-BUILT	–	VS	VS	KT	06/17/10

PROJECT:
ARECIBO OBSERVATORY SWITCHGEAR
TABLE OF CONTENTS
DISTRIBUTOR:
CUMMINS CARIBBEAN
7071681

DO NOT SCALE PRINT

SIM TO
COPIED FROM
THREE ANGLE PROJECTION
ANG TOL
DRAWN TO SCALE OF

AUTOCAD DWG

THIS DOCUMENT IS THE PROPERTY OF CUMMINS POWER GENERATION. IT CONTAINS PROPRIETARY AND CONFIDENTIAL INFORMATION WHICH MUST NOT BE REPRODUCED, USED OR DISCLOSED OTHER THAN EXPRESSLY AUTHORIZED BY CUMMINS POWER GENERATION OR ITS REPRESENTATIVE

	NAME	DATE
DR	V.SAKLANI	06/17/10
CHKR / MFG	V. SIVAN	06/17/10
APPROVED	K.TWUMASI	06/17/10

FOR INTERPRETATION OF DIMENSIONING AND TOLERANCING, SEE ANSI Y14.5M-1982

MODEL FIRST USED ON PCIL2004R-772F

PART NO. | DWG SIZE | DESCRIPTION OF MATERIAL | REF DES

SITE CODE PGA

CUMMINS POWER GENERATION
1400 73rd AVE.NE
MINNEAPOLIS, MN 55432

TITLE WD-SCHEMATISC

DWG NO. A030S865 | SHEET 1 OF 61 | DWG SIZE D

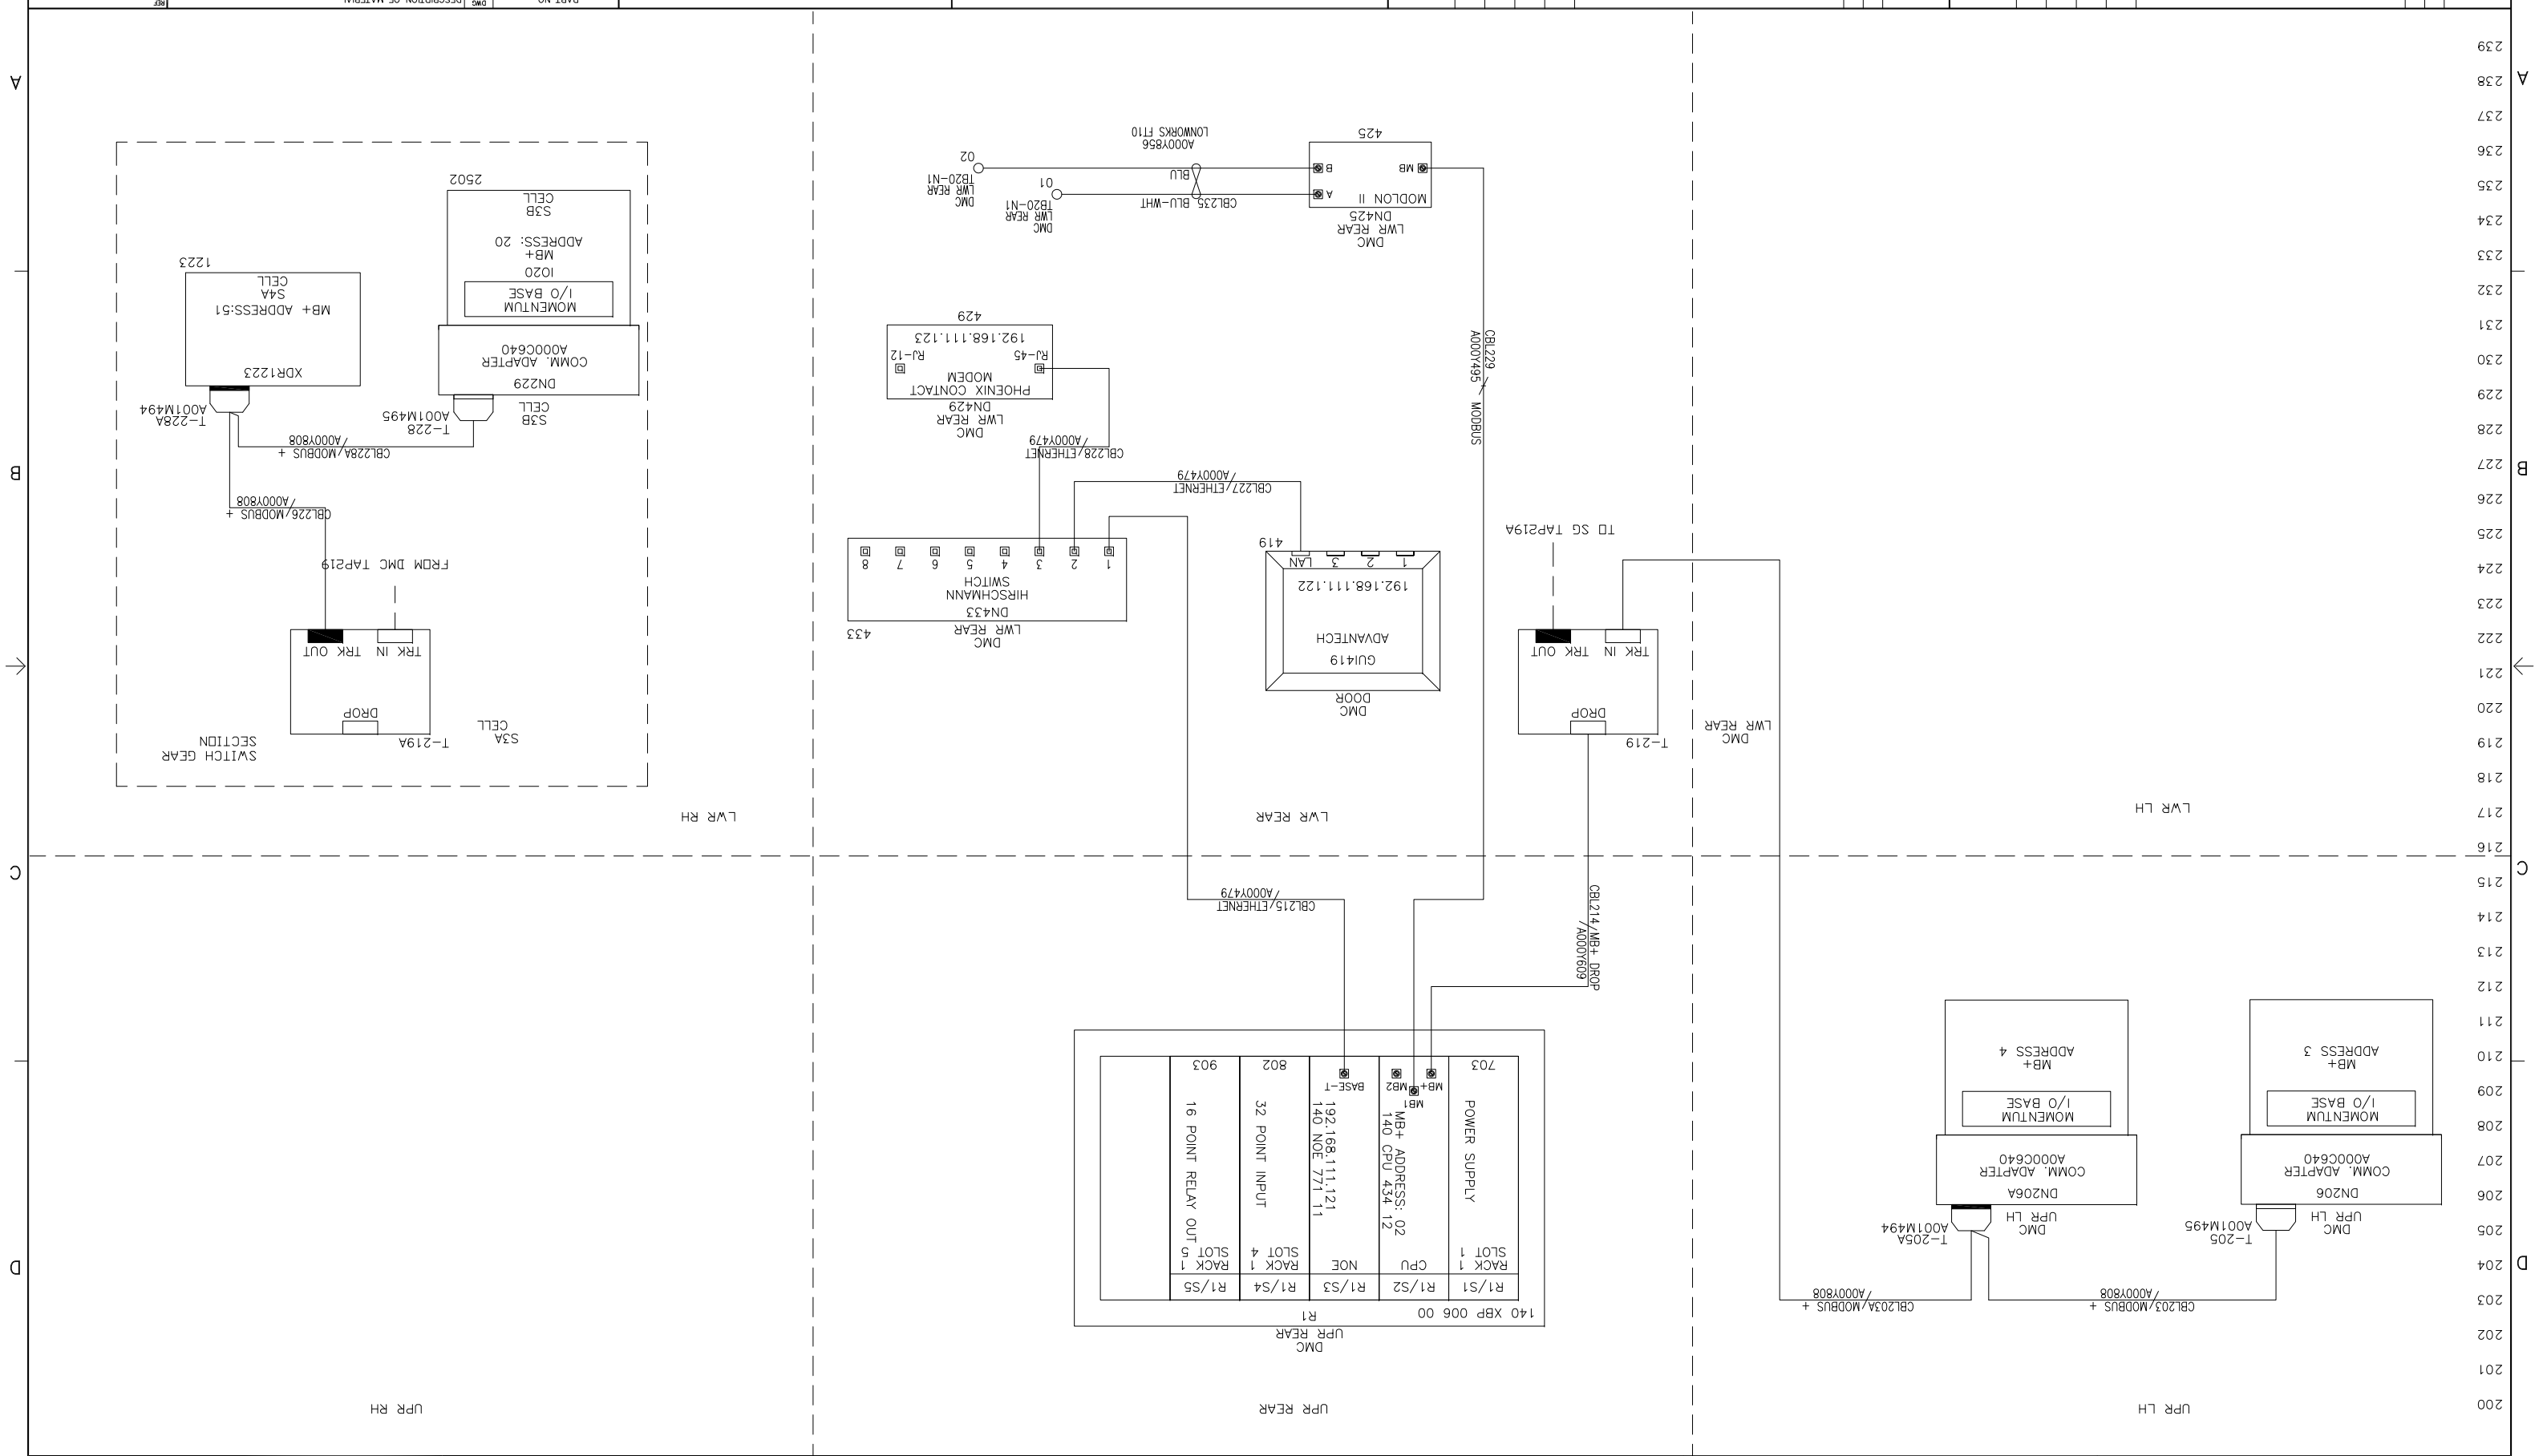

PC NO.	LTR	NO.	REVISION	ZONE	DRA	CHKR	APRV	DATE	PC NO.	LTR	NO.	REVISION	ZONE	DRA	CHKR	APRV	DATE
									PC104235	01	A	PRODUCTION RELEASE AS-BUILT	–	VS	VS	KT	06/17/10

PROJECT:
ARECIBO OBSERVATORY SWITCHGEAR
NETWORK DRAWING
DISTRIBUTOR:
CUMMINS CARIBBEAN
707168I

AUTOCAD DWG

DO NOT SCALE PRINT

PART NO.	DWG SIZE	DESCRIPTION OF MATERIAL	REF DES

	NAME	DATE
DRAWN	V.SAKLANI	06/17/10
CHKD	V. SIVAN	06/17/10
APPROVED	K.TMUMASI	06/17/10

CUMMINS POWER GENERATION
1400 73rd AVE NE
MINNEAPOLIS, MN 55432

TITLE
WD-SCHEMATISC

SITE CODE
PGA

DWG NO. A030S865
SHEET 2 OF 61
DWG SIZE D

MODBUS PLUS CABLE CONNECTORS

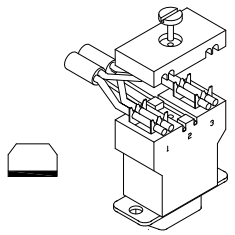

NOTE:
REMOVE 3" OF THE CABLE OUTER JACKET AND SHIELDS (THIS WILL EXPOSE THE 2 SIGNAL WIRES AND DRAIN WIRE). INSERT THE CONNECTOR INTO THE CONNECTOR TOOL (#AS-MBPL-001) WITH THE CAP REMOVED. INSERT THE WIRES AS SHOWN (BLU OR BLK INTO POSITION #3; DRAIN WIRE, POSITION #2, WHT WIRE, POSITION #1). REPLACE THE CAP (WITHOUT THE SCREW) AND CLOSE THE TOOL FIRMLY. INSERT THE CAP SCREW AND TIGHTEN.

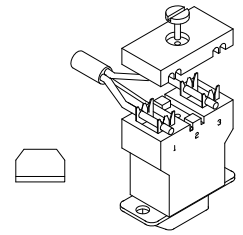

INLINE CONNECTOR	
PIN	WIRE COLOR
PIN 1	WHITE/BLUE
PIN 2	SHIELD
PIN 3	BLUE/WHITE

NOTE:
MODBUS PLUS CABLE SHOULD BE A MINIMUM OF 10 FEET BETWEEN TERMINATIONS. THE NETWORK SHOULD BE A MAXIMUM OF 1500 FEET.

TERM. CONNECTOR	
PIN	WIRE COLOR
PIN 1	WHITE/BLUE
PIN 2	SHIELD
PIN 3	BLUE/WHITE

BITRONICS TRANSDUCER

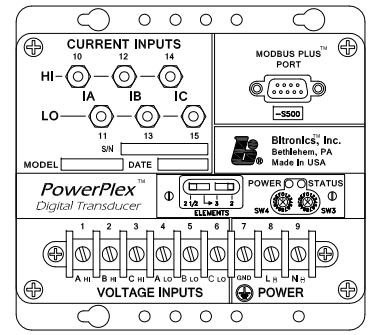

BITRONICS
TRANSDUCER

MB+ ADDRESS:XX

NOTE:
MODBUS PLUS CABLE SHOULD BE A MINIMUM OF 10 FEET BETWEEN TERMINATIONS. THE NETWORK SHOULD BE A MAXIMUM OF 1500 FEET.

ADDRESS SWITCHES

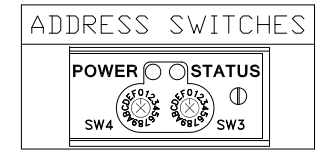

ADDRESS SETTINGS		
ADDRESS	SW4	SW3
01	0	0
02	0	1
03	0	2
04	0	3
05	0	4
06	0	5
07	0	6
08	0	7
09	0	8
10	0	9
11	0	A
12	0	B
13	0	C
14	0	D
15	0	E
16	0	F

ADVANTECH TOUCHSCREEN

NOTE:
RECOMMENDED ETHERNET CABLE P/N 0335-0198.

NOTE:
ETHERNET CABLE SHOULD BE MINIMUM TWISTED PAIR CAT V CABLE WITH RJ45 CONNECTORS AND A MAXIMUM OF 300 FEET.

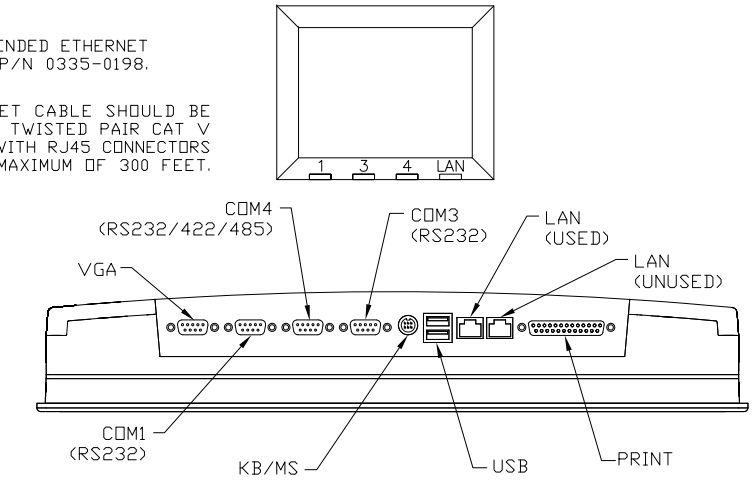

MODBUS PLUS SUPER TAP

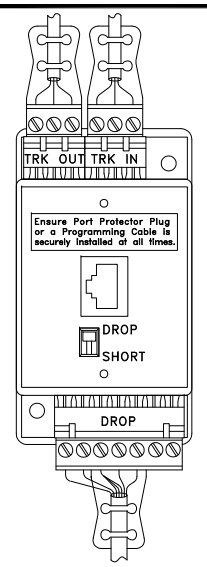

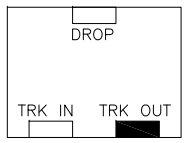

NOTE:
CONNECT ALL 3 DROP GROUND WIRES TOGETHER TO PIN 3.

NOTE:
MODBUS PLUS CABLE SHOULD BE A MINIMUM OF 10 FEET BETWEEN TERMINATIONS. THE NETWORK SHOULD BE A MAXIMUM OF 1500 FEET.

TRK IN	
PIN	WIRE COLOR
WH	WHITE
BL	BLUE
GND	GROUND

TRK OUT	
PIN	WIRE COLOR
WH	WHITE
BL	BLUE
GND	GROUND

DROP CABLE	
PIN	WIRE COLOR
1: BL	ORANGE
2: WH	WHITE
3: GND	GROUND (3)
4: BL	BLUE
5: WH	WHITE
6: GND	N/C
7: GND	N/C

QUANTUM PLATFORM CPU

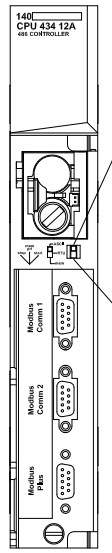

3-POS DIPSWITCH

POSITION	MODE
	ASCII
	RTU
	MEM

NORMAL POSITION: RTU

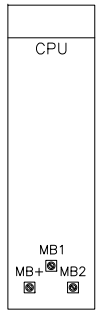

3-POS KEYSWITCH

POSITION	MODE
	START
	MEM PRT
	STOP

NORMAL POSITION: START

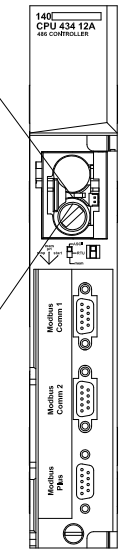

REAR ADDRESS SWITCH

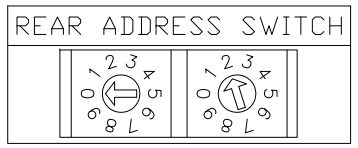

DEFAULT ADDRESS: 02

QUANTUM NOE MODULE

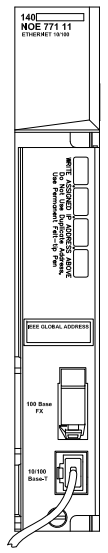

NOTE:
RECOMMENDED ETHERNET CABLE P/N 0335-0198.

NOTE:
ETHERNET CABLE SHOULD BE MINIMUM TWISTED PAIR CAT V CABLE WITH RJ45 CONNECTORS AND A MAXIMUM OF 300 FEET.

MODLON GATEWAY

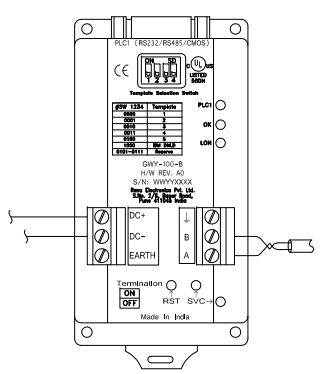

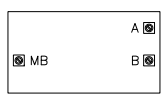

NOTE:
DO NOT GROUND MODLON.

NOTE:
RECOMMENDED FT10 LONWORKS CABLE IS P/N 0334-1350.

LONWORKS CABLE	
PIN	WIRE COLOR
A	BLUE/WHITE
B	BLUE

DIPSWITCH SETTINGS

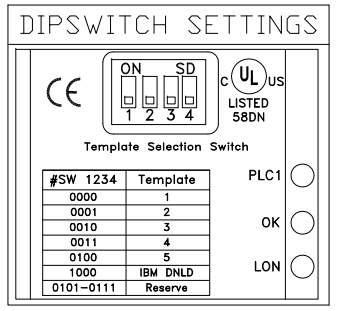

#SW 1234	Template
0000	1
0001	2
0010	3
0011	4
0100	5
1000	IBM DNLD
0101-0111	Reserve

MOMENTUM ADAPTERS

COMM. ADAPTER

CPU
MB
RJ 45

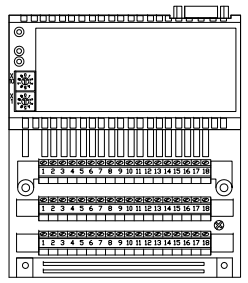

ADDRESS SWITCH

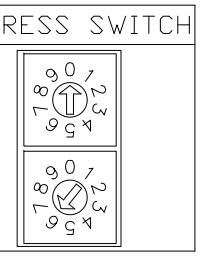

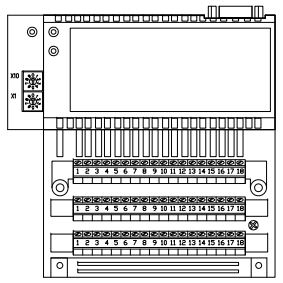

DEFAULT ADDRESS: SEE NETWORK DRAWING

PC NO.	LTR	NO.	REVISION	ZONE	DRA	CHKR	APRV	DATE
PC104235	01	A	PRODUCTION RELEASE AS-BUILT	–	VS	VS	KT	06/17/10

PROJECT:
ARECIBO OBSERVATORY SWITCHGEAR NETWORK DETAIL
DISTRIBUTOR:
CUMMINS CARIBBEAN
7071681

DO NOT SCALE PRINT

ANG TOL | DRAWN TO SCALE OF

AUTOCAD DWG

SIM TO | COPIED FROM | THREE ANGLE PROJECTION

THIS DOCUMENT IS THE PROPERTY OF CUMMINS POWER GENERATION. IT CONTAINS PROPRIETARY AND CONFIDENTIAL INFORMATION WHICH MUST NOT BE DUPLICATED, USED OR DISCLOSED OTHER THAN EXPRESSLY AUTHORIZED BY CUMMINS POWER GENERATION OR ITS REPRESENTATIVE

PART NO.	DWG SIZE	DESCRIPTION OF MATERIAL	REF DES

	NAME	DATE
DR	V.SAKLANI	06/17/10
CHKR / MFG	V. SIVAN	06/17/10
APPROVED	K.TWUMASI	06/17/10

FOR INTERPRETATION OF DIMENSIONING AND TOLERANCING, SEE ANSI Y14.5M-1982

MODEL FIRST USED ON: PCIL2004R-772F

SITE CODE: PGA

CUMMINS POWER GENERATION
1400 73rd AVE.NE
MINNEAPOLIS, MN 55432

TITLE: WD-SCHEMATISC

DWG NO. A030S865 | SHEET 3 OF 61 | DWG SIZE D

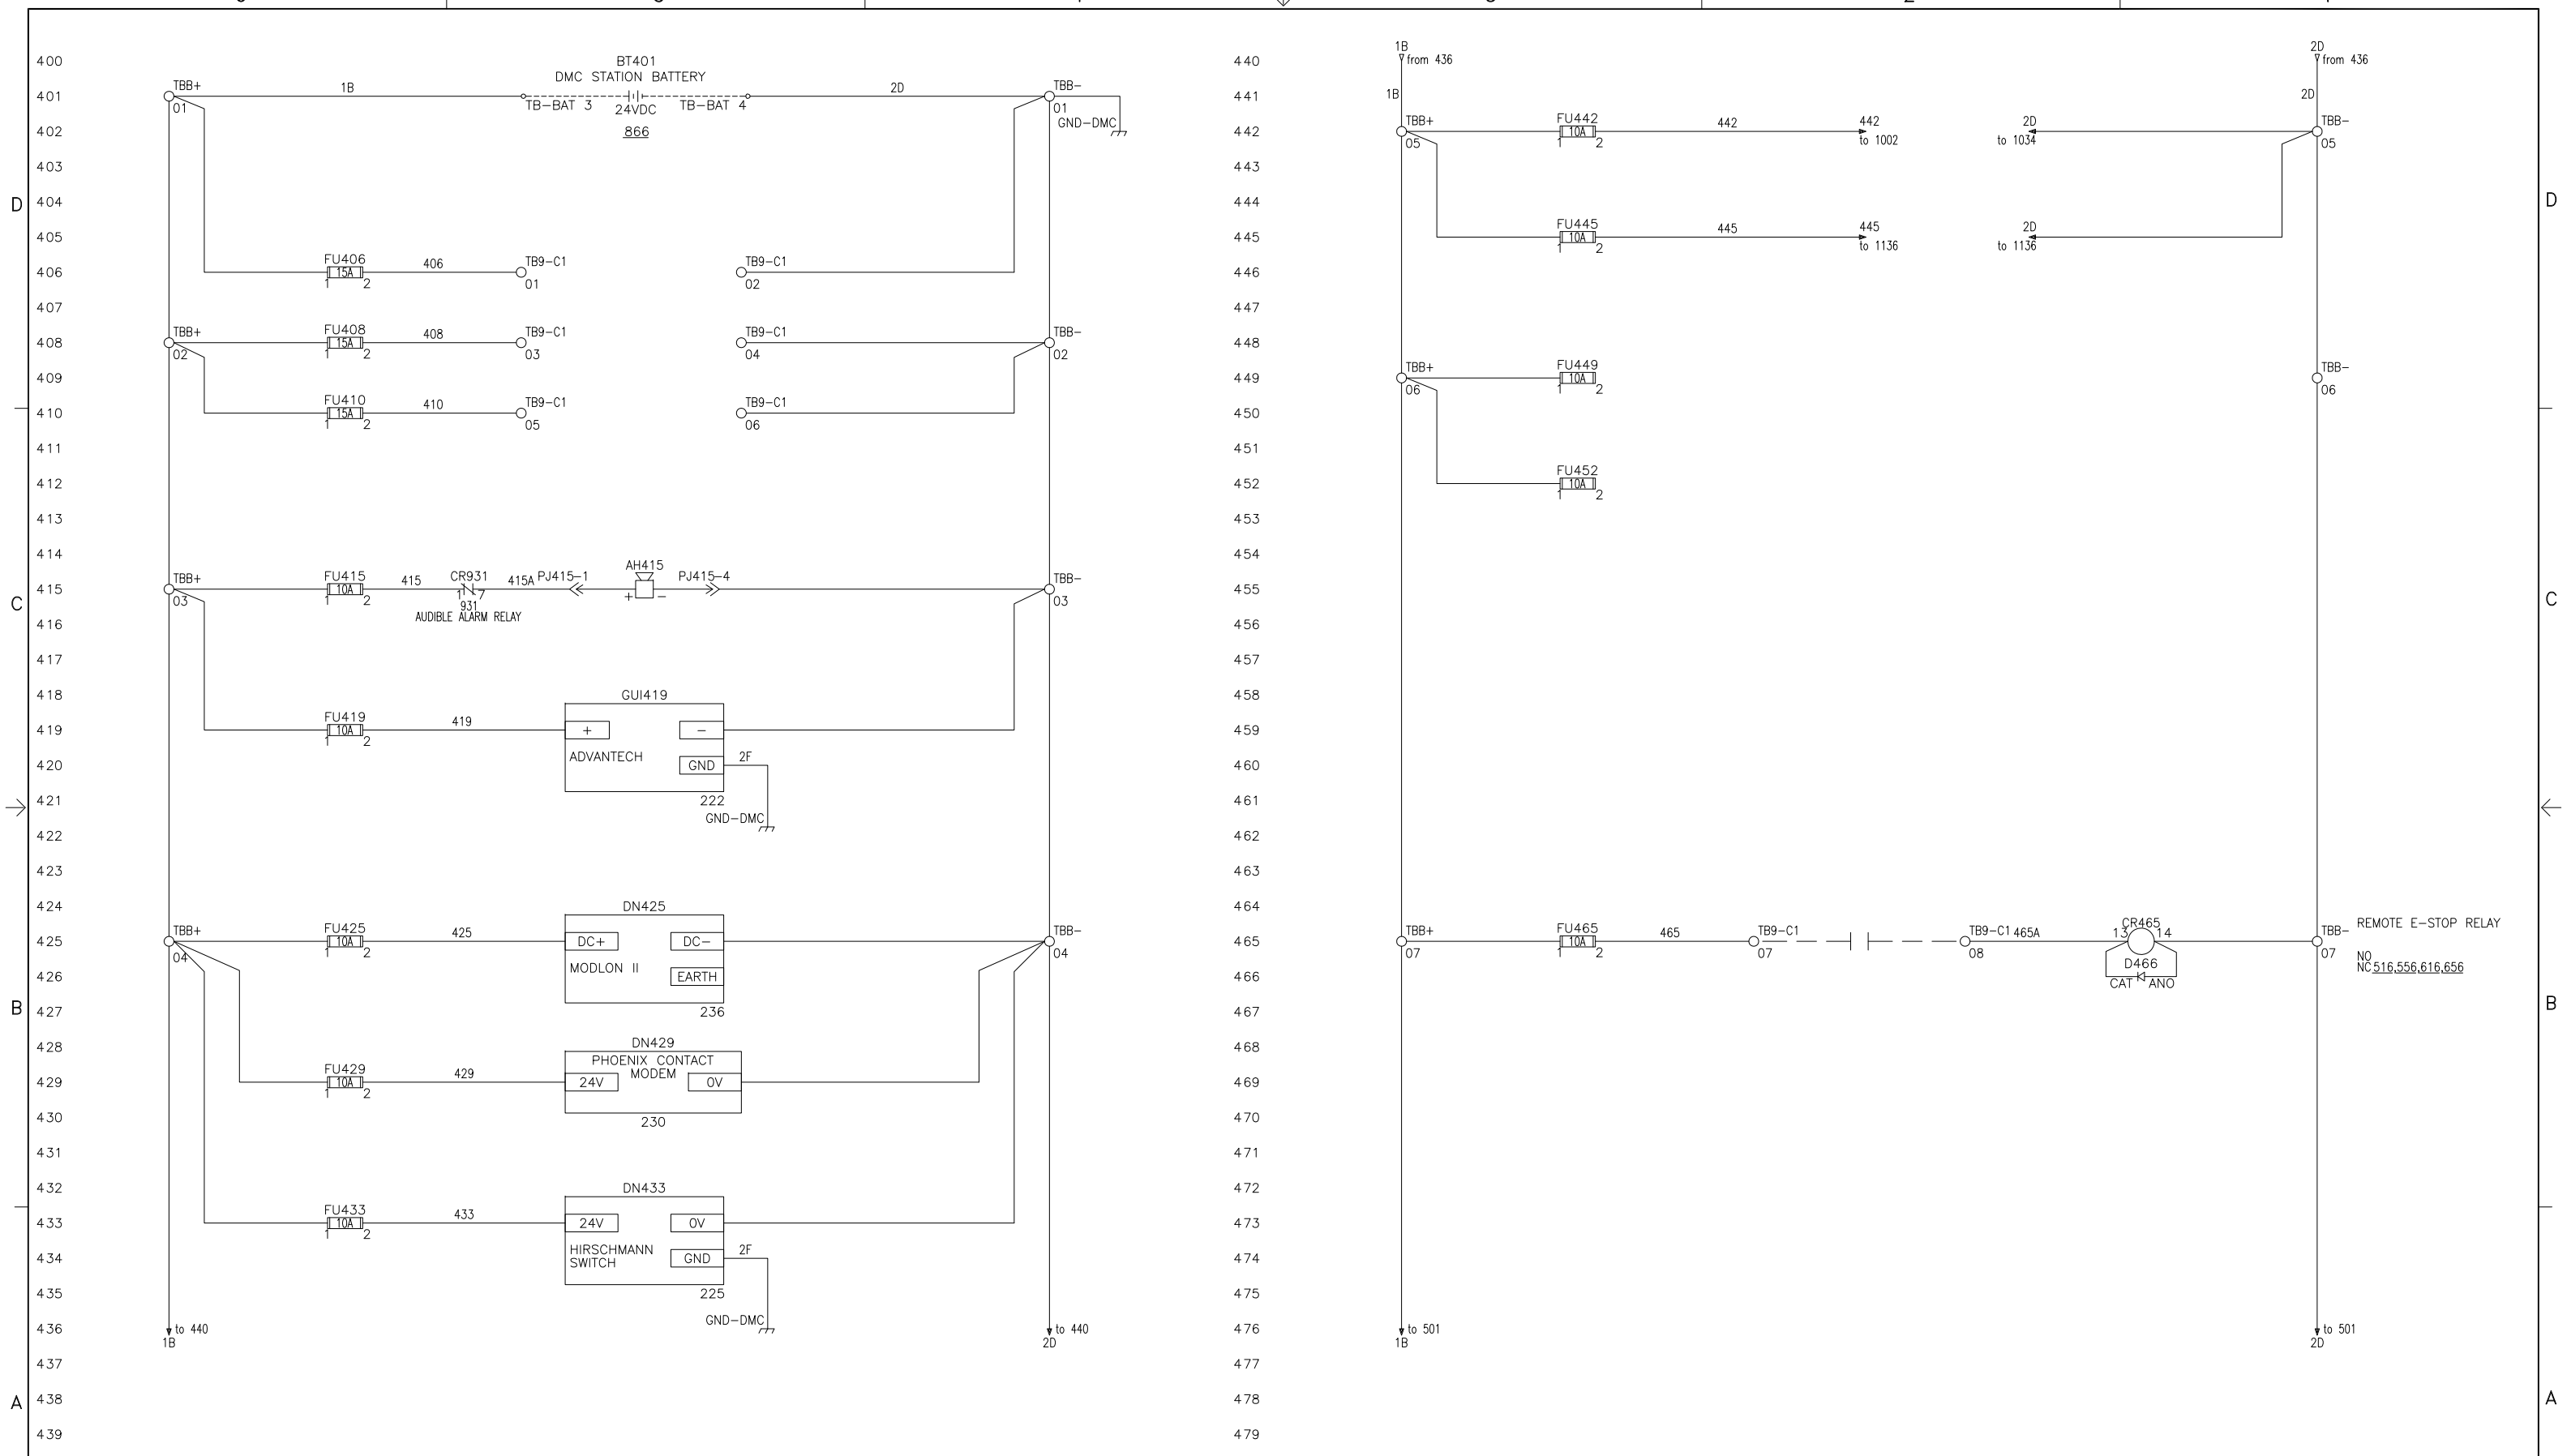

PC NO.	LTR	NO.	REVISION	ZONE	DRA	CHKR	APRV	DATE
PC104235	01	A	PRODUCTION RELEASE AS-BUILT	–	VS	VS	KT	06/17/10

PROJECT:
ARECIBO OBSERVATORY SWITCHGEAR
DMC MAIN 24VDC SCHEMATIC
DISTRIBUTOR:
CUMMINS CARIBBEAN
7071681

DO NOT SCALE PRINT

AUTOCAD DWG

PART NO.	DWG SIZE	DESCRIPTION OF MATERIAL	REF DES

	NAME	DATE
DR	V.SAKLANI	06/17/10
CHKR / MFG	V. SIVAN	06/17/10
APPROVED	K.TWUMASI	06/17/10

MODEL FIRST USED ON PCIL2004R-772F

SITE CODE PGA

CUMMINS POWER GENERATION
1400 73rd AVE.NE
MINNEAPOLIS, MN 55432

TITLE WD-SCHEMATISC

DWG NO. A030S865 SHEET 4 OF 61 SIZE D

PC NO.	LTR	NO.	REVISION	ZONE	DRA	CHKR	APRV	DATE	REVISION	PC NO.	LTR	NO.	ZONE	DRA	CHKR	APRV	DATE
									PC104235	01	A	PRODUCTION RELEASE AS-BUILT	–	VS	VS	KT	06/17/10

PROJECT:
ARECIBO OBSERVATORY SWITCHGEAR
DMC GEN 1 & 2 MAIN CONTROL
DISTRIBUTOR:
CUMMINS CARIBBEAN
707168I

DO NOT SCALE PRINT

SW 10	NAME	DATE	
CHKD PROJ	OR V.SAKLANI	06/17/10	
CHKD MFG	V. SIVAN	06/17/10	
	APPROVED K.TMUMASI	06/17/10	

SITE CODE

PART NO. | DWG SIZE | DESCRIPTION OF MATERIAL | REF DES

CUMMINS POWER GENERATION
1400 73rd AVE NE
MINNEAPOLIS, MN 55432

TITLE
WD-SCHEMATISC

AUTOCAD DWG

THIS DOCUMENT IS THE PROPERTY OF CUMMINS POWER GENERATION. IT CONTAINS PROPRIETARY AND CONFIDENTIAL INFORMATION WHICH MUST NOT BE DUPLICATED, USED OR DISCLOSED EITHER IN WHOLE OR IN PART WITHOUT WRITTEN PERMISSION OF CUMMINS POWER GENERATION OR ITS REPRESENTATIVE

THIRD ANGLE PROJECTION

DRAWN TO SCALE OF

ANG TOL

FROM INTERPRETATION OF DIMENSIONS AND TOLERANCES SEE ANSI Y14.5M-1982

MODEL FIRST USED ON PCLL2004R-772F

SIZE PGA

DWG NO. A030S865 SHEET 5 OF 61 DWG SIZE D

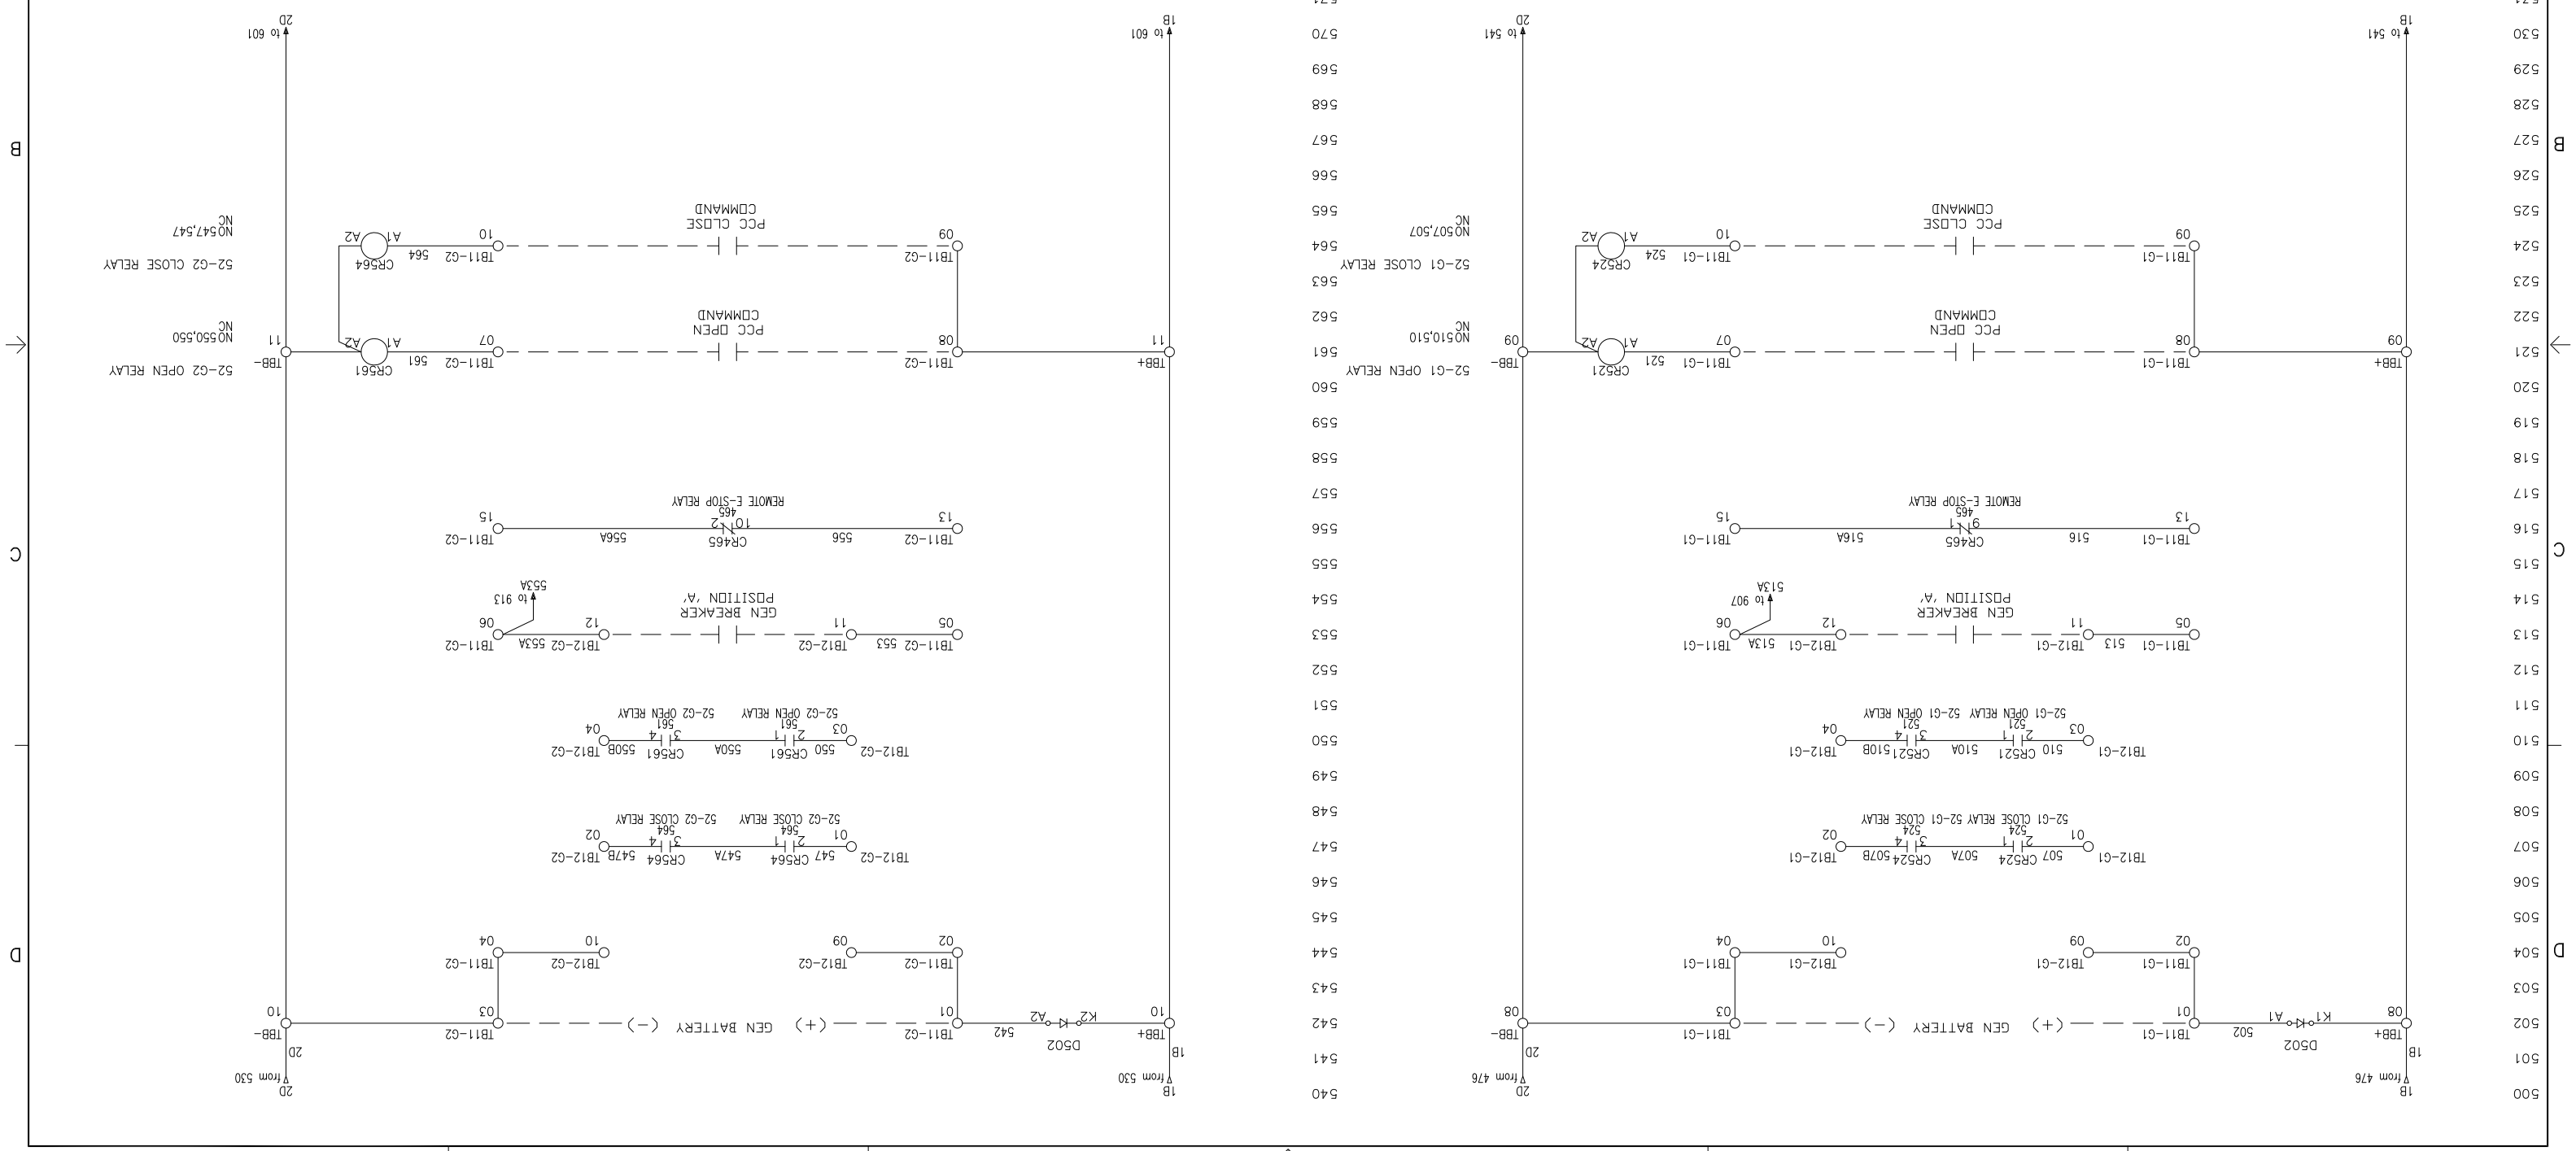

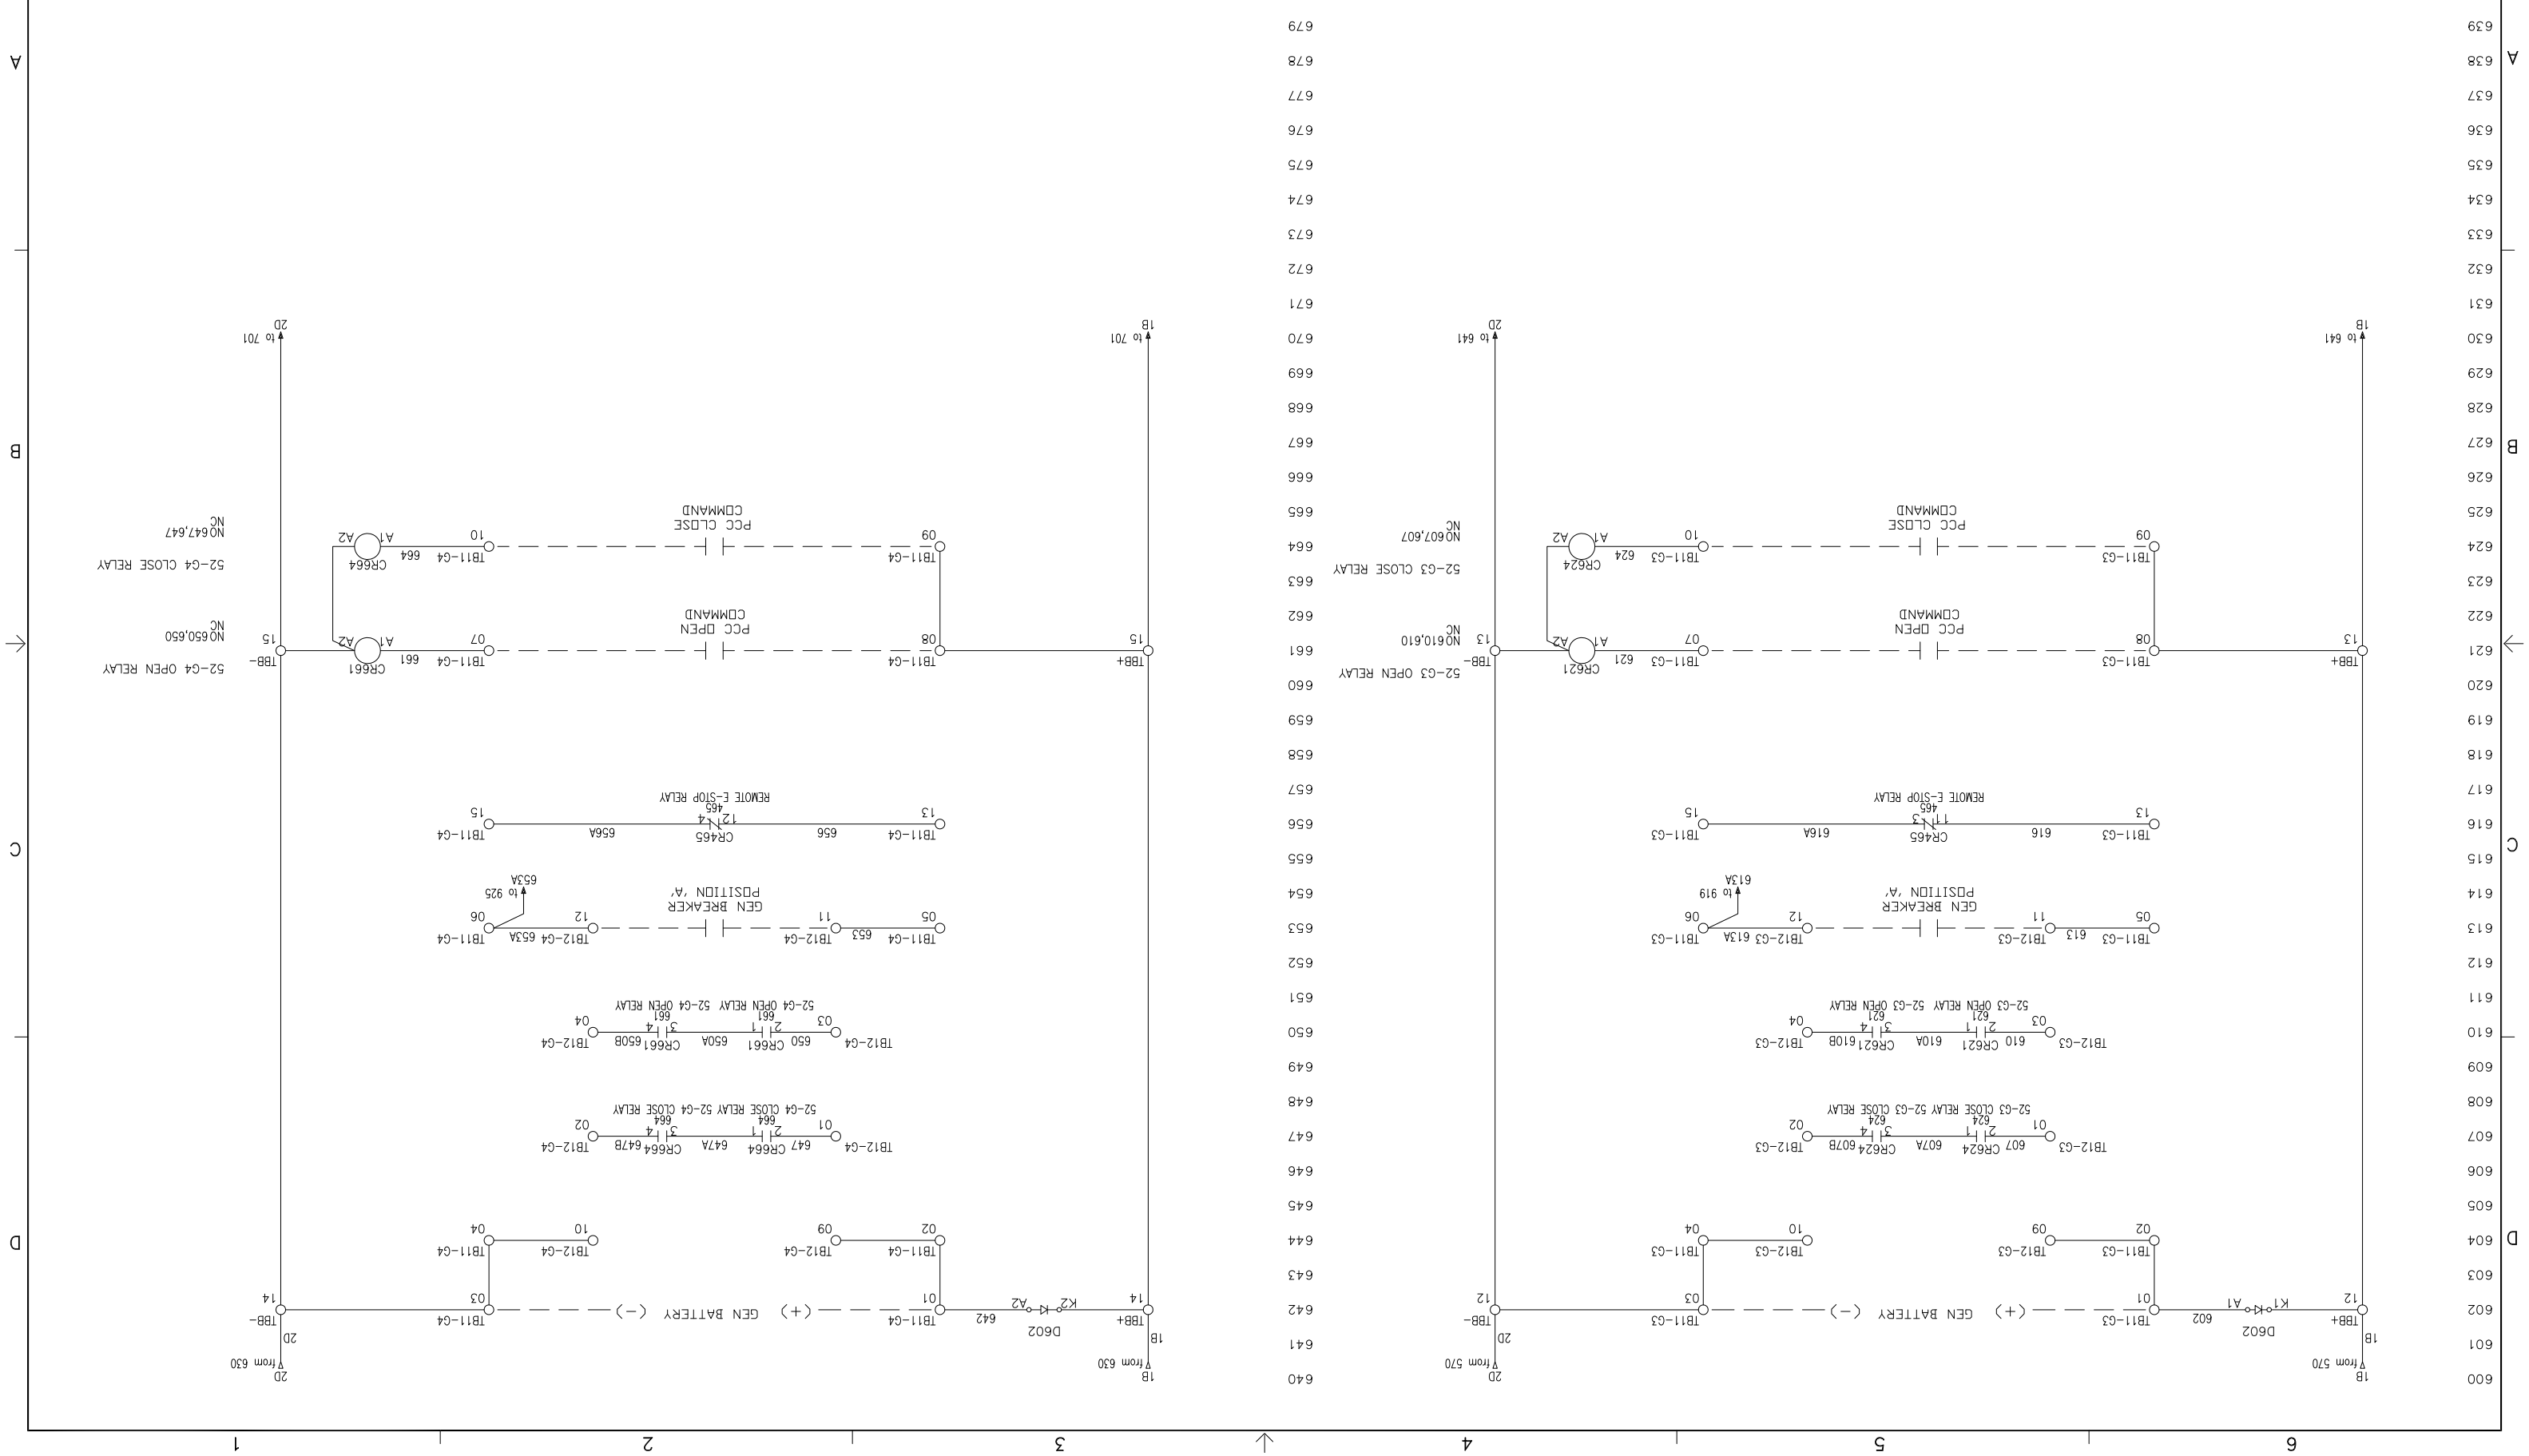

PC NO.	LTR	NO.	REVISION	ZONE	DRA	CHKR	APRV	DATE
PC104235	01	A	PRODUCTION RELEASE AS-BUILT	–	VS	VS	KT	06/17/10

PROJECT:
ARECIBO OBSERVATORY SWITCHGEAR
DMC GEN 3 & 4 MAIN CONTROL
CUMMINS CARIBBEAN
DISTRIBUTOR:
CUMMINS CARIBBEAN
707168I

AUTOCAD DWG

DO NOT SCALE PRINT

CUMMINS POWER GENERATION
1400 73rd AVE NE
MINNEAPOLIS, MN 55432

WD-SCHEMATISC

PART NO. | DWG SIZE | DESCRIPTION OF MATERIAL | REF DES

NAME | DATE
V. SAKLANI | 06/17/10
V. SIVAN | 06/17/10
APPROVED K.TWUMASI | 06/17/10

SITE CODE

PGA

PCLL2004R-77ZF

DWG NO. A030S865 | SHEET 6 of 61 | DWG SIZE D

PC NO.	LTR	NO.	REVISION	ZONE	DRA	CHKR	APRV	DATE
PC104235	01	A	PRODUCTION RELEASE AS-BUILT	–	VS	VS	KT	06/17/10

PROJECT:
ARECIBO OBSERVATORY SWITCHGEAR
BUS PT CONNECTION & PLC POWER
DISTRIBUTOR:
CUMMINS CARIBBEAN
707168I

AUTOCAD DWG

DO NOT SCALE PRINT

CUMMINS POWER GENERATION
1400 2nd AVE NE
MINNEAPOLIS, MN 55422

PART NO.	DWG SIZE	DESCRIPTION OF MATERIAL	REF DES

	NAME	DATE
DR	V.SAKLANI	06/17/10
CHKD MFG	V. SIVAN	06/17/10
APPROVED	K.TMUMASI	06/17/10

SITE CODE

TITLE
WD-SCHEMATISC

DWG NO. A030S865 SHEET 7 OF 61 DWG SIZE D

PGA

PCLL2004R-772F

MODEL FIRST USED ON

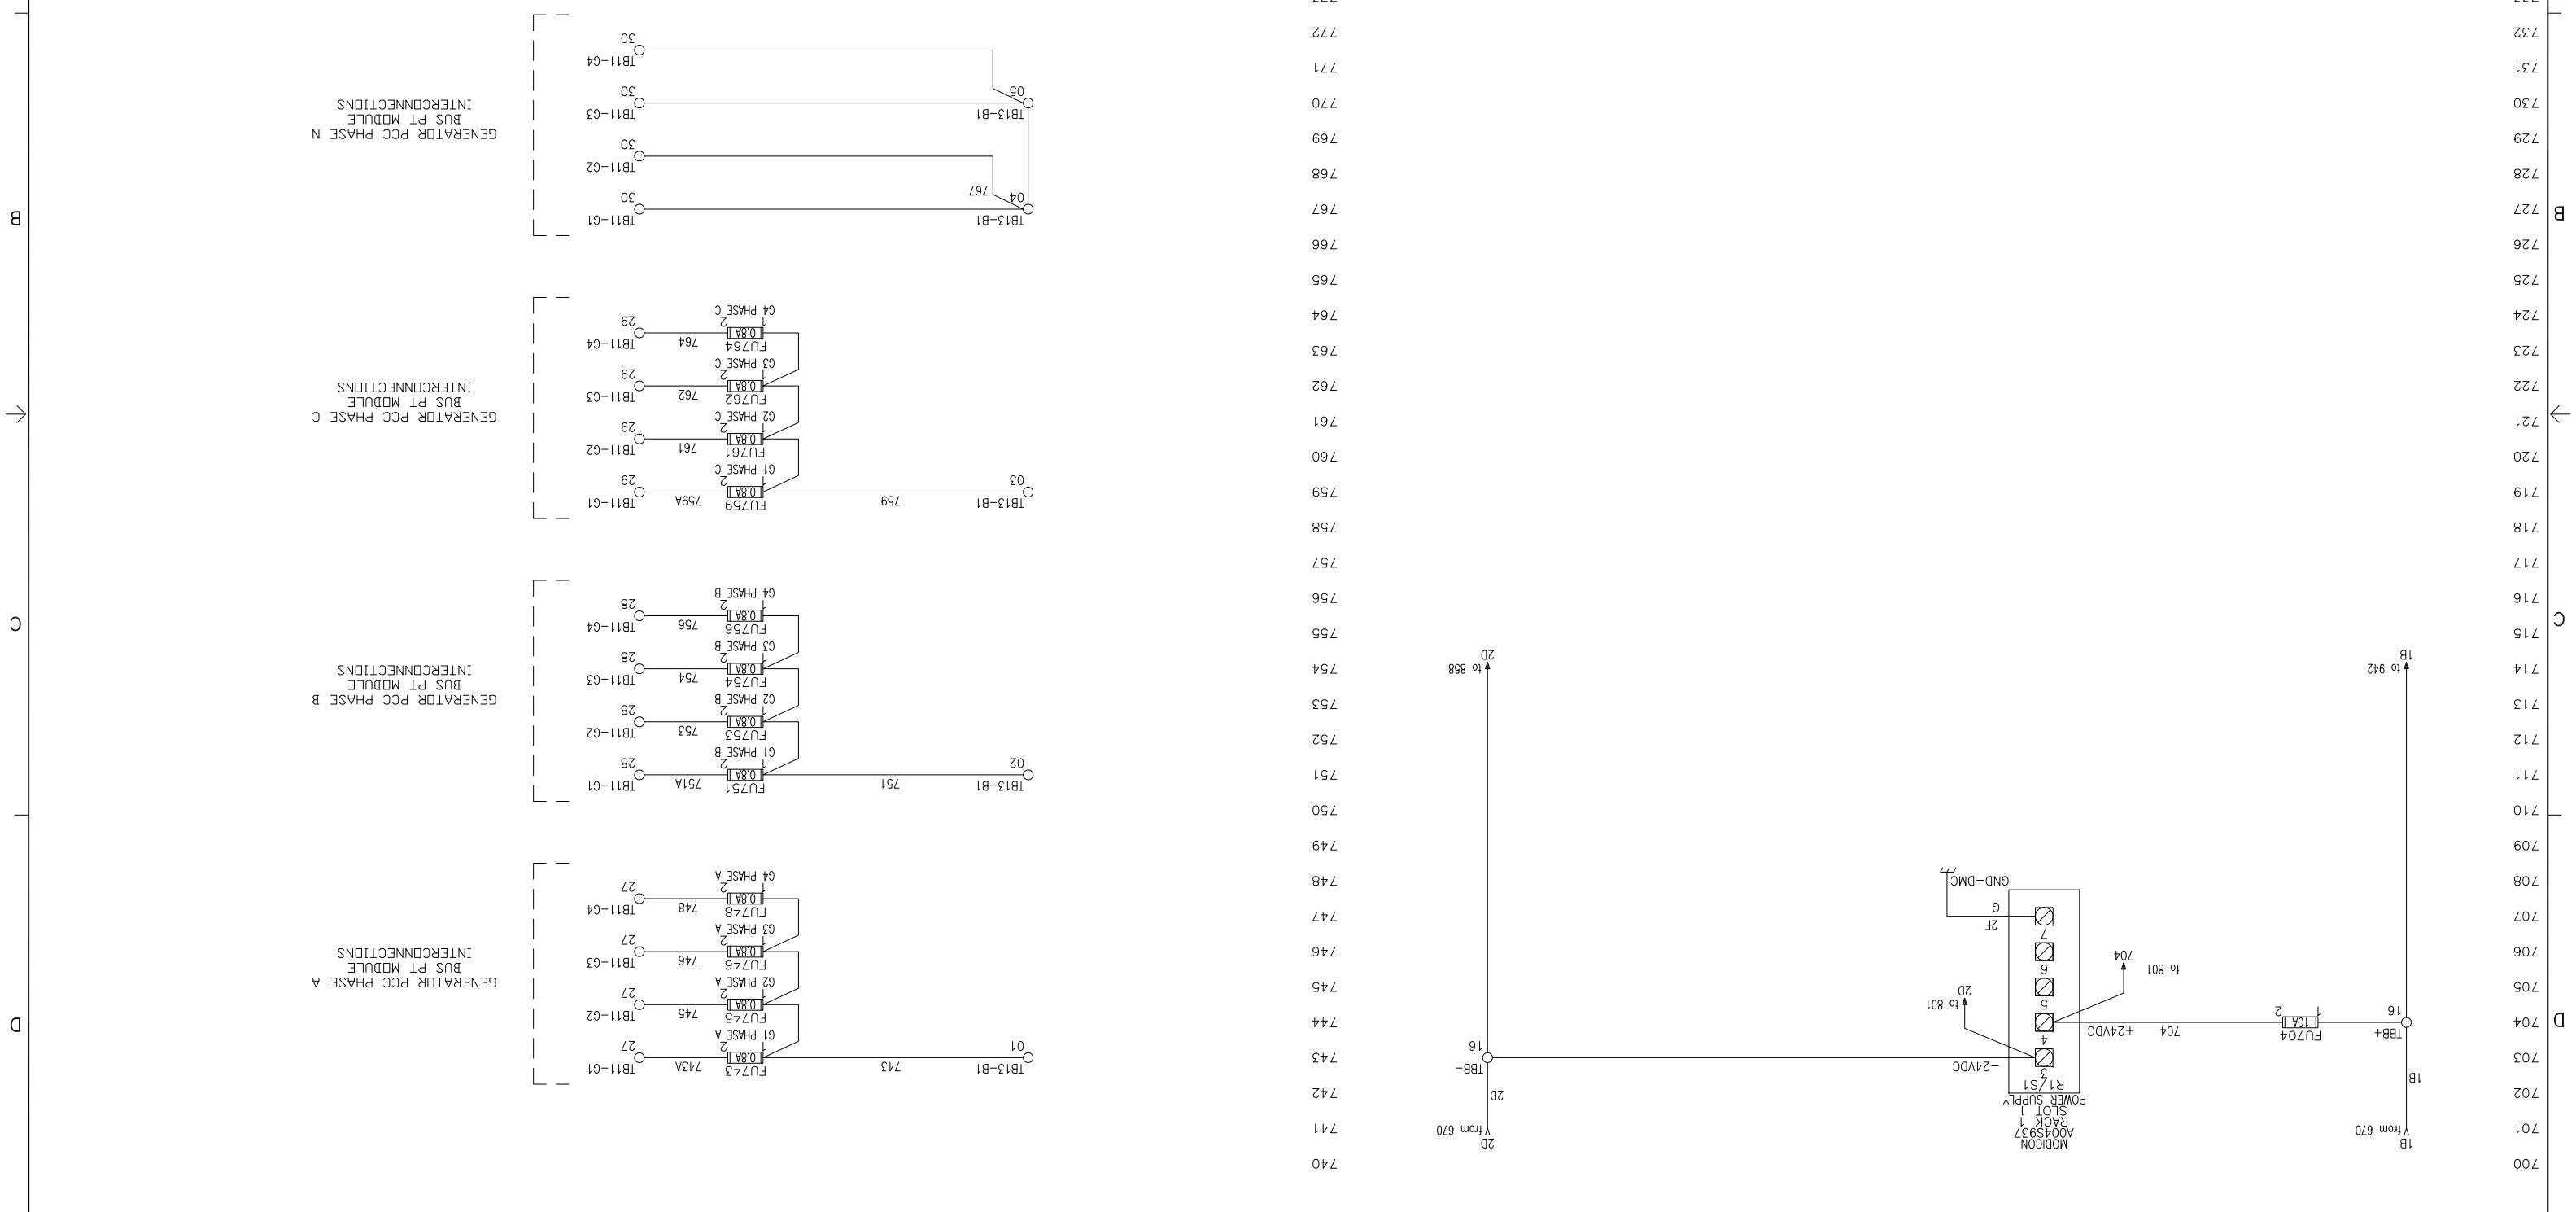

PC NO.	LTR	NO.	REVISION	ZONE	DRA	CHKR	APRV	DATE
PC104235	01	A	PRODUCTION RELEASE AS-BUILT	–	VS	VS	KT	06/17/10

PROJECT:
ARECIBO OBSERVATORY SWITCHGEAR
GENERATOR 1-4 PLC INPUTS
CUMMINS CARIBBEAN
DISTRIBUTOR:
707168I

AUTOCAD DWG

DO NOT SCALE PRINT

CUMMINS POWER GENERATION

WD-SCHEMATISC

PGA

PCLL2004R-772F

A0730S865

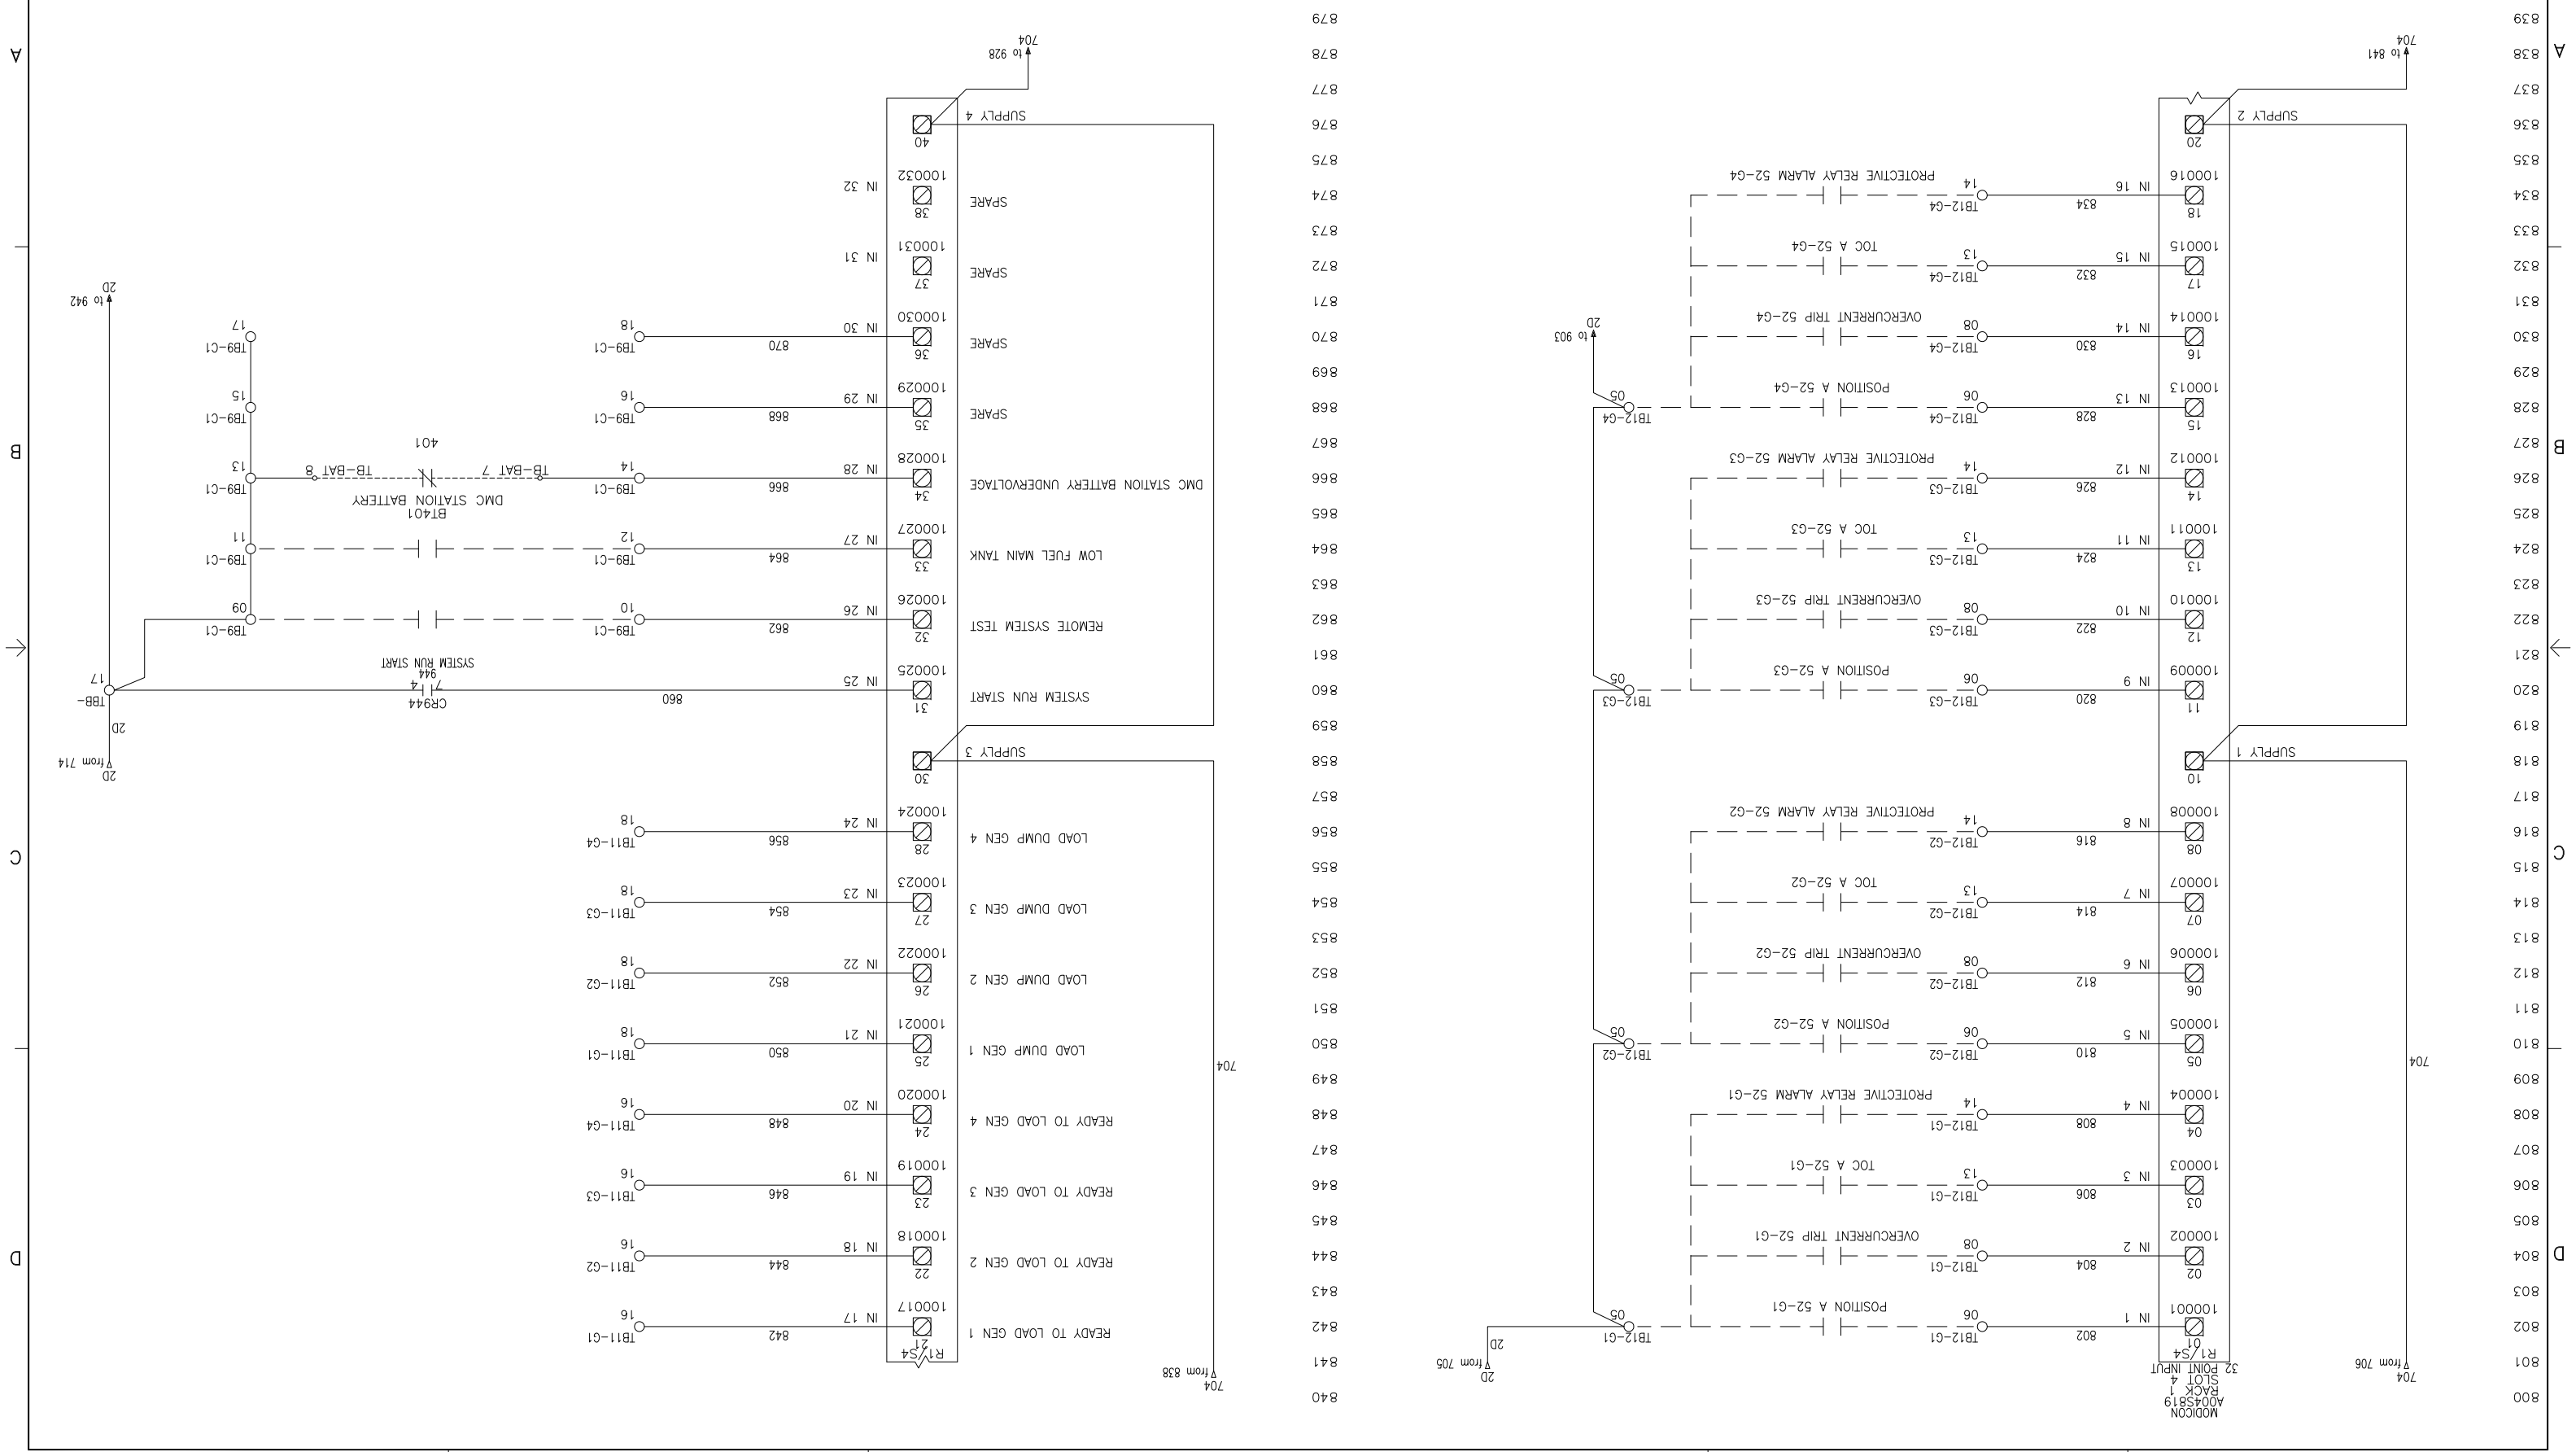

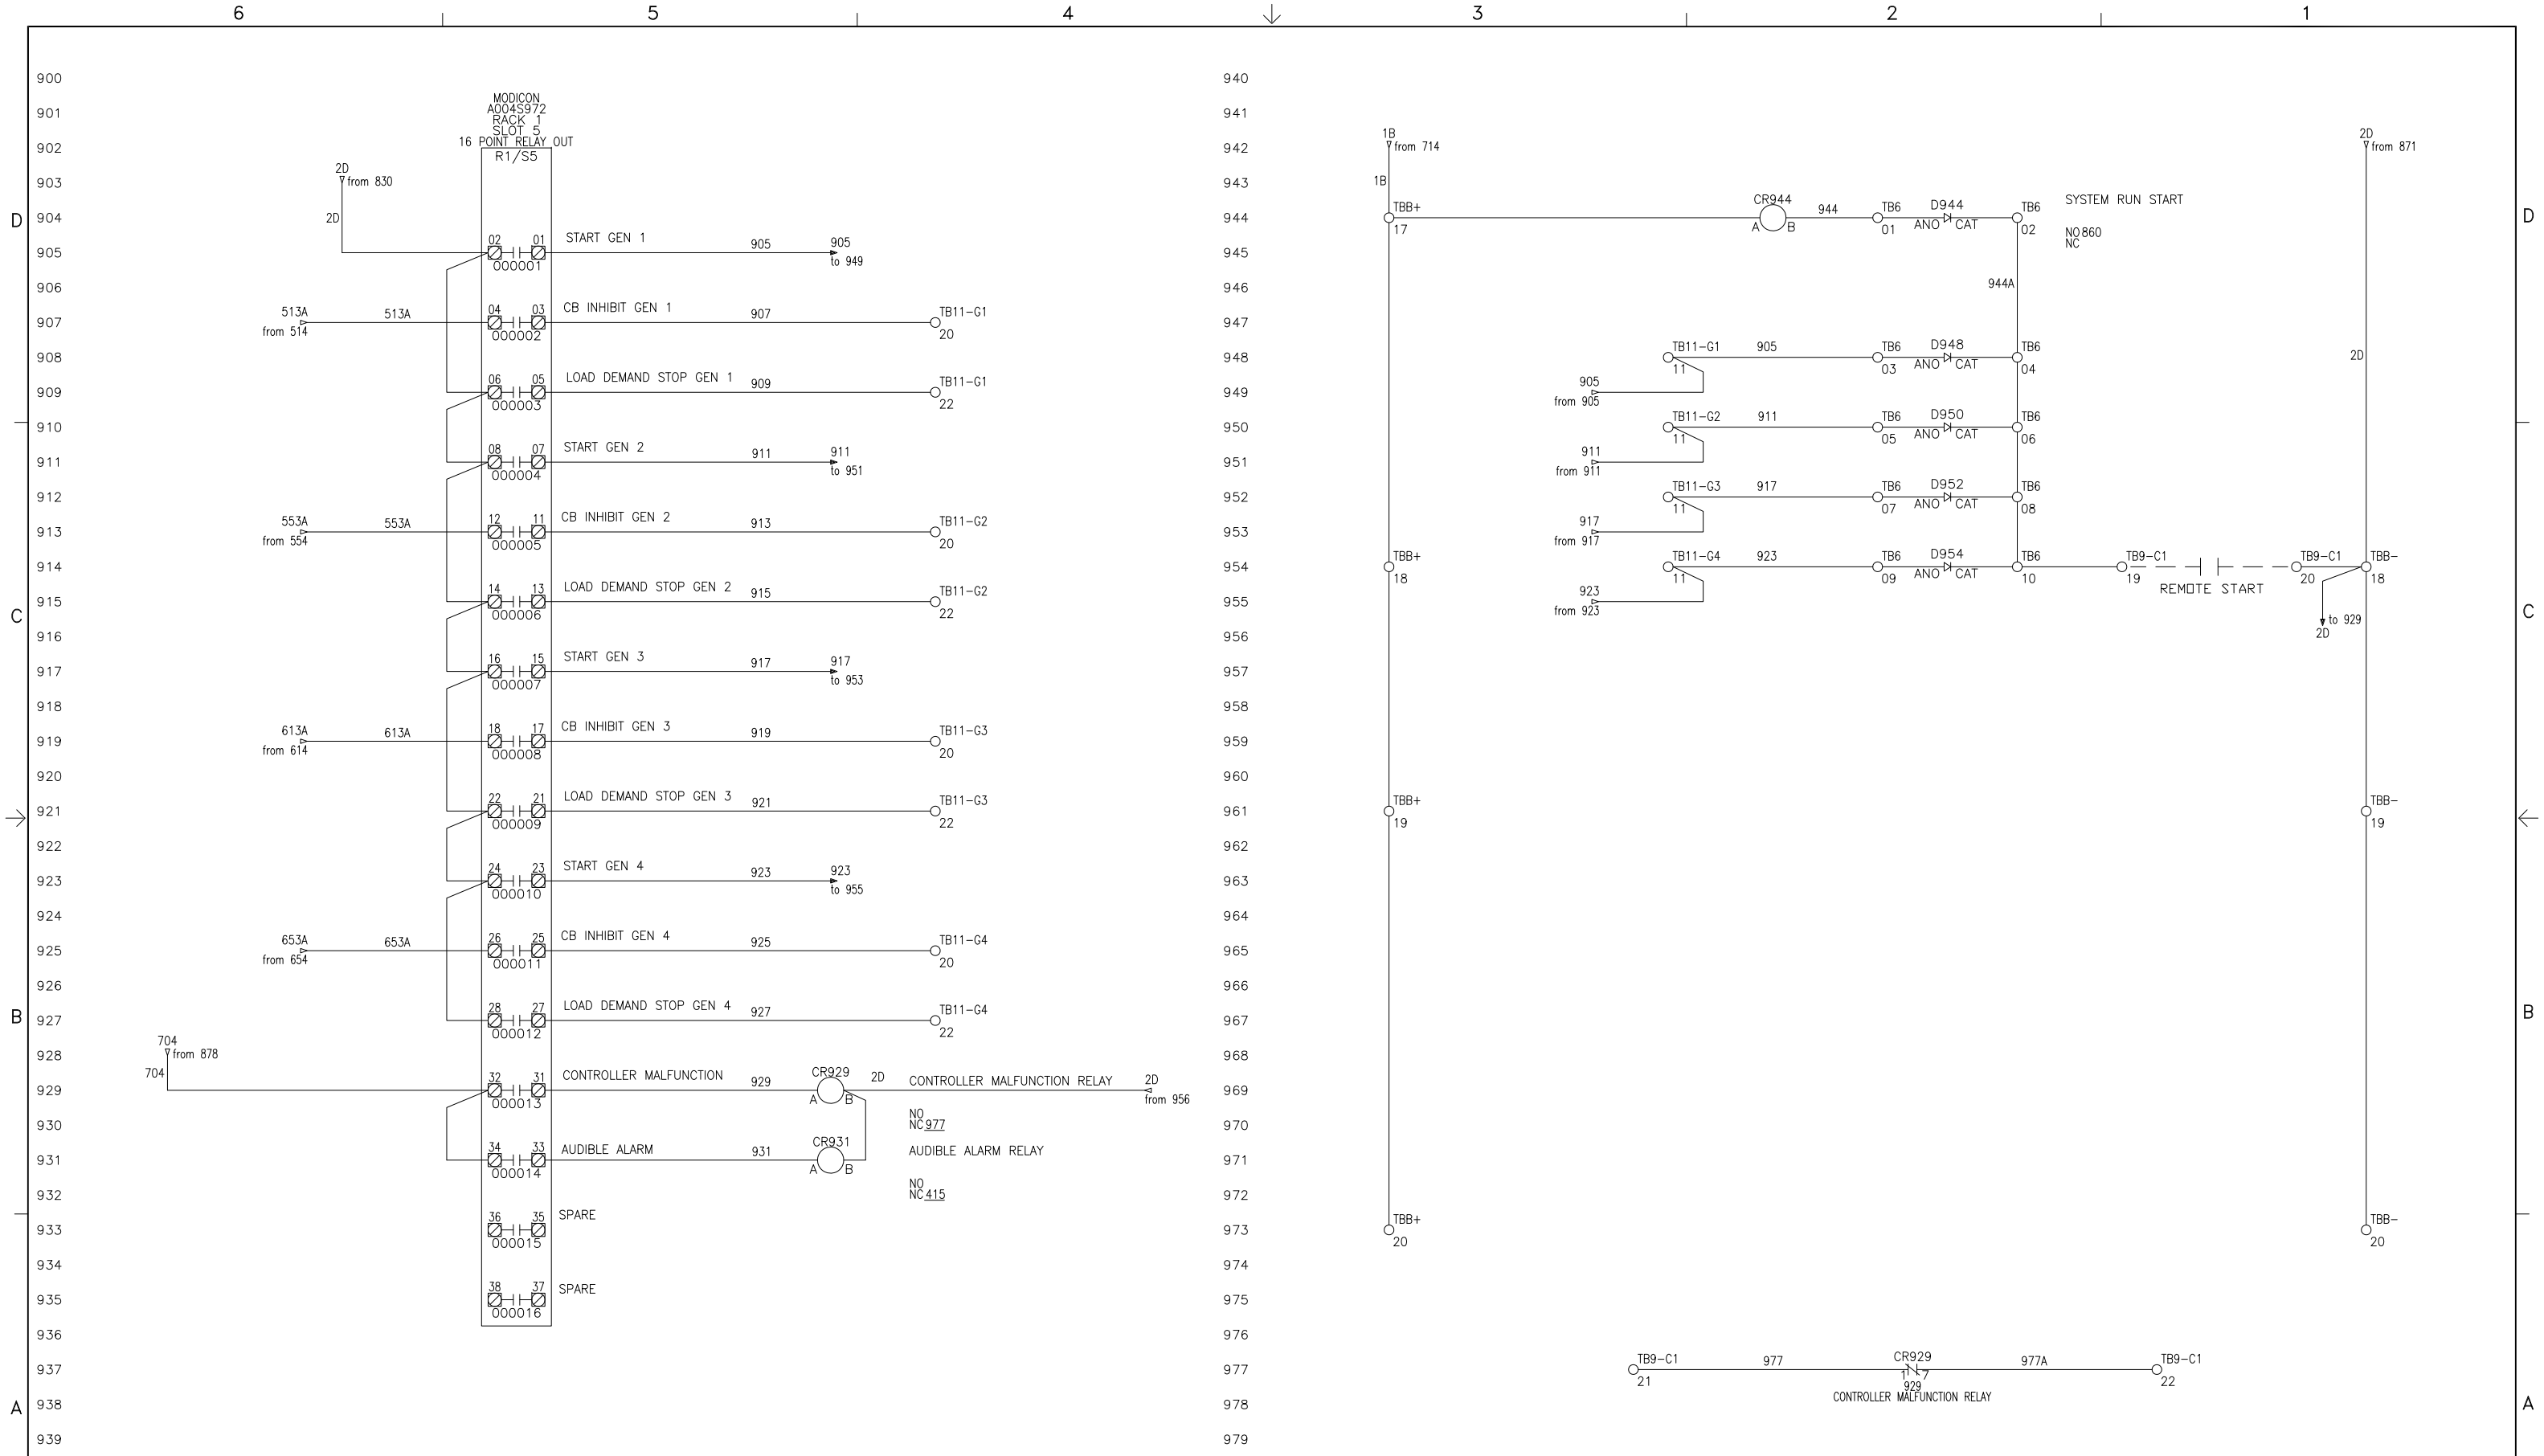

PC NO.	LTR	NO.	REVISION	ZONE	DRA	CHKR	APRV	DATE
PC104235	01	A	PRODUCTION RELEASE AS-BUILT	–	VS	VS	KT	06/17/10

PROJECT:
ARECIBO OBSERVATORY SWITCHGEAR
GENERATOR 1-4 PLC OUTPUTS
DISTRIBUTOR:
CUMMINS CARIBBEAN
7071681

DO NOT SCALE PRINT

ANG TOL | DRAWN TO SCALE OF

AUTOCAD DWG

SIM TO | COPIED FROM | THREE ANGLE PROJECTION

THIS DOCUMENT IS THE PROPERTY OF CUMMINS POWER GENERATION. IT CONTAINS PROPRIETARY AND CONFIDENTIAL INFORMATION WHICH MUST NOT BE DUPLICATED, USED OR DISCLOSED OTHER THAN EXPRESSLY AUTHORIZED BY CUMMINS POWER GENERATION OR ITS REPRESENTATIVE

PART NO.	DWG SIZE	DESCRIPTION OF MATERIAL	REF DES

	NAME	DATE
DR	V.SAKLANI	06/17/10
CHKR ☐ MFG ☐	V. SIVAN	06/17/10
APPROVED	K.TWUMASI	06/17/10

FOR INTERPRETATION OF DIMENSIONING AND TOLERANCING, SEE ANSI Y14.5M-1982

MODEL FIRST USED ON PCIL2004R-772F

SITE CODE PGA

CUMMINS POWER GENERATION
1400 73rd AVE. NE
MINNEAPOLIS, MN 55432

TITLE WD-SCHEMATISC

DWG NO. A030S865 | SHEET 9 of 61 | DWG SIZE D

PC NO.	LTR	NO.	REVISION	ZONE	DRA	CHKR	APRV	DATE
PC104235	01	A	PRODUCTION RELEASE AS-BUILT	–	VS	VS	KT	06/17/10

PROJECT:
ARECIBO OBSERVATORY SWITCHGEAR
DMC FEEDER 1-8 STATUS
CUMMINS CARIBBEAN
DISTRIBUTOR:
CUMMINS CARIBBEAN
707168I

ZONE	DRA	CHKR	APRV	DATE

PC NO.	LTR	NO.	REVISION	ZONE	DRA	CHKR	APRV	DATE

ANS TOL | DRAWN TO SCALE OF

DO NOT SCALE PRINT | SW 10 | CHKED TRGW

THESE MODE PRODUCTION

THIS DOCUMENT IS THE PROPERTY OF CUMMINS POWER GENERATION. IT CONTAINS PROPRIETARY AND CONFIDENTIAL INFORMATION WHICH MUST NOT BE DUPLICATED, USED OR DISCLOSED EITHER IN WHOLE OR IN PART WITHOUT THE WRITTEN PERMISSION OF CUMMINS POWER GENERATION OR ITS REPRESENTATIVE

AUTOCAD DWG

PART NO.	DWG SIZE	DESCRIPTION OF MATERIAL	REF DES

	NAME	DATE
DR	V.SAKLANI	06/17/10
Chkd MFG	V. SIVAN	06/17/10
	APPROVED K.TMUMASI	06/17/10

CUMMINS POWER GENERATION
1400 73rd AVE NE
MINNEAPOLIS, MN 55432

TITLE
WD-SCHEMATISC

SITE CODE

PGA

PCLL2004R-772F

MODEL FIRST USED ON

FOR INTERPRETATION OF DIMENSIONS AND TOLERANCES SEE ANSI Y14.5M-1982

DWG NO. A030S865 | SHEET 10 of 61 | DWG SIZE D

MODICON
A0043732
MB+
ADDRESS 4
32 POINT INPUT

(R1) 01 IO4

1	IN	1002	TB27-S1 11	1004	TB27-S1 12	(R1) 02 10019 4
2	IN	1004	TB27-S1 12	1006	TB27-S1 13	(R1) 03 10019 5
3	IN	1006	TB27-S1 13	1008	TB27-S1 14	(R1) 04 10019 6
4	IN	1008	TB27-S1 14	1010	TB27-S1 15	(R1) 05 10019 7
5	IN	1010	TB27-S1 15	1012	TB27-S1 16	(R1) 06 10019 8
6	IN	1012	TB27-S1 16	1014	TB27-S1 17	(R1) 07 10019 9
7	IN	1014	TB27-S1 17	1016	TB27-S1 18	(R1) 08 10020 0
8	IN	1016	TB27-S1 18	1018	TB27-S1 19	(R1) 09 10020 1
9	IN	1018	TB27-S1 19	1020	TB27-S1 20	(R1) 10 10020 2
10	IN	1020	TB27-S1 20	1022	TB27-S1 21	(R1) 11 10020 3
11	IN	1022	TB27-S1 21	1024	TB27-S1 22	(R1) 12 10020 4
12	IN	1024	TB27-S1 22	1026	TB27-S1 23	(R1) 13 10020 5
13	IN	1026	TB27-S1 23	1028	TB27-S1 24	(R1) 14 10020 6
14	IN	1028	TB27-S1 24	1030	TB27-S1 25	(R1) 15 10020 7
15	IN	1030	TB27-S1 25	1032	TB27-S1 26	(R1) 16 10020 8
16	IN	1032	TB27-S1 26	442	to 1041	
17	2D	442	TB27-S1 2	44	TB27-S1 2D	from 442 M–
18	L+					

1	IN	1042	TB27-S1 27	1044	TB27-S1 28	(R2) 01 10020 9
2	IN	1044	TB27-S1 28	1046	TB27-S1 29	(R2) 02 10021 0
3	IN	1046	TB27-S1 29	1048	TB27-S1 30	(R2) 03 10021 1
4	IN	1048	TB27-S1 30	1050	TB27-S1 31	(R2) 04 10021 2
5	IN	1050	TB27-S1 31	1052	TB27-S1 32	(R2) 05 10021 3
6	IN	1052	TB27-S1 32	1054	TB27-S1 33	(R2) 06 10021 4
7	IN	1054	TB27-S1 33	1056	TB27-S1 34	(R2) 07 10021 5
8	IN	1056	TB27-S1 34	1058	TB27-S1 35	(R2) 08 10021 6
9	IN	1058	TB27-S1 35	1060	TB27-S1 36	(R2) 09 10021 7
10	IN	1060	TB27-S1 36	1062	TB27-S1 37	(R2) 10 10021 8
11	IN	1062	TB27-S1 37	1064	TB27-S1 38	(R2) 11 10021 9
12	IN	1064	TB27-S1 38	1066	TB27-S1 39	(R2) 12 10022 0
13	IN	1066	TB27-S1 39	1068	TB27-S1 40	(R2) 13 10022 1
14	IN	1068	TB27-S1 40	1070	TB27-S1 41	(R2) 14 10022 2
15	IN	1070	TB27-S1 41	1072	TB27-S1 42	(R2) 15 10022 3
16	IN	1072	TB27-S1 42	442	from 1033	
17	1L+					
18	2L+					




IO4

POSITION A 52-F1A	(R1) 01 10019 3
OVERCURRENT TRIP 52-F1A	(R1) 02 10019 4
TOC A 52-F1A	(R1) 03 10019 5
GROUND FAULT 52-F1A	(R1) 04 10019 6
POSITION A 52-F2	(R1) 05 10019 7
OVERCURRENT TRIP 52-F2	(R1) 06 10019 8
TOC A 52-F2	(R1) 07 10019 9
GROUND FAULT 52-F2	(R1) 08 10020 0
POSITION A 52-F3	(R1) 09 10020 1
OVERCURRENT TRIP 52-F3	(R1) 10 10020 2
TOC A 52-F3	(R1) 11 10020 3
GROUND FAULT 52-F3	(R1) 12 10020 4
POSITION A 52-F4	(R1) 13 10020 5
OVERCURRENT TRIP 52-F4	(R1) 14 10020 6
TOC A 52-F4	(R1) 15 10020 7
GROUND FAULT 52-F4	(R1) 16 10020 8

POSITION A 52-F5	(R2) 01 10020 9
OVERCURRENT TRIP 52-F5	(R2) 02 10021 0
TOC A 52-F5	(R2) 03 10021 1
GROUND FAULT 52-F5	(R2) 04 10021 2
POSITION A 52-F6	(R2) 05 10021 3
OVERCURRENT TRIP 52-F6	(R2) 06 10021 4
TOC A 52-F6	(R2) 07 10021 5
GROUND FAULT 52-F6	(R2) 08 10021 6
POSITION A 52-F7	(R2) 09 10021 7
OVERCURRENT TRIP 52-F7	(R2) 10 10021 8
TOC A 52-F7	(R2) 11 10021 9
GROUND FAULT 52-F7	(R2) 12 10022 0
POSITION A 52-F8	(R2) 13 10022 1
OVERCURRENT TRIP 52-F8	(R2) 14 10022 2
TOC A 52-F8	(R2) 15 10022 3
GROUND FAULT 52-F8	(R2) 16 10022 4

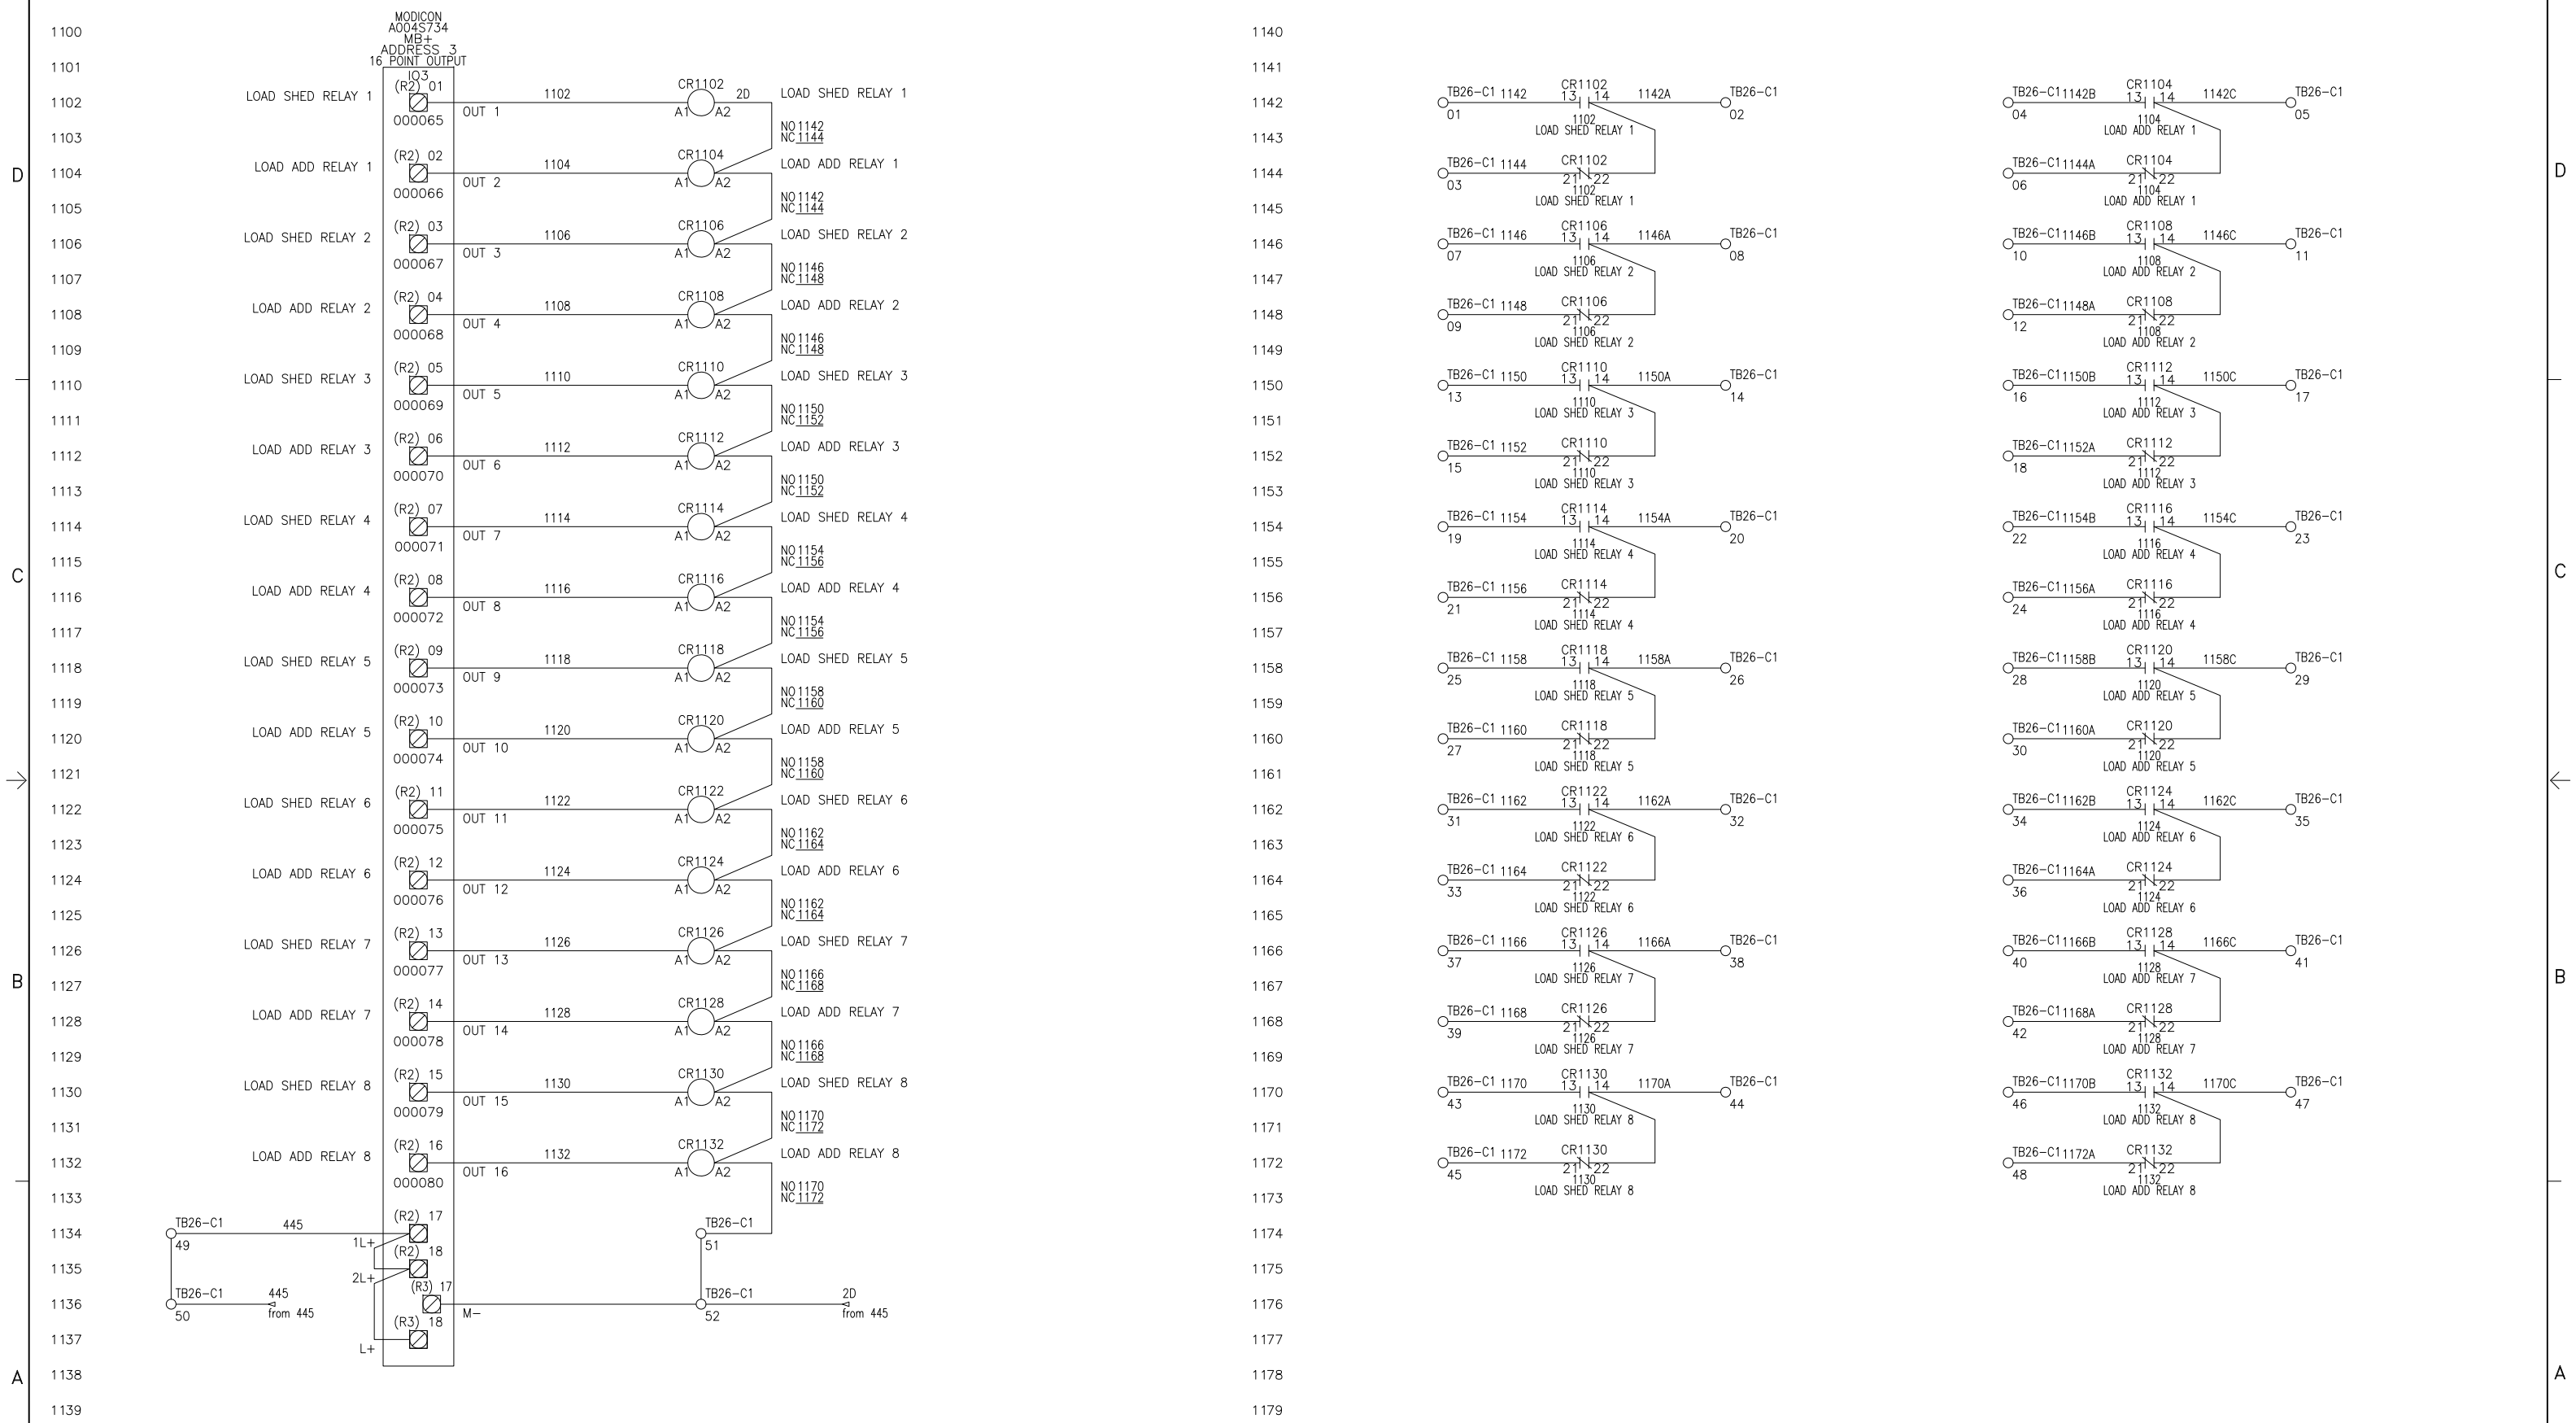

PC NO.	LTR	NO.	REVISION	ZONE	DRA	CHKR	APRV	DATE
PC104235	01	A	PRODUCTION RELEASE AS-BUILT	–	VS	VS	KT	06/17/10

PROJECT:
ARECIBO OBSERVATORY SWITCHGEAR
DMC FEEDER 1-8 LALS
DISTRIBUTOR:
CUMMINS CARIBBEAN
7071681

DO NOT SCALE PRINT

AUTOCAD DWG

SIM TO
COPIED FROM
THREE ANGLE PROJECTION
ANG TOL
DRAWN TO SCALE OF

THIS DOCUMENT IS THE PROPERTY OF CUMMINS POWER GENERATION. IT CONTAINS PROPRIETARY AND CONFIDENTIAL INFORMATION WHICH MUST NOT BE DUPLICATED, USED OR DISCLOSED OTHER THAN EXPRESSLY AUTHORIZED BY CUMMINS POWER GENERATION OR ITS REPRESENTATIVE

PART NO.	DWG SIZE	DESCRIPTION OF MATERIAL	REF DES

	NAME	DATE
DR	V.SAKLANI	06/17/10
CHKR / MFG	V. SIVAN	06/17/10
APPROVED	K.TWUMASI	06/17/10

FOR INTERPRETATION OF DIMENSIONING AND TOLERANCING, SEE ANSI Y14.5M-1982

MODEL FIRST USED ON PCIL2004R-772F

SITE CODE PGA

CUMMINS POWER GENERATION
1400 73rd AVE. NE
MINNEAPOLIS, MN 55432

TITLE WD-SCHEMATISC

DWG NO. A030S865

SHEET 11 OF 61

DWG SIZE D

PC NO.	LTR	NO.	REVISION	ZONE	DRA	CHKR	APRV	DATE
PC104235	01	A	PRODUCTION RELEASE AS-BUILT	–	VS	VS	KT	06/17/10

PROJECT:
ARCGBO OBSERVATORY SWITCHGEAR
SYSTEM AC METERING INPUT
DISTRIBUTOR:
CUMMINS CARIBBEAN
707168I

DO NOT SCALE PRINT		
SW 10	NAME	DATE
CHKD	V.SAKLANI	06/17/10
PROJ	V. SIVAN	06/17/10
MFG	APPROVED TM.TMJVMASI	06/17/10

AUTOCAD DWG

PART NO. | DWG SIZE | DESCRIPTION OF MATERIAL | REF DES

CUMMINS POWER GENERATION
1400 73rd AVE NE
MINNEAPOLIS, MN 55432

TITLE
WD-SCHEMATISC

SITE CODE

PGA

PCL200AR-772F

DWG NO. A030S865 | SHEET 12 OF 61 | DWG SIZE D

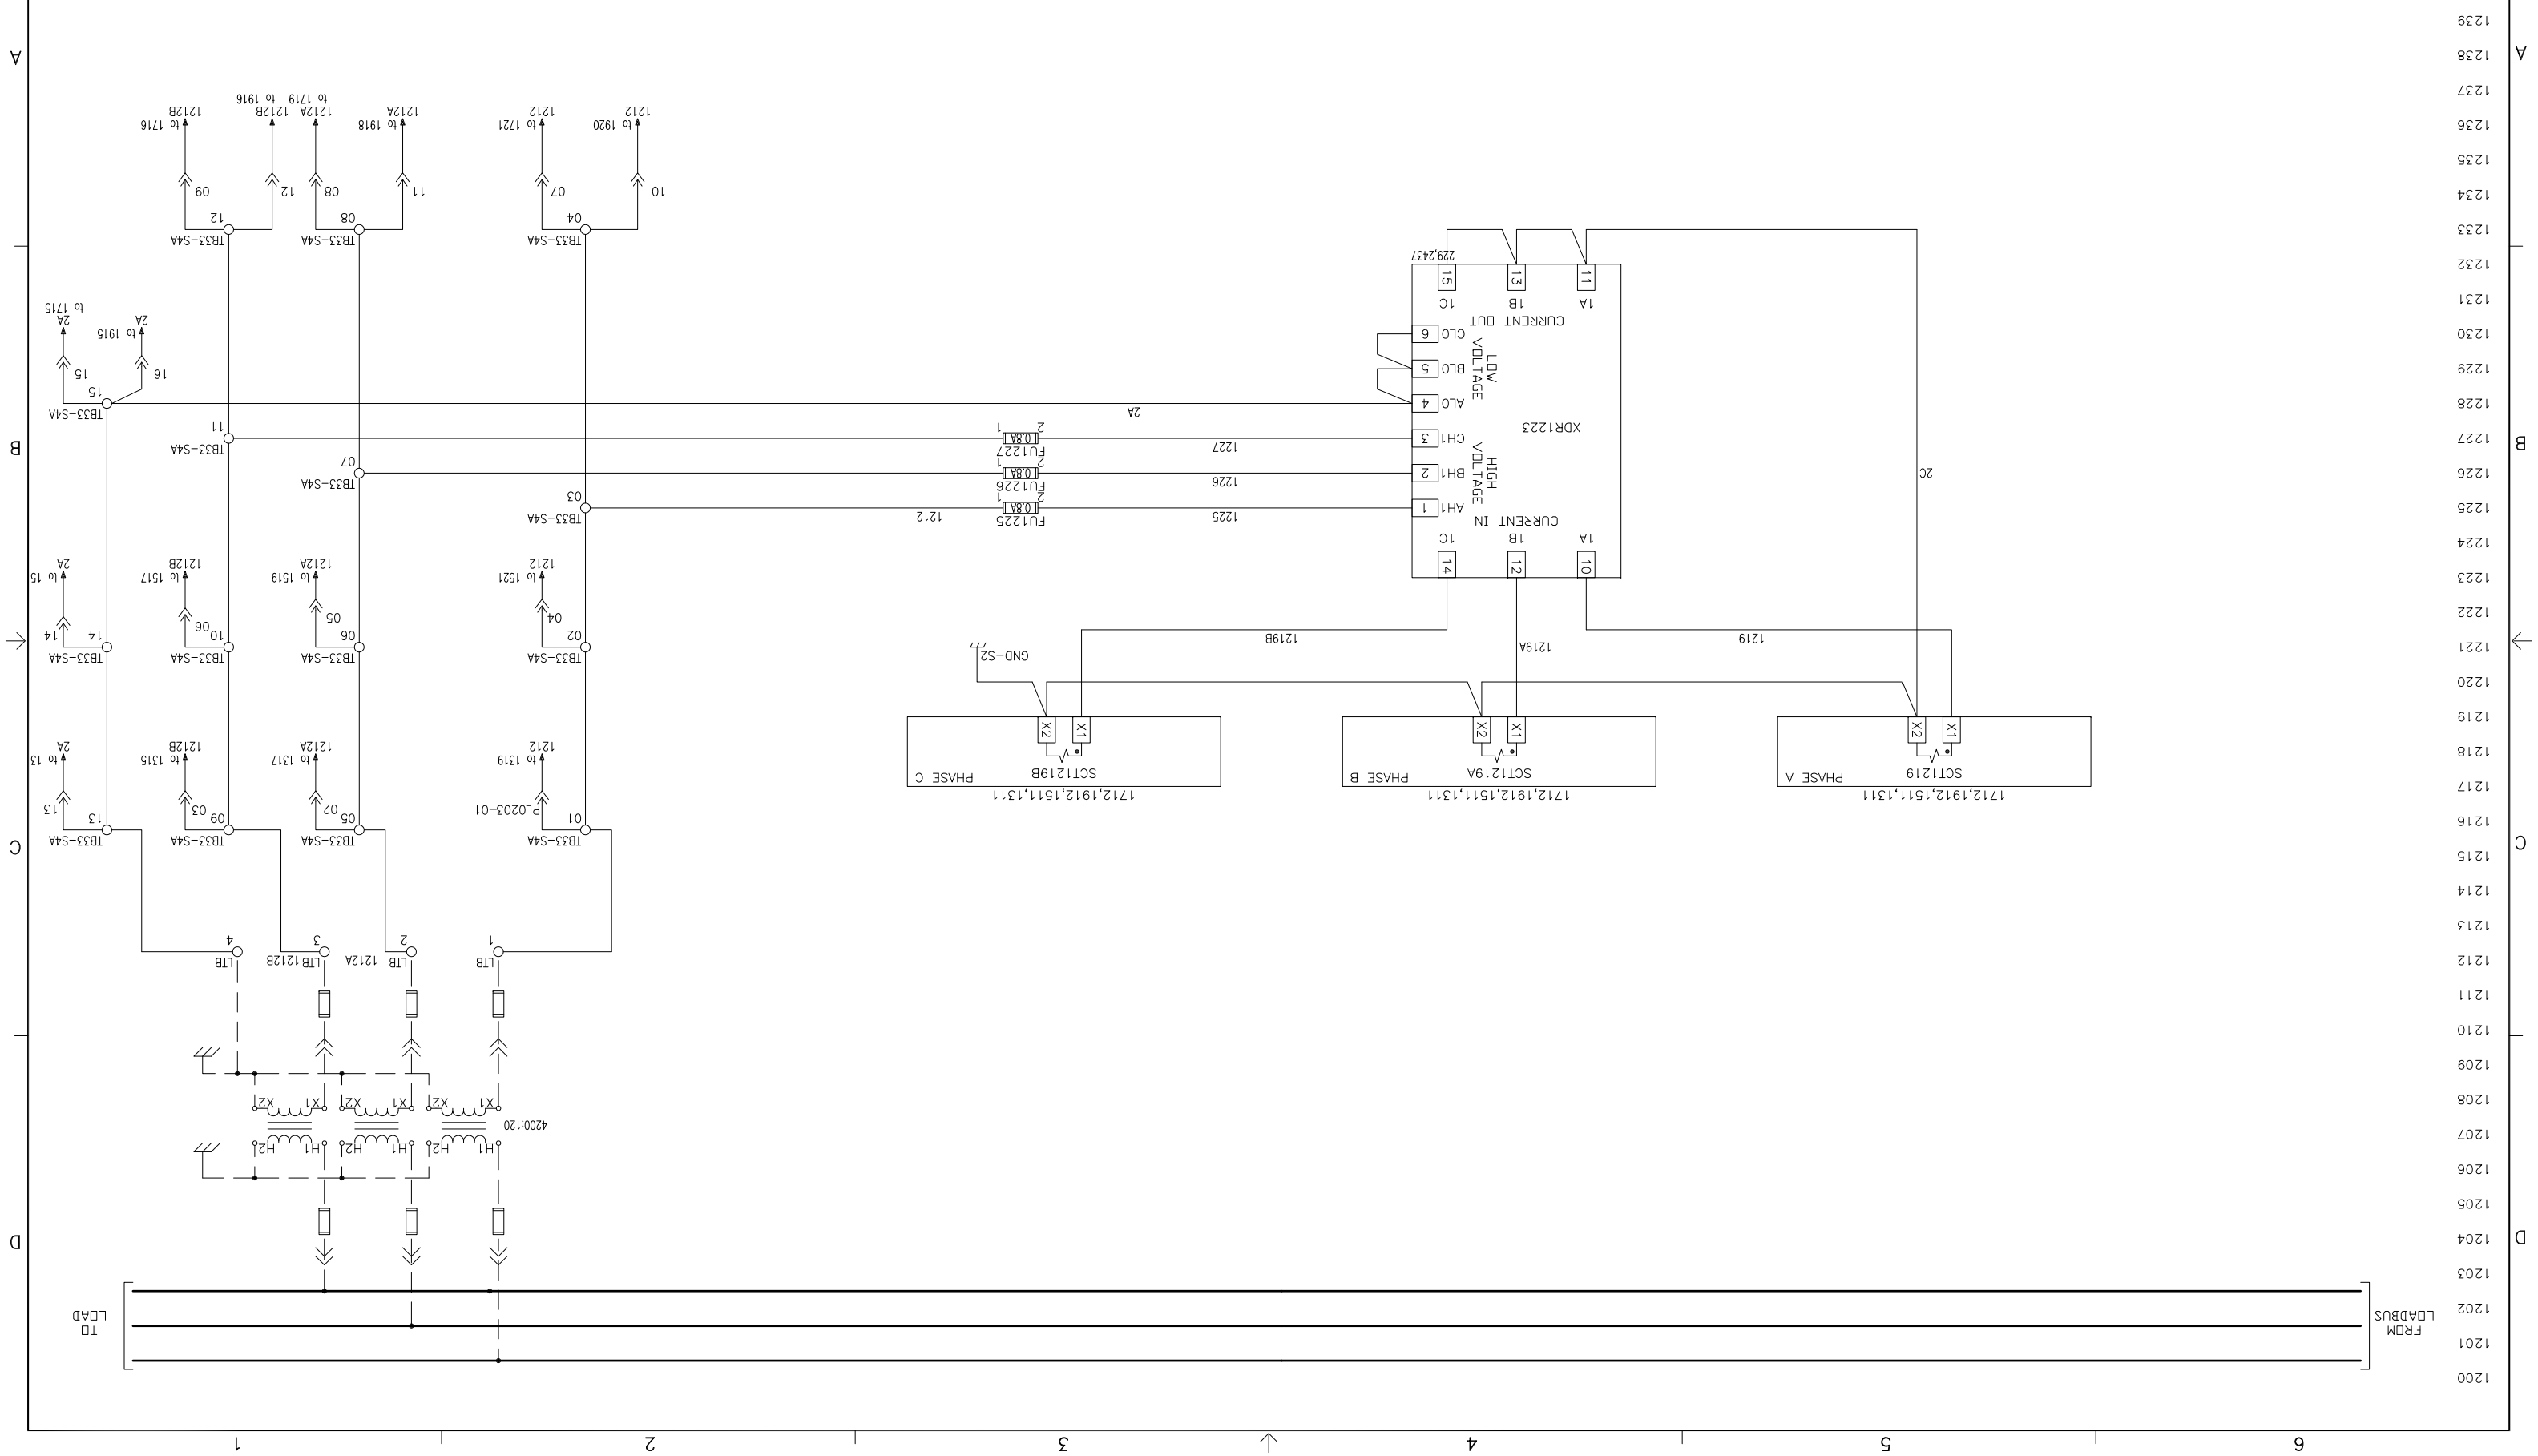

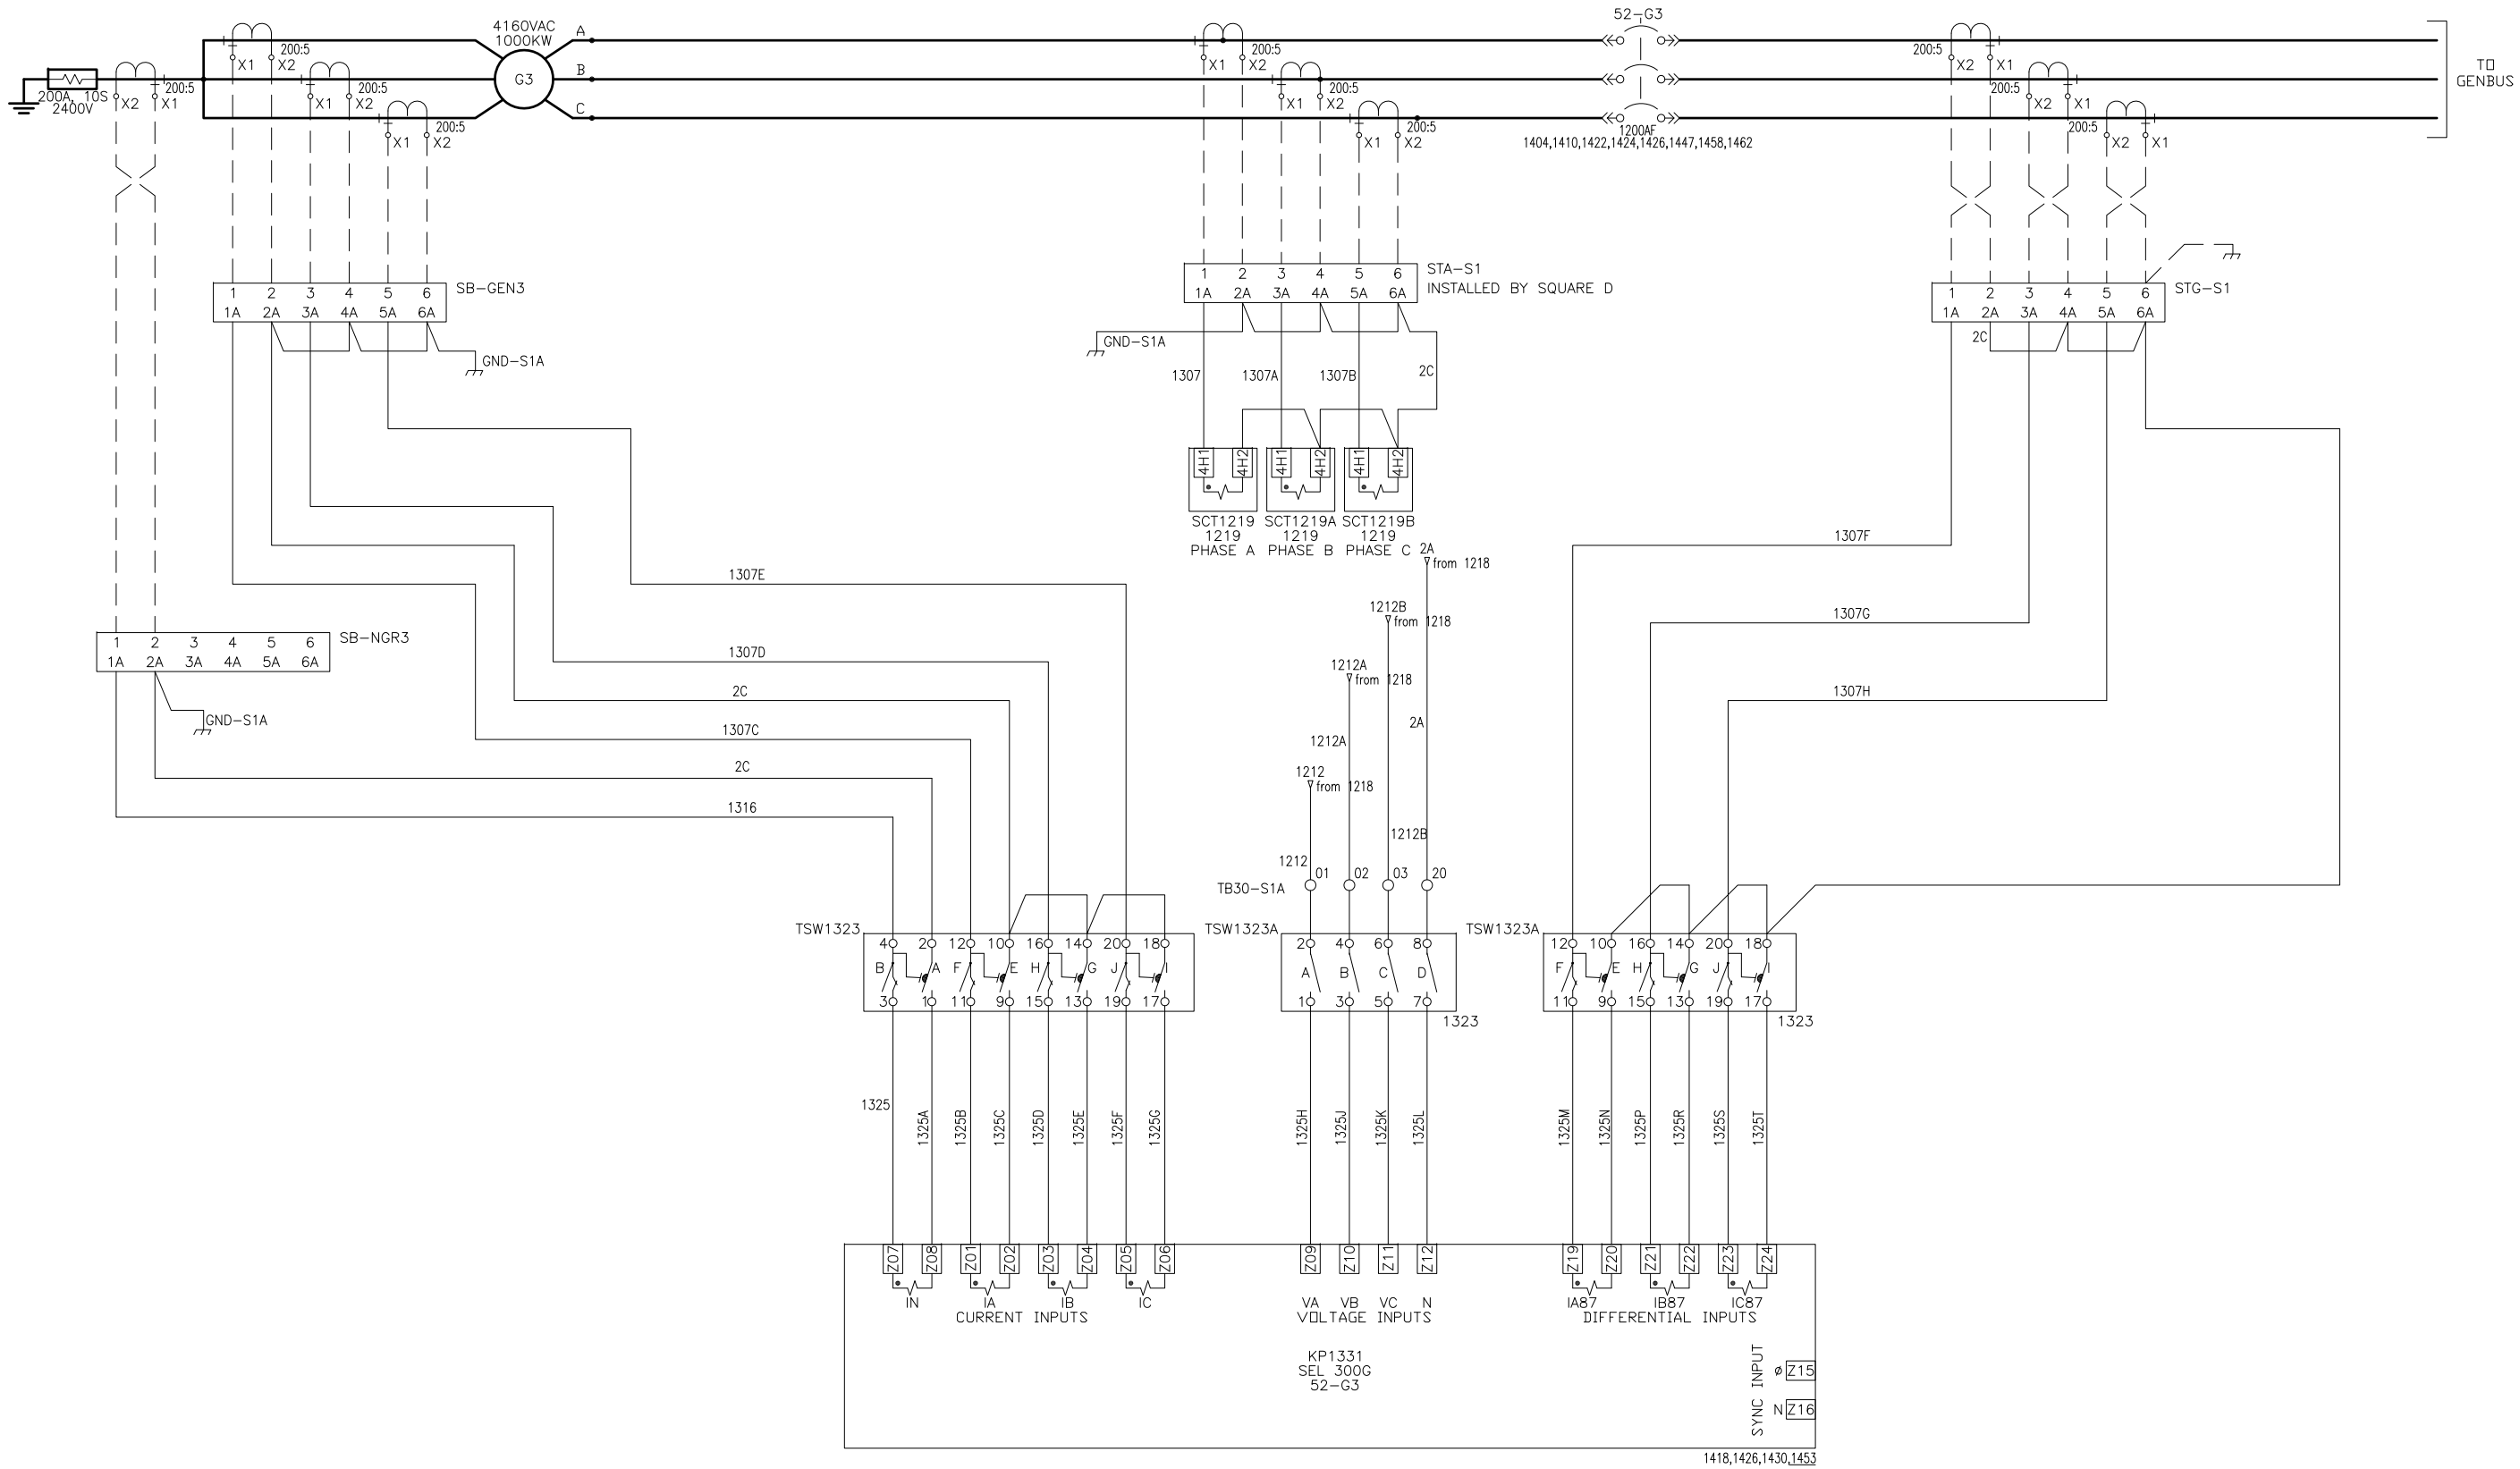

PC NO.	LTR	NO.	REVISION	ZONE	DRA	CHKR	APRV	DATE
PC104235	01	A	PRODUCTION RELEASE AS-BUILT	–	VS	VS	KT	06/17/10

PROJECT:
ARECIBO OBSERVATORY SWITCHGEAR
SG 52-G3 AC SCHEMATICS
DISTRIBUTOR:
CUMMINS CARIBBEAN
7071681

DO NOT SCALE PRINT

ANG TOL | DRAWN TO SCALE OF

AUTOCAD DWG

SIM TO | COPIED FROM | THREE ANGLE PROJECTION

THIS DOCUMENT IS THE PROPERTY OF CUMMINS POWER GENERATION. IT CONTAINS PROPRIETARY AND CONFIDENTIAL INFORMATION WHICH MUST NOT BE DUPLICATED, USED OR DISCLOSED OTHER THAN EXPRESSLY AUTHORIZED BY CUMMINS POWER GENERATION OR ITS REPRESENTATIVE

PART NO.	DWG SIZE	DESCRIPTION OF MATERIAL	REF DES

	NAME	DATE
DR	V.SAKLANI	06/17/10
CHKR / MFG	V. SIVAN	06/17/10
APPROVED	K.TWUMASI	06/17/10

FOR INTERPRETATION OF DIMENSIONING AND TOLERANCING, SEE ANSI Y14.5M-1982

MODEL FIRST USED ON: PCIL2004R-772F

SITE CODE: PGA

CUMMINS POWER GENERATION
1400 73rd AVE NE
MINNEAPOLIS, MN 55432

TITLE: WD-SCHEMATISC

DWG NO. A030S865 | SHEET 13 OF 61 | DWG SIZE D

PROJECT:
ARECIBO OBSERVATORY SWITCHGEAR
SG 52-G3 DC SCHEMATICS
CUMMINS CARIBBEAN
DISTRIBUTOR:
CUMMINS CARIBBEAN
707168I

PC NO.	LTR	NO.	REVISION	ZONE	DRA	CHKR	APRV	DATE
PC104235	01	A	PRODUCTION RELEASE AS-BUILT	–	VS	VS	KT	06/17/10

DO NOT SCALE PRINT

		NAME	DATE
DRAWN		V.SAKLANI	06/17/10
CHKD		V. SIVAN	06/17/10
APPROVED		K.TMUMASI	06/17/10

AUTOCAD DWG

PART NO. | DWG SIZE | DESCRIPTION OF MATERIAL | REF DES

CUMMINS POWER GENERATION
1400 73rd AVE NE
MINNEAPOLIS, MN 55432

SITE CODE

TITLE
WD-SCHEMATISC

DWG NO. A030S865 | SHEET 14 of 61 | DWG SIZE D

PGA

PCLL200AR-772F

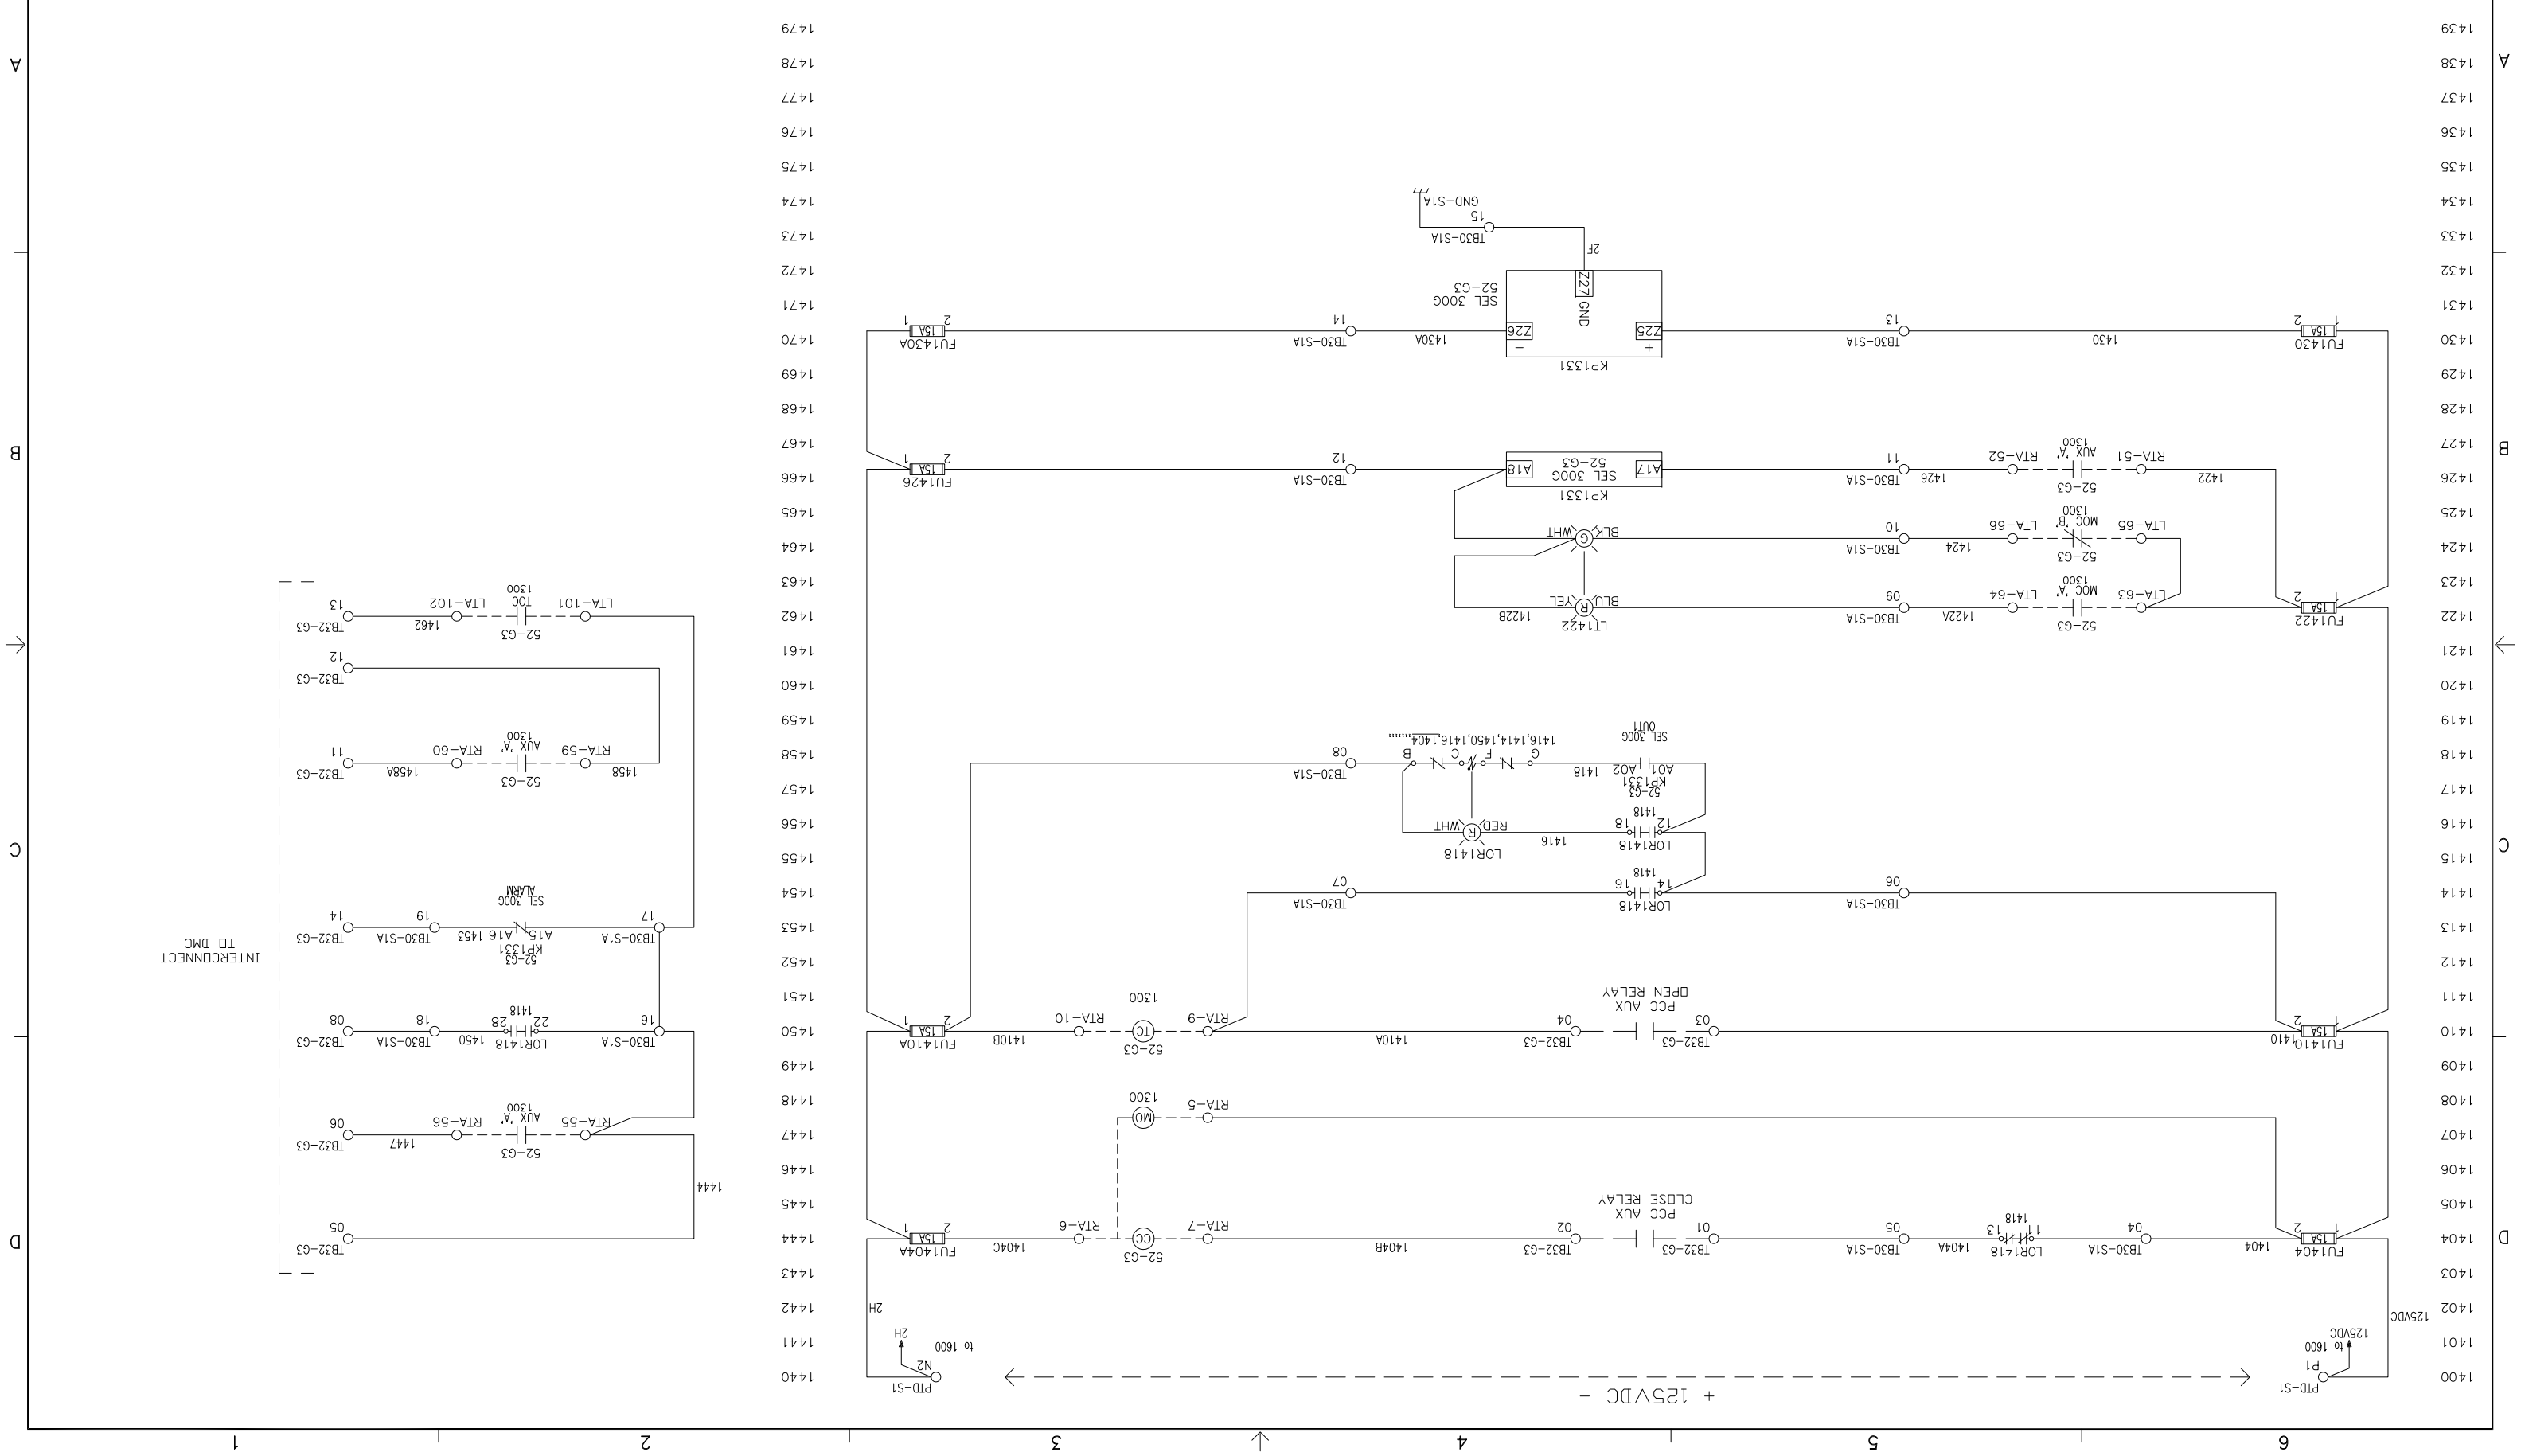

PC NO.	LTR	NO.	REVISION	ZONE	DRA	CHKR	APRV	DATE
PC104235	01	A	PRODUCTION RELEASE AS-BUILT	–	VS	VS	KT	06/17/10

PROJECT:
ARECIBO OBSERVATORY SWITCHGEAR
SG 52-G4 AC SCHEMATIC
CUMMINS CARIBBEAN
DISTRIBUTOR:
CUMMINS CARIBBEAN
707168I

DO NOT SCALE PRINT

AUTOCAD DWG

PART NO. | DWG SIZE | DESCRIPTION OF MATERIAL | REF DES

CUMMINS POWER GENERATION
1400 73rd AVE NE
MINNEAPOLIS, MN 55432

	NAME	DATE
DR	V.SAKLANI	06/17/10
CHKD MFG	V. SIVAN	06/17/10
APPROVED	K.TMUMASI	06/17/10

SITE CODE

TITLE
WD-SCHEMATISC

PGA

PCLL2004R-772F

DWG NO. A030S865 | SHEET 15 of 61 | DWG SIZE D

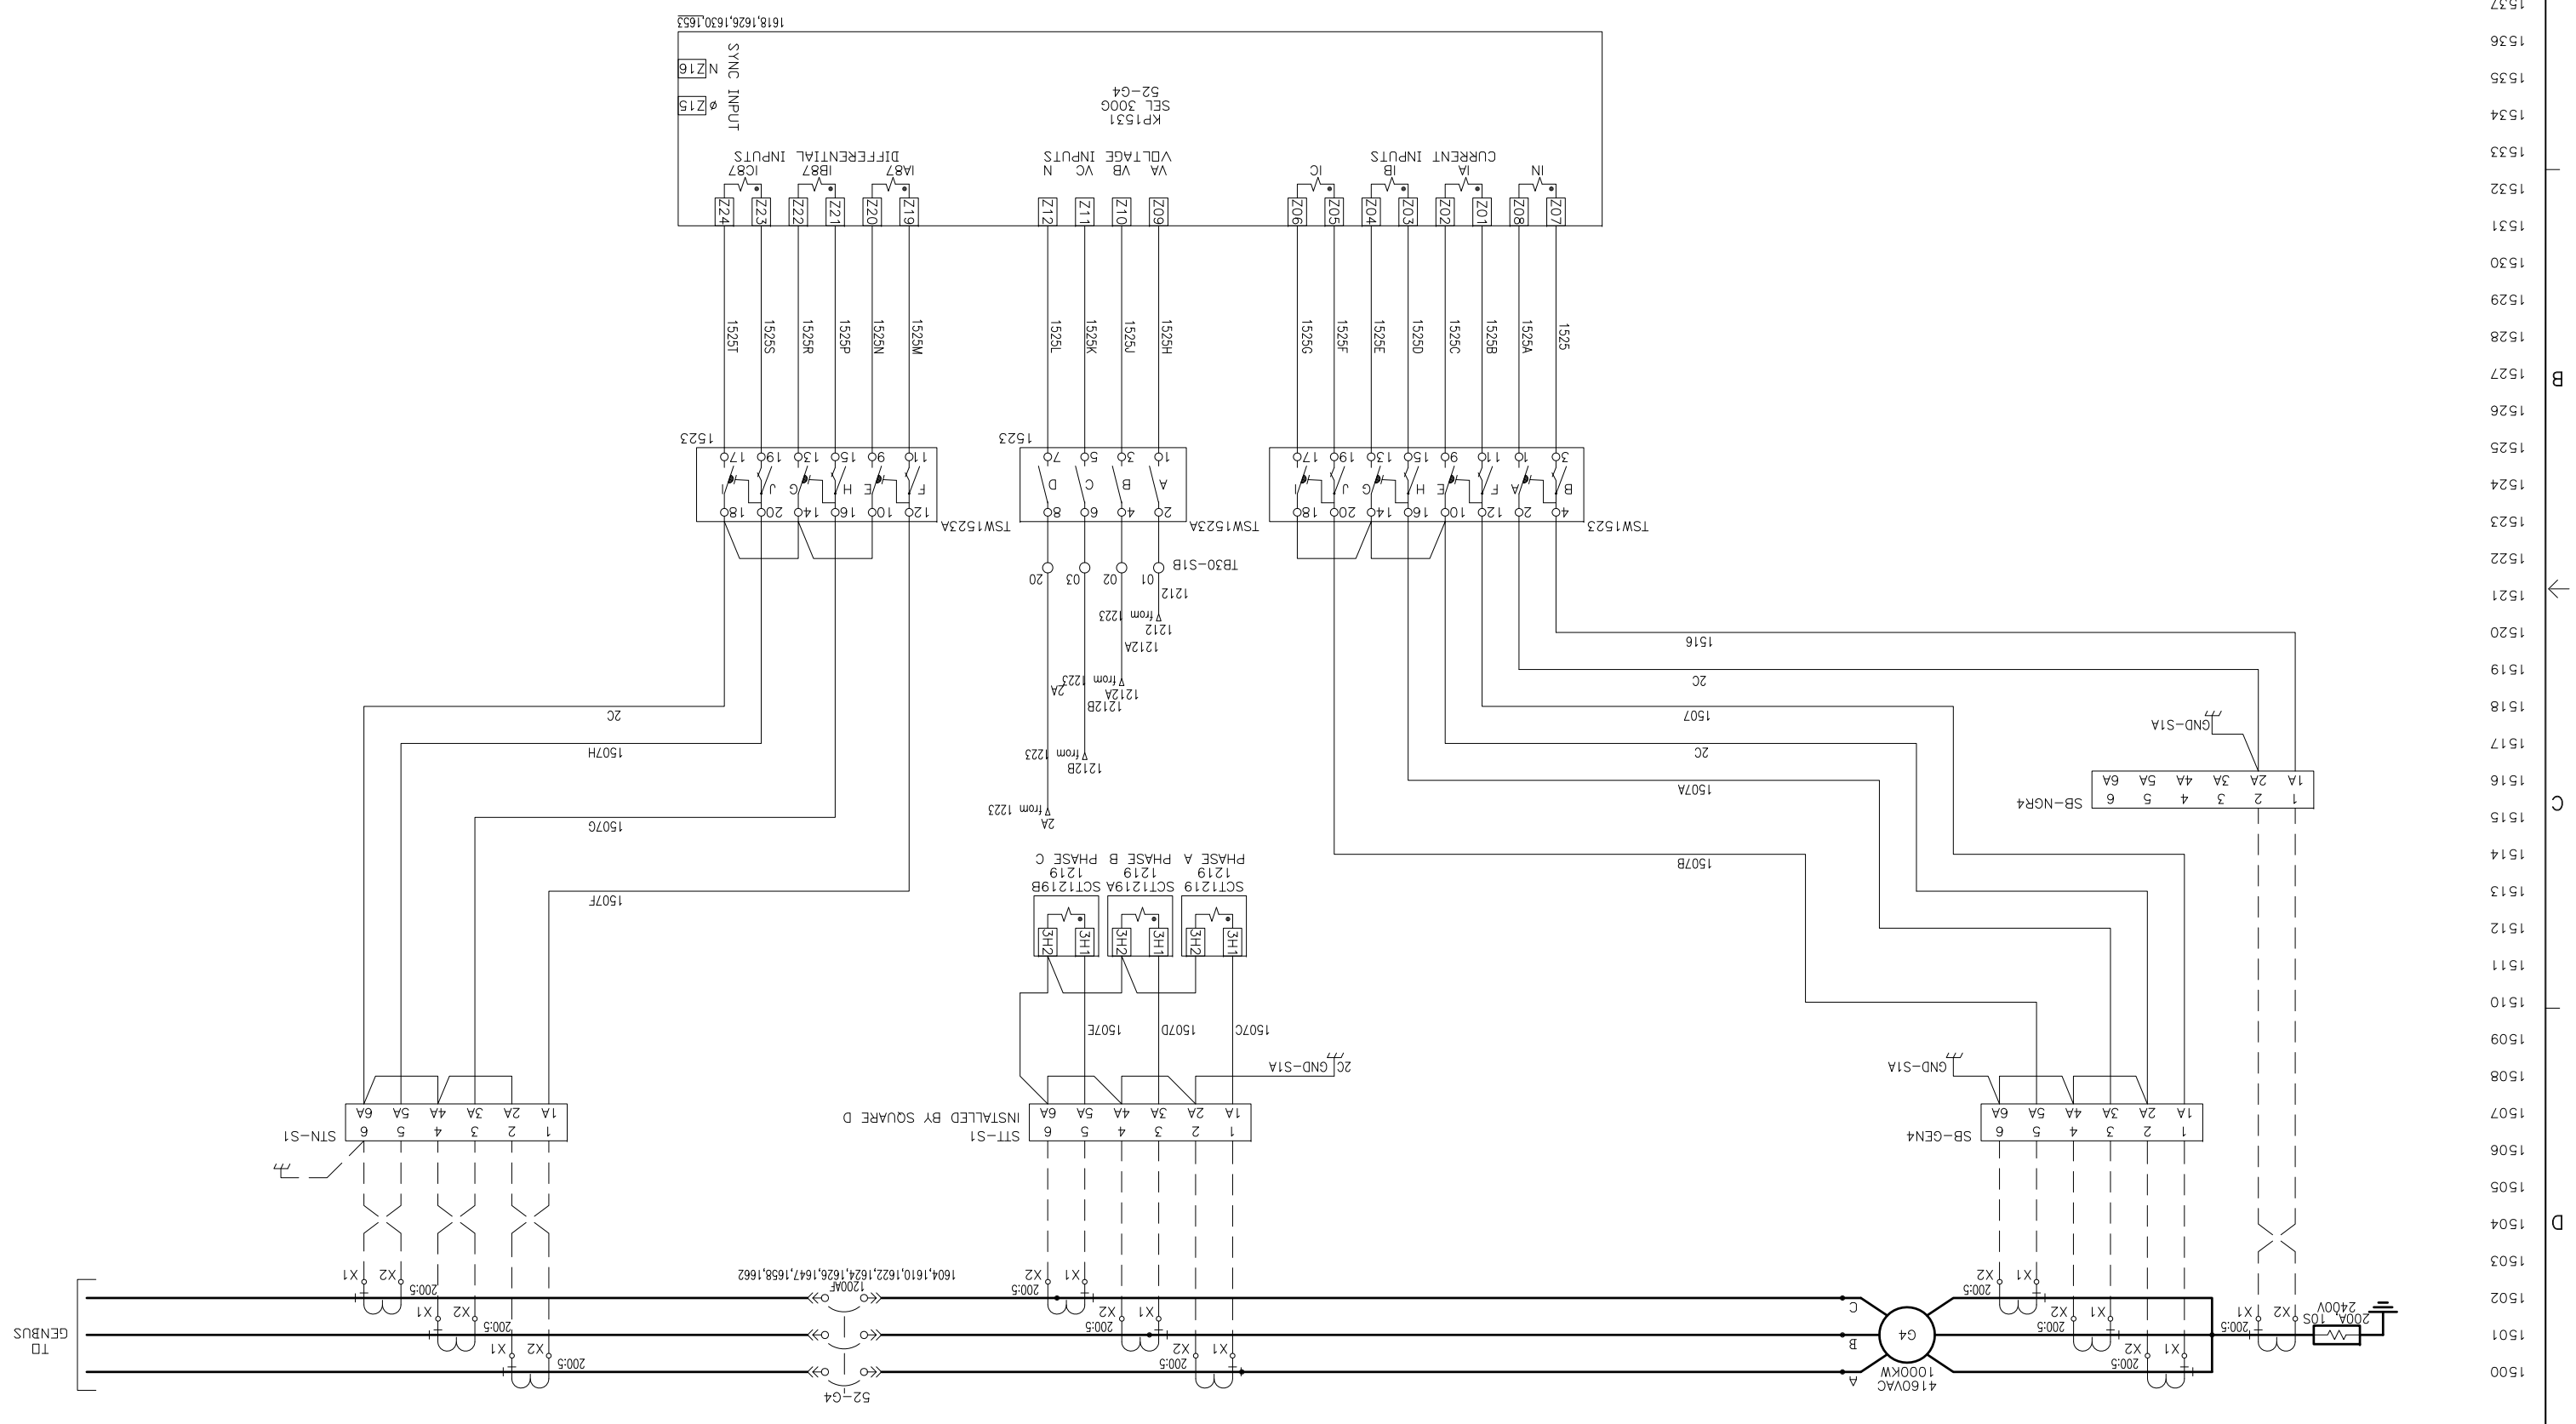

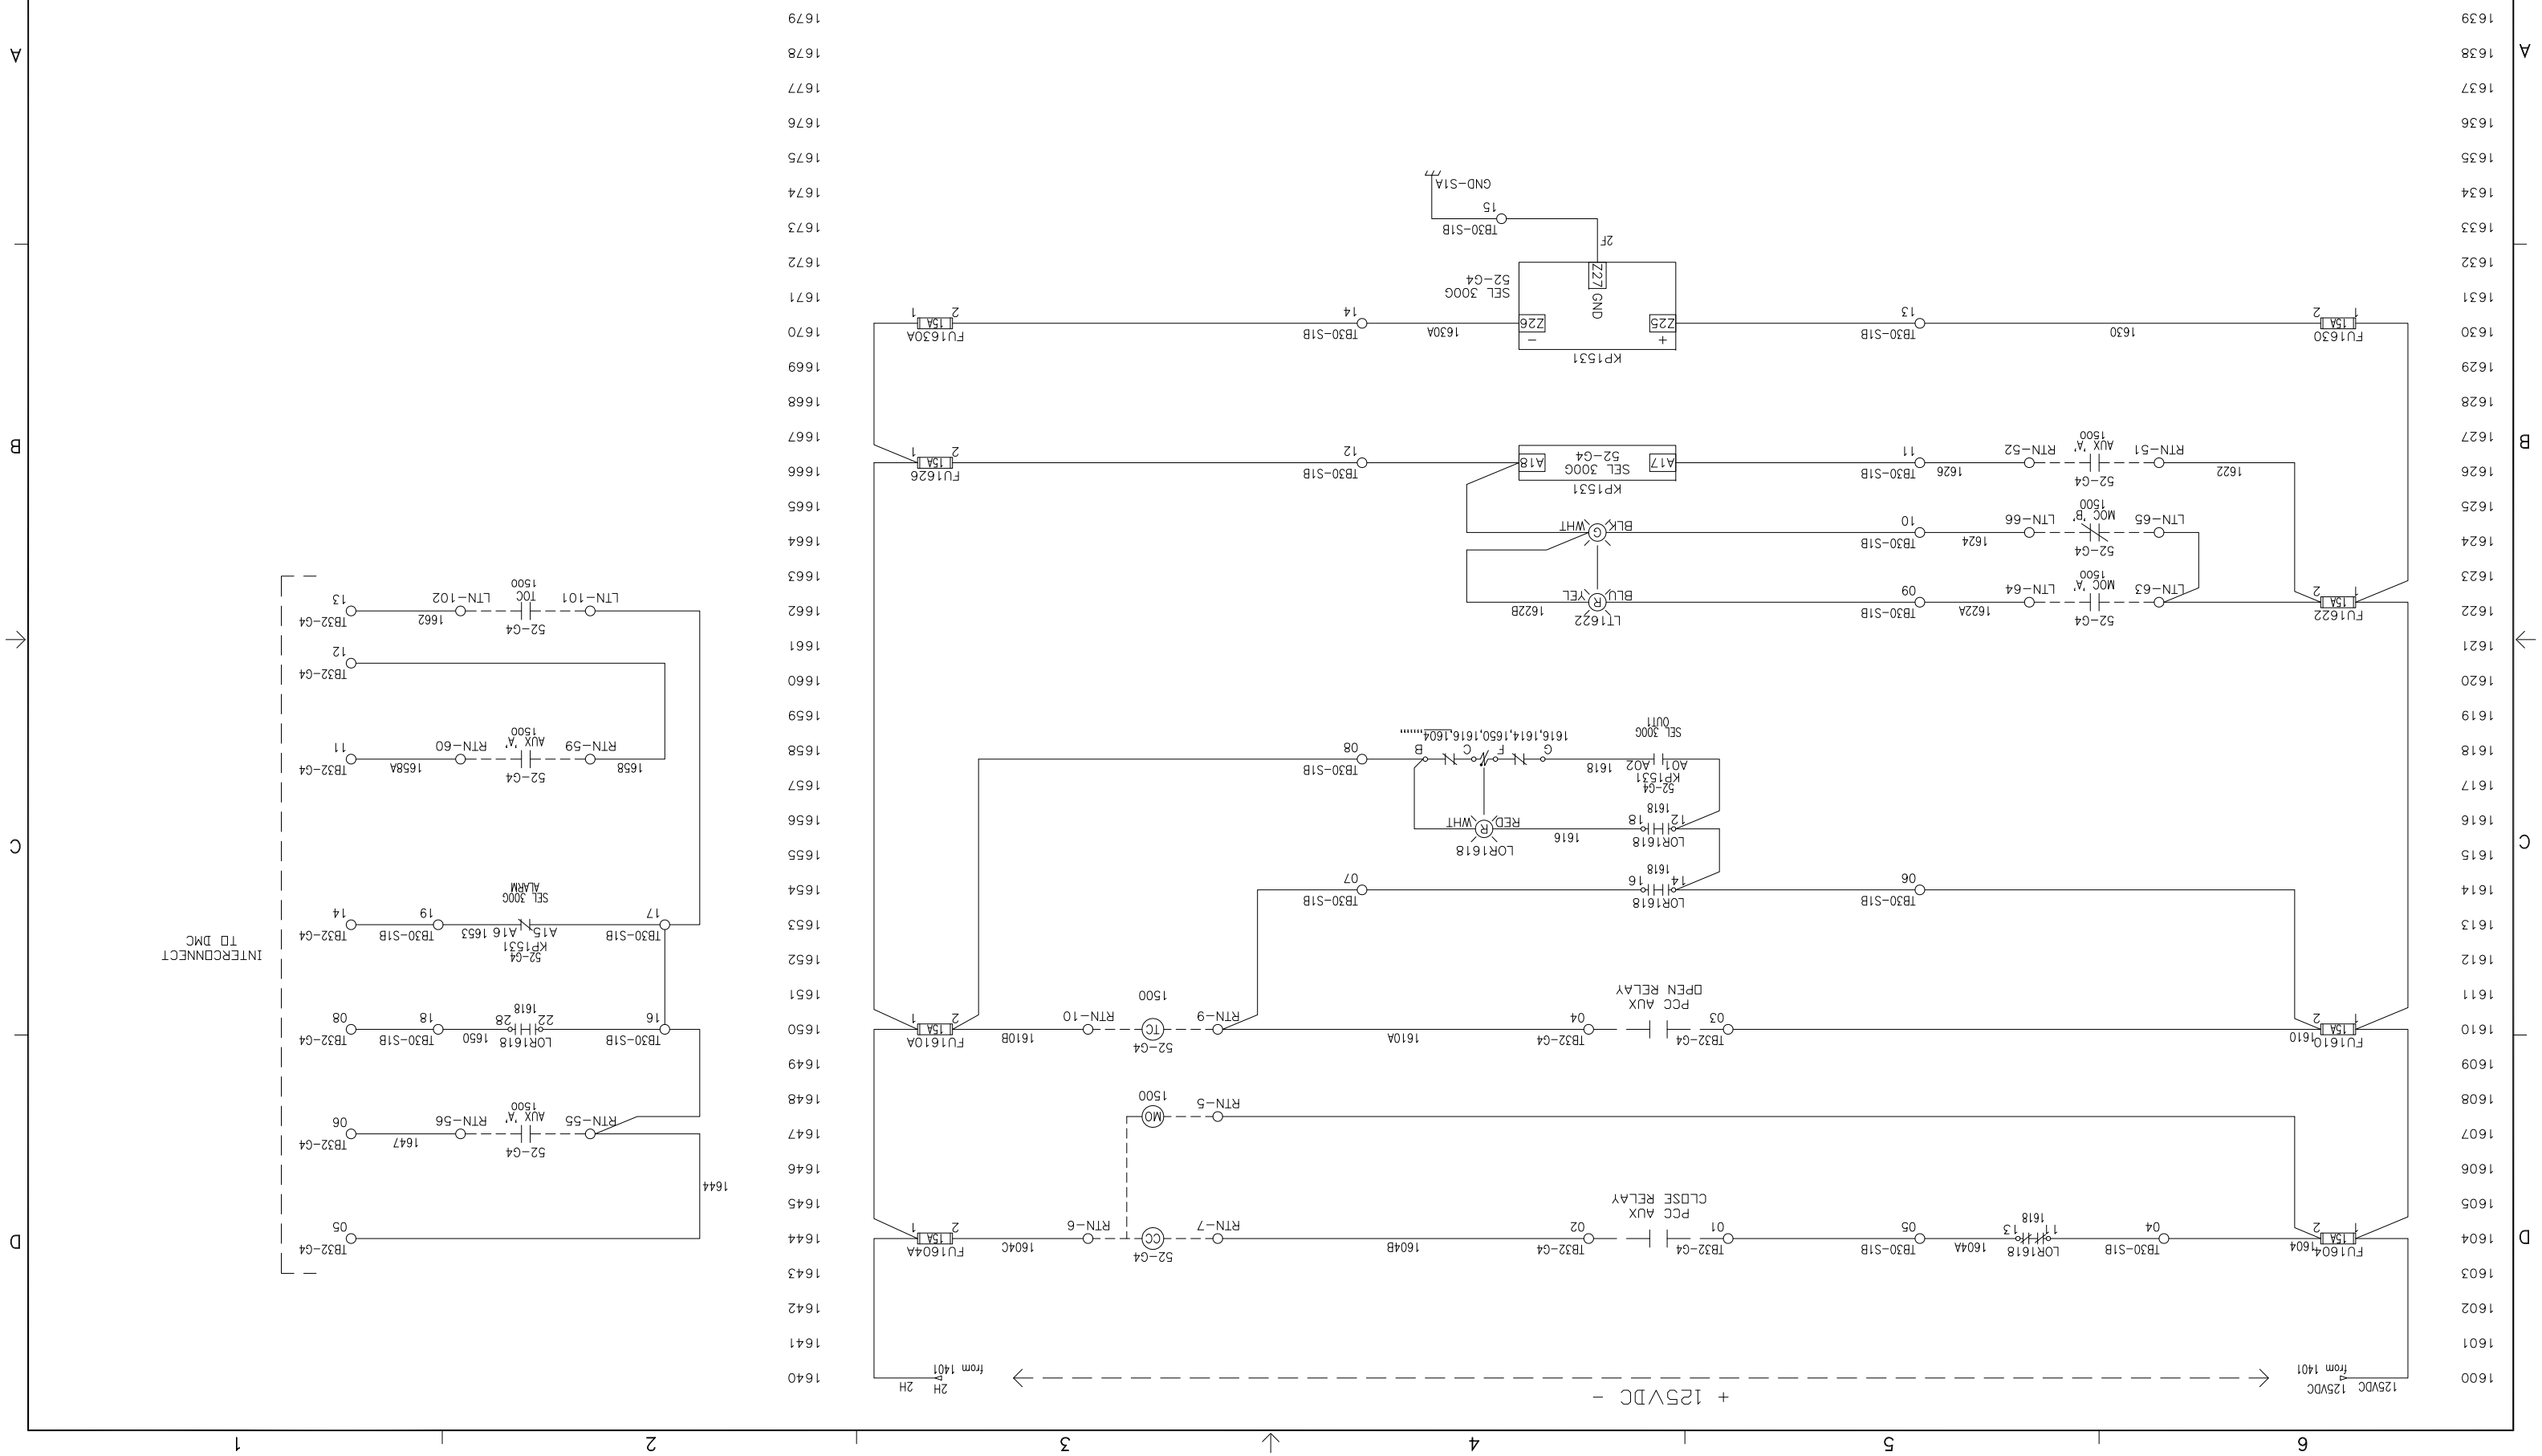
+ 125VDC -
125VDC
from 1401
2H
FU1604
TB30-S1B
LOR1618
TB32-G4
KP1531
SEL 300G OUT
FU1610
FU1630
FU1622
FU1626
FU1630A
FU1610A
FU1626A
FU1604A
LTN-101
LTN-102
LTN-63
LTN-64
LTN-65
LTN-66
RTN-51
RTN-52
RTN-55
RTN-56
RTN-59
RTN-60
RTN-5
RTN-6
RTN-7
RTN-9
RTN-10
LT1622
SEL 300G 52-G4
GND
GND-S1A
INTERCONNECT TO DMC
PCC AUX CLOSE RELAY
PCC AUX OPEN RELAY
SEL 300G ALARM
52-G4
MOC 'A'
MOC 'B'
AUX 'A'
TOC
MO
CC
TC

| PROJECT: | | |

PC NO.	LTR	NO.	REVISION	ZONE	DRA	CHKR	APRV	DATE
PC104235	01	A	PRODUCTION RELEASE AS-BUILT	–	VS	VS	KT	06/17/10

PROJECT:
ARECIBO OBSERVATORY SWITCHGEAR
SG 52-G1 AC SCHEMATIC
CUMMINS CARIBBEAN
DISTRIBUTOR:
7071681

DO NOT SCALE PRINT

AUTOCAD DWG

NAME	DATE
V.SAKLANI	06/17/10
V. SIVAN	06/17/10
APPROVED K.TMUMASI	06/17/10

PART NO. | DWG SIZE | DESCRIPTION OF MATERIAL | REF DES

CUMMINS POWER GENERATION
1400 73rd AVE NE
MINNEAPOLIS, MN 55432

TITLE
WD-SCHEMATISC

SITE CODE

PGA

PCLL2004R-772F

DWG NO. A030S865 | SHEET 17 of 61 | DWG SIZE D

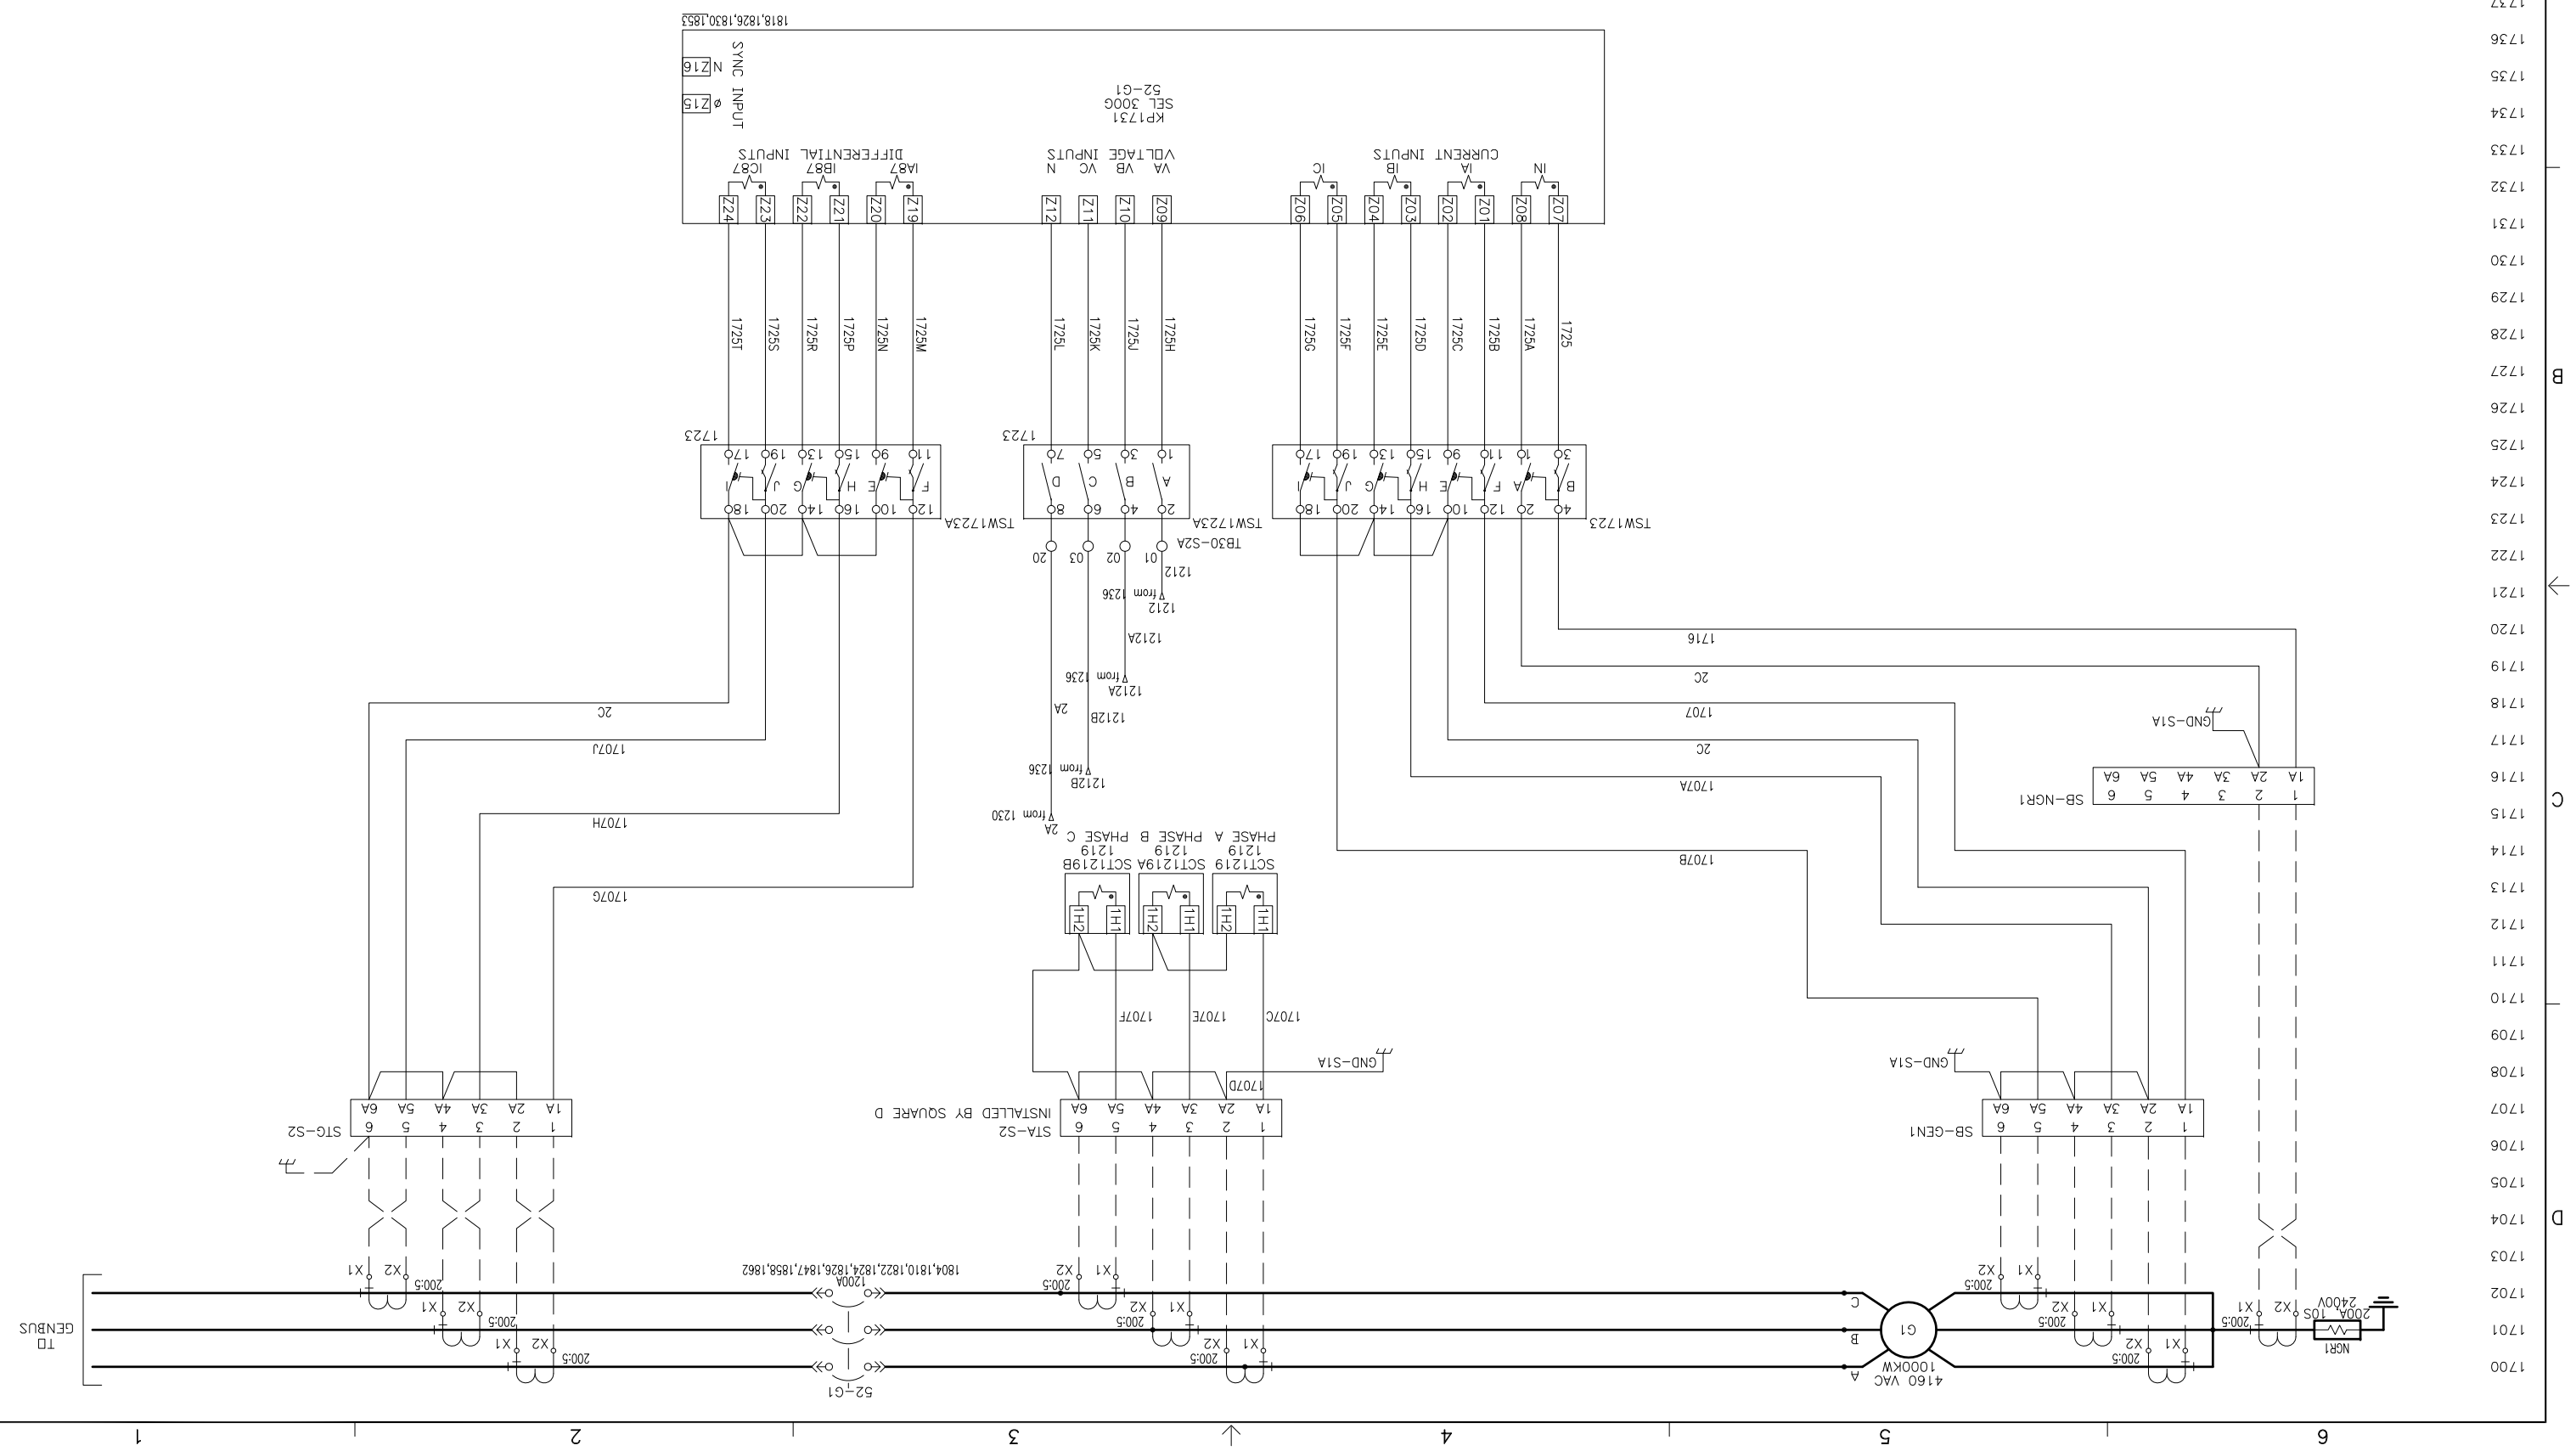

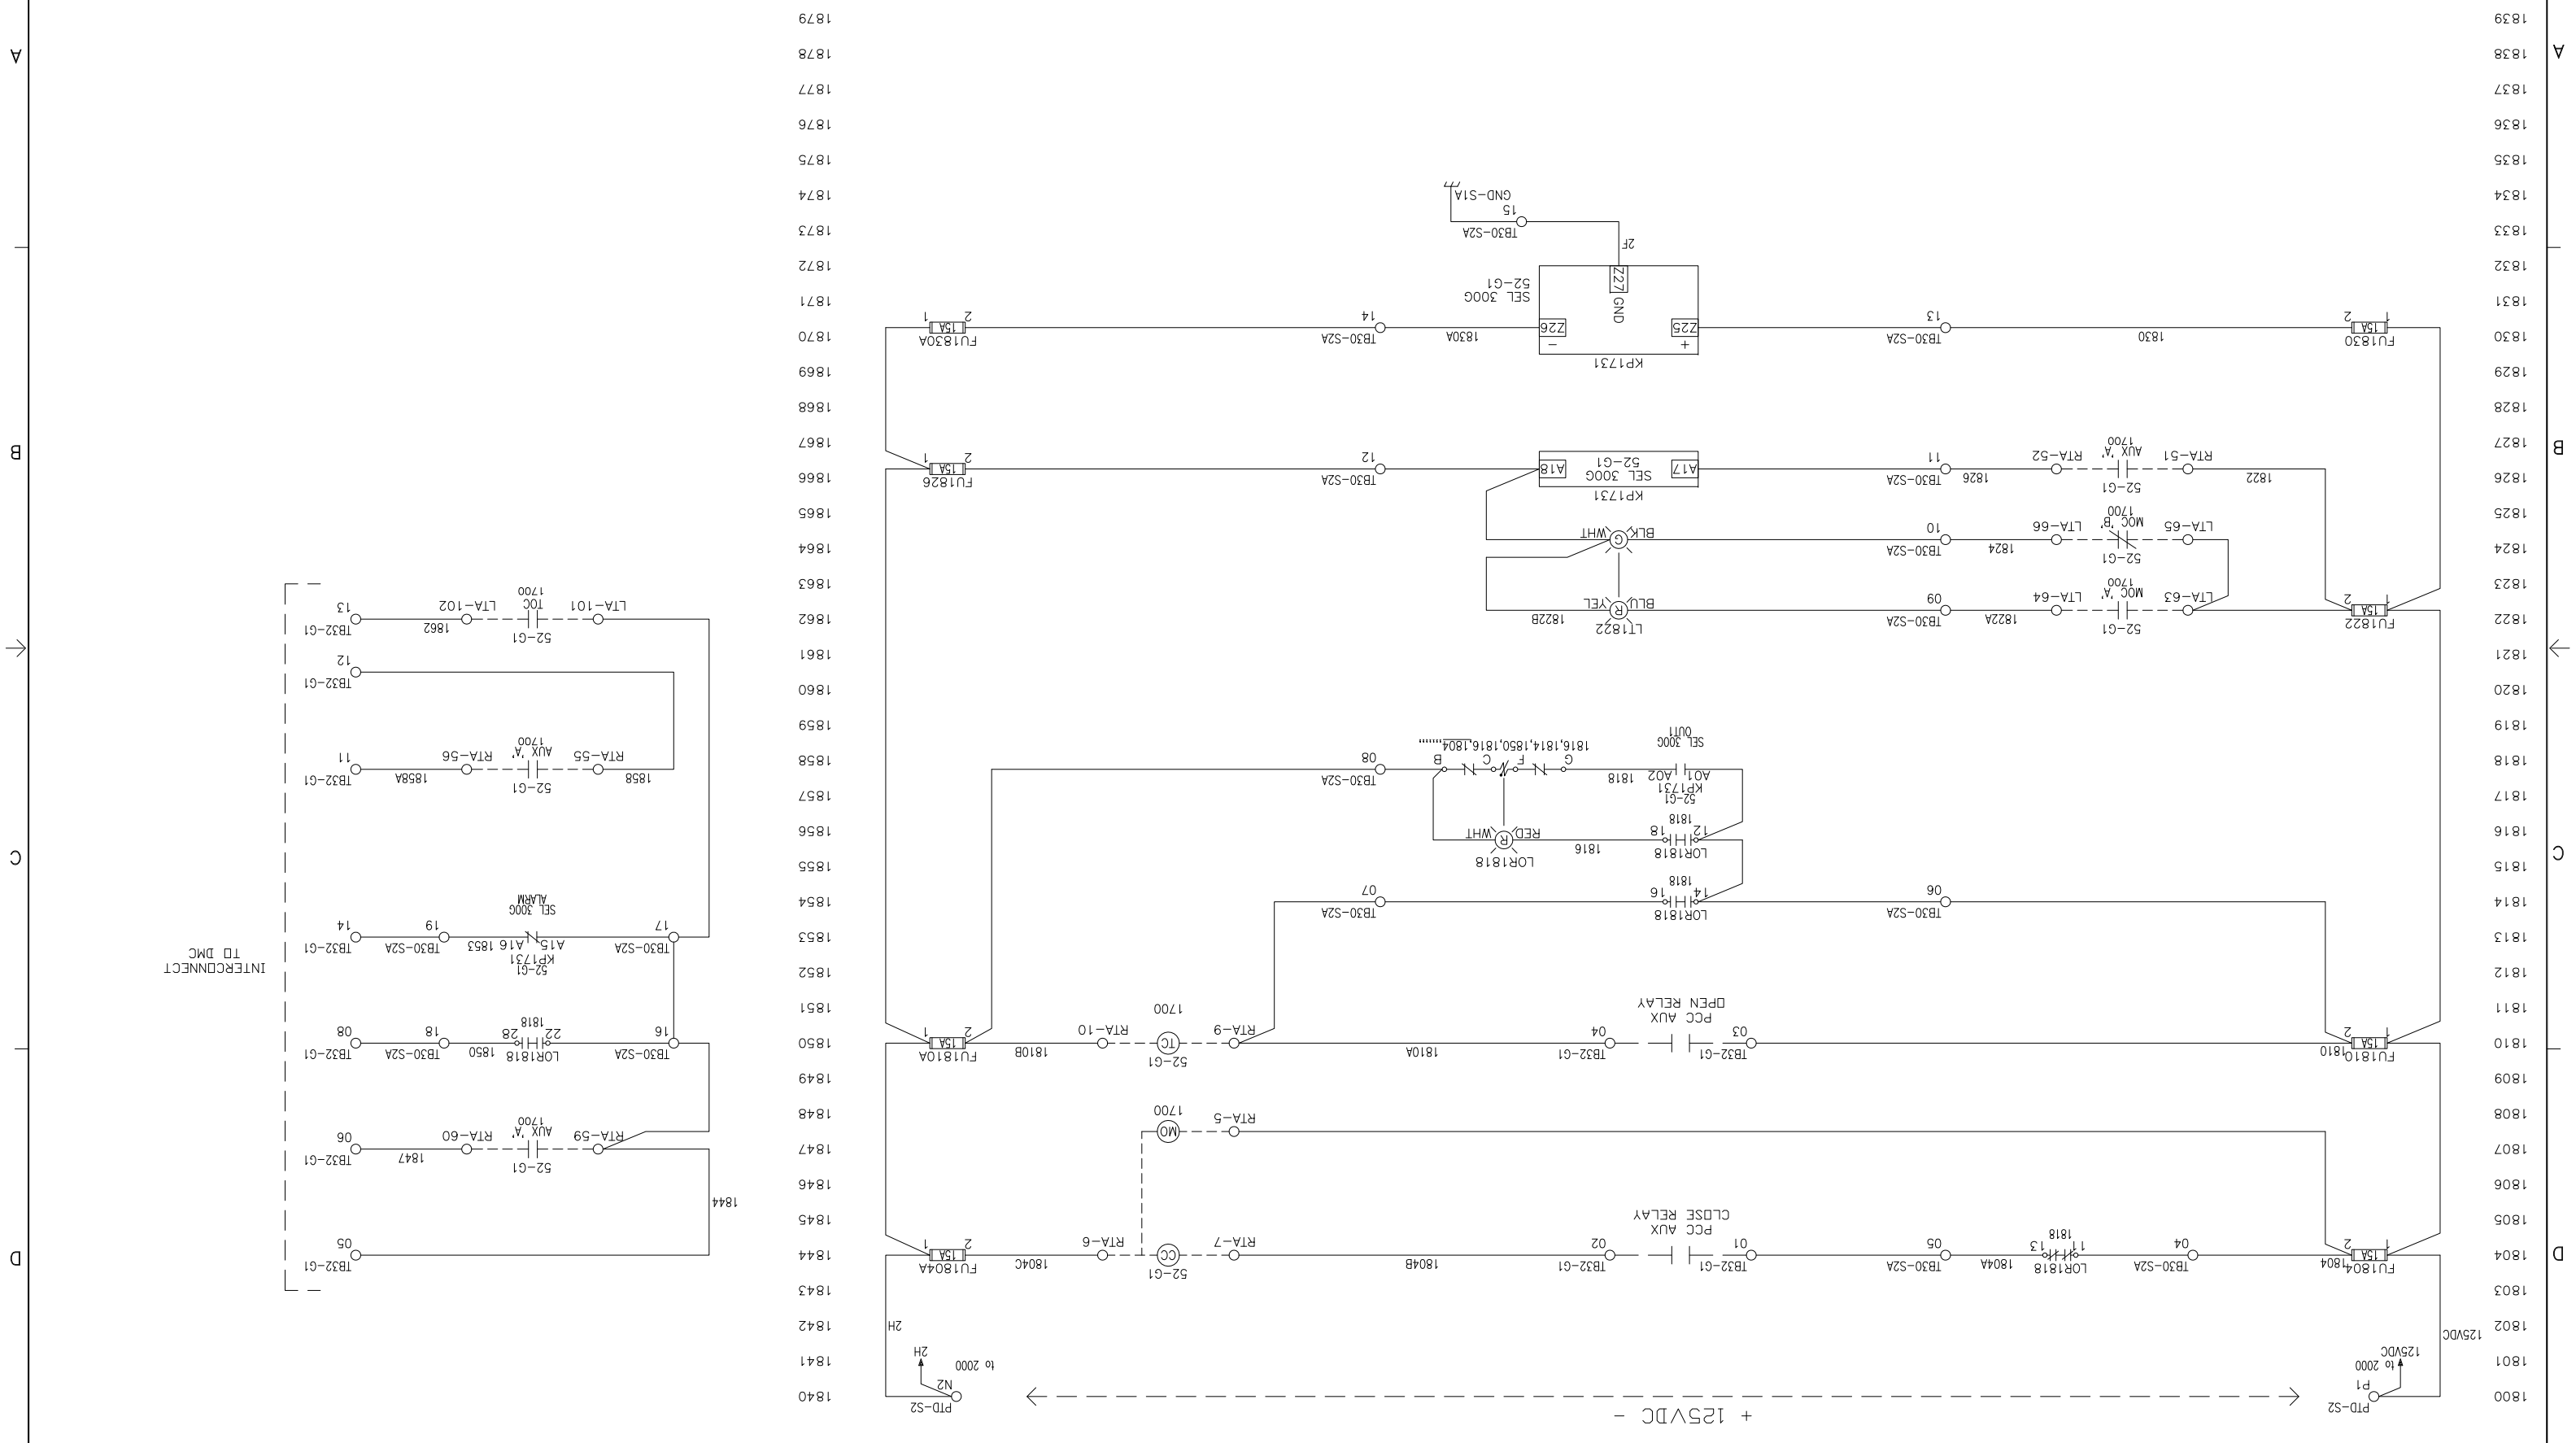
+ 125VDC -
PTD-S2
P1
to 2000
125VDC
N2
to 2000
2H
FU1804
1804
TB30-S2A
04
LOR1818
11
13
1818
TB30-S2A
05
1804A
TB32-G1
01
PCC AUX
CLOSE RELAY
TB32-G1
02
1804B
RTA-7
52-G1
CC
1804C
RTA-6
FU1804A
FU1810
1810
TB32-G1
03
PCC AUX
OPEN RELAY
TB32-G1
04
1810A
RTA-9
52-G1
TC
1810B
RTA-10
FU1810A
RTA-5
MO
1700
TB30-S2A
06
LOR1818
14
16
1818
TB30-S2A
07
LOR1818
12
18
1818
1816
LOR1818
R
RED
WHT
KP1731
52-G1
A01
A02
1818
G
F
C
B
SEL 300G
OUT1
1816,1814,1850,1816,1804.....
TB30-S2A
08
FU1822
1822
TB30-S2A
09
1822A
52-G1
LTA-63
MOC 'A'
1700
LTA-64
LTT1822
R
YEL
BLU
1822B
TB30-S2A
10
1824
52-G1
LTA-65
MOC 'B'
1700
LTA-66
G
WHT
BLK
TB30-S2A
11
1826
52-G1
RTA-51
AUX 'A'
1700
RTA-52
KP1731
A17
SEL 300G
52-G1
A18
TB30-S2A
12
FU1826
1822
FU1830
1830
TB30-S2A
13
KP1731
225
+
226
-
1830A
TB30-S2A
14
FU1830A
GND
227
2F
TB30-S2A
15
GND-S1A
INTERCONNECT
TO DMC
TB32-G1
05
1844
52-G1
RTA-59
AUX 'A'
1700
RTA-60
1847
TB32-G1
06
TB30-S2A
16
LOR1818
22
28
1818
TB30-S2A
18
1850
TB32-G1
08
TB30-S2A
17
KP1731
52-G1
A15
A16
1853
TB30-S2A
19
SEL 300G
ALARM
TB32-G1
14
TB32-G1
12
52-G1
RTA-55
AUX 'A'
1700
RTA-56
1858
TB32-G1
11
1858A
TB32-G1
13
52-G1
TLA-101
TOC
1700
LTA-102
1862
TB32-G1

| PROJECT: | | |

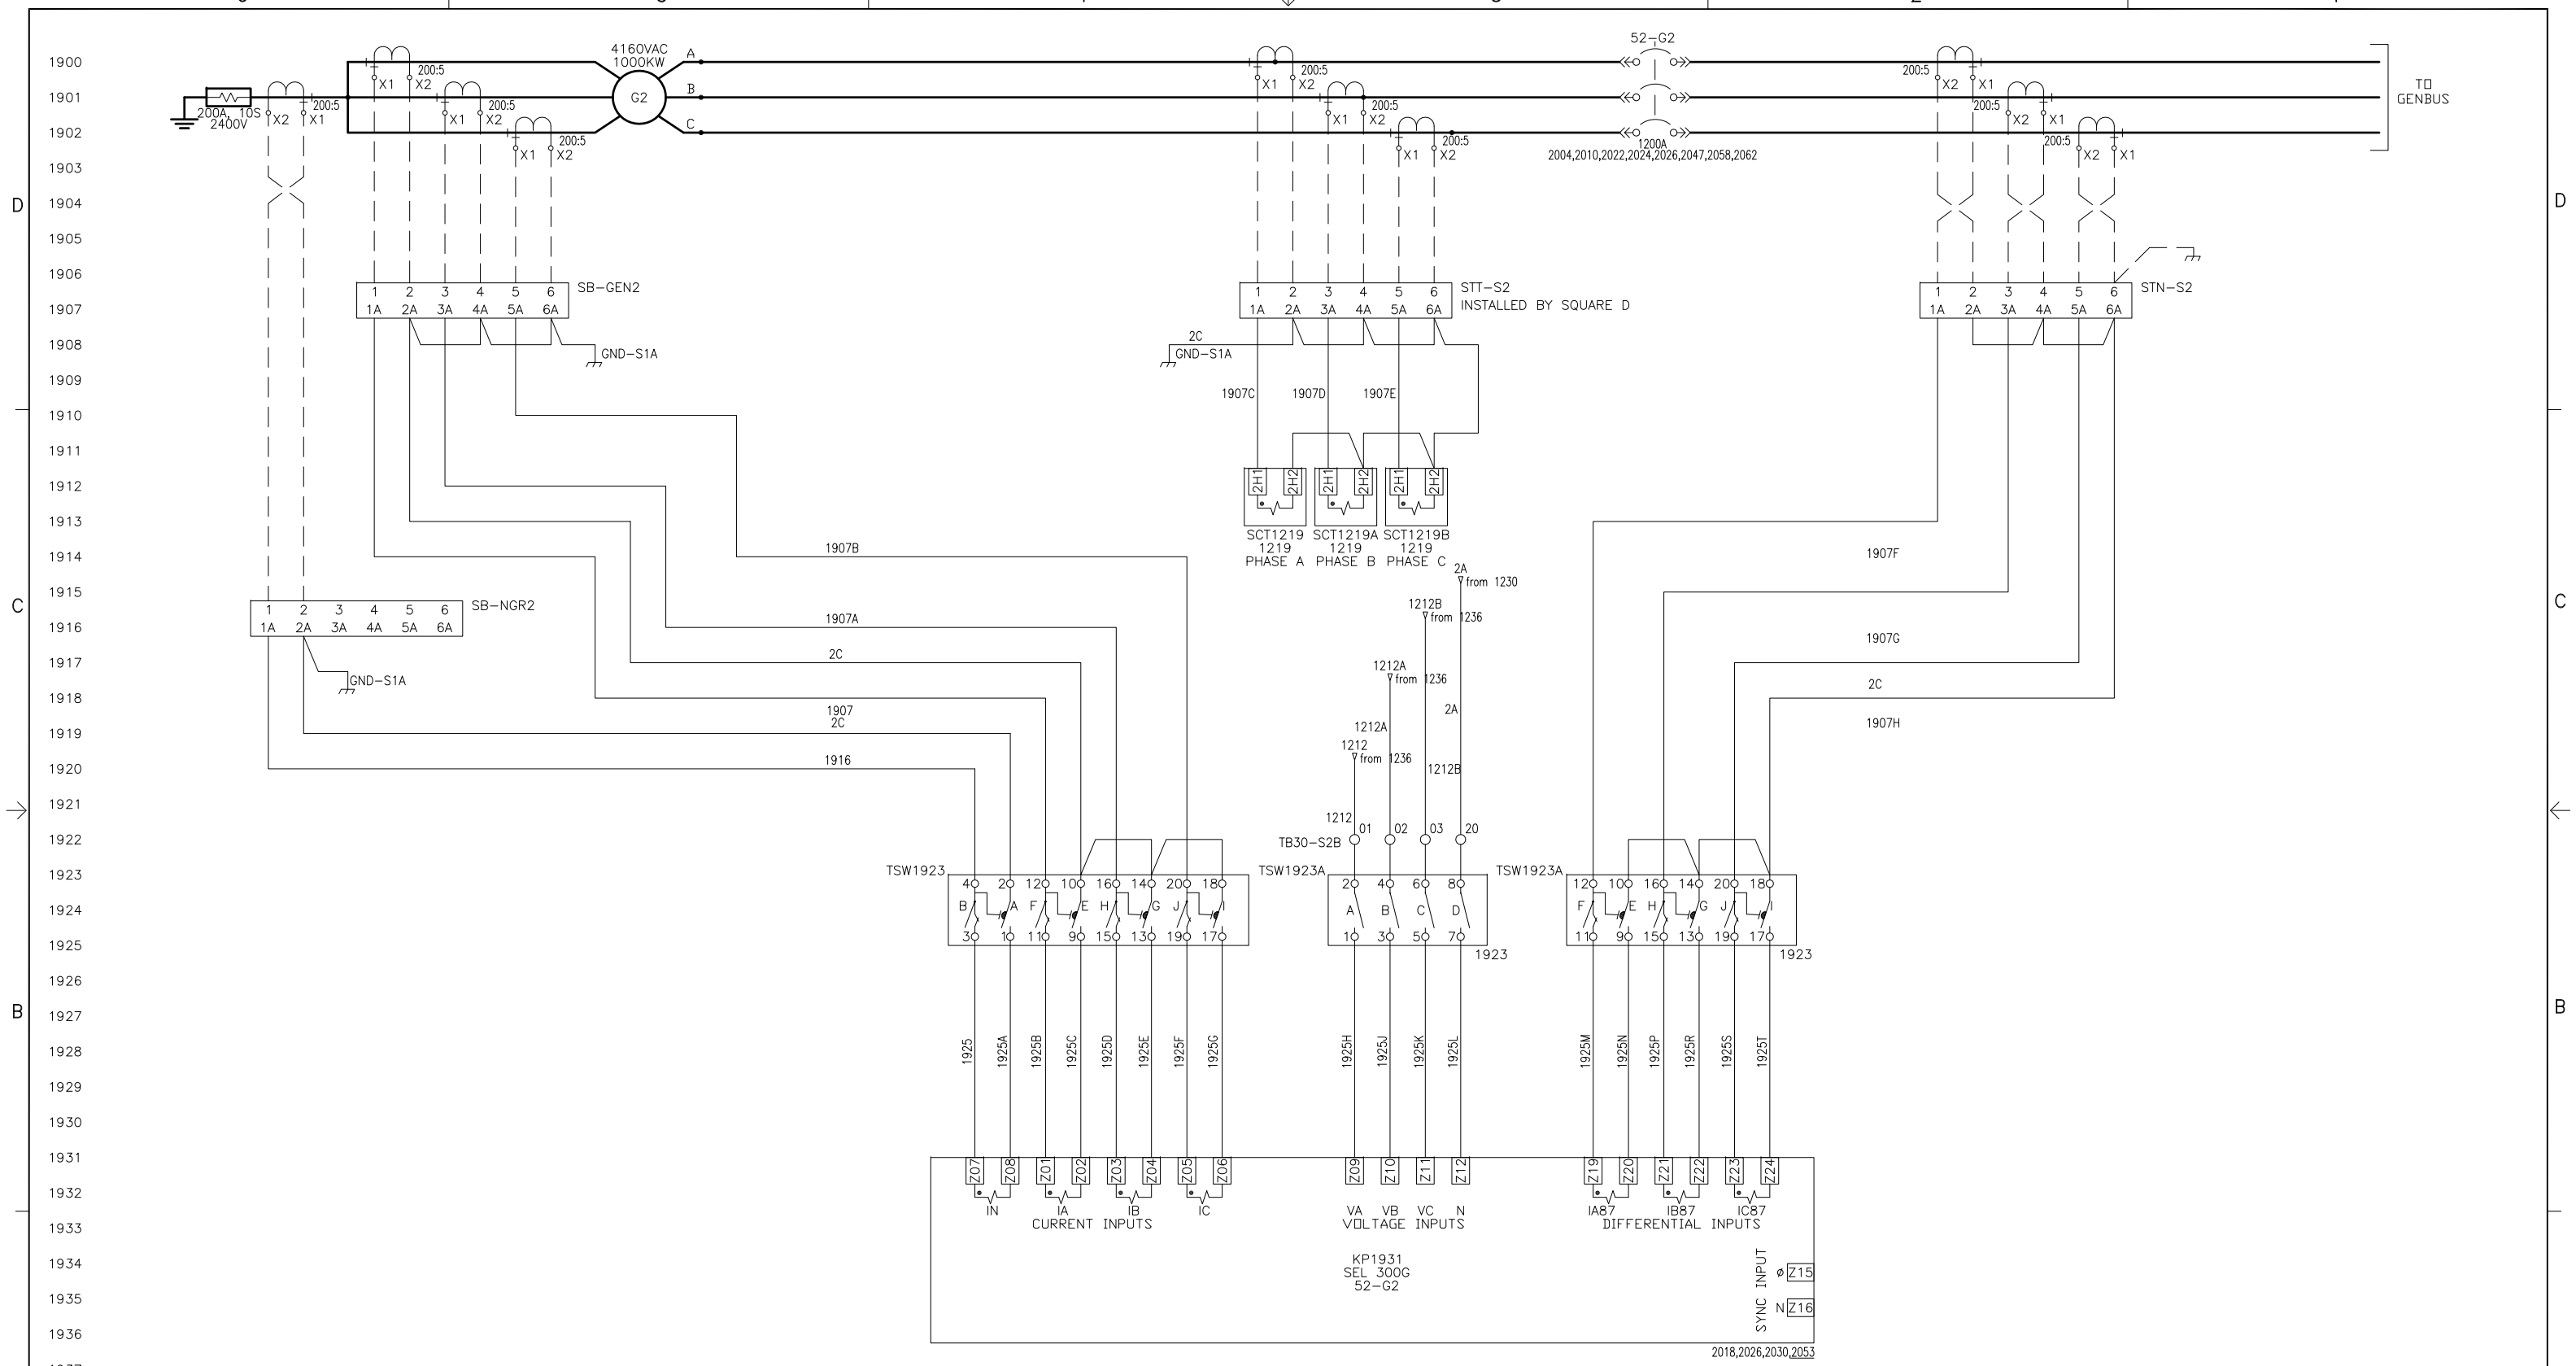

PC NO.	LTR	NO.	REVISION	ZONE	DRA	CHKR	APRV	DATE
PC104235	01	A	PRODUCTION RELEASE AS-BUILT	–	VS	VS	KT	06/17/10

PROJECT:
ARECIBO OBSERVATORY SWITCHGEAR
SG 52-G2 AC SCHEMATIC
DISTRIBUTOR:
CUMMINS CARIBBEAN
7071681

DO NOT SCALE PRINT

ANG TOL | DRAWN TO SCALE OF

AUTOCAD DWG

SIM TO | COPIED FROM | THREE ANGLE PROJECTION

THIS DOCUMENT IS THE PROPERTY OF CUMMINS POWER GENERATION. IT CONTAINS PROPRIETARY AND CONFIDENTIAL INFORMATION WHICH MUST NOT BE DUPLICATED, USED OR DISCLOSED OTHER THAN EXPRESSLY AUTHORIZED BY CUMMINS POWER GENERATION OR ITS REPRESENTATIVE

PART NO.	DWG SIZE	DESCRIPTION OF MATERIAL	REF DES

	NAME	DATE
DR	V.SAKLANI	06/17/10
CHKR / MFG	V. SIVAN	06/17/10
APPROVED	K.TWUMASI	06/17/10

FOR INTERPRETATION OF DIMENSIONING AND TOLERANCING, SEE ANSI Y14.5M-1982

MODEL FIRST USED ON: PCIL2004R-772F

SITE CODE: PGA

CUMMINS POWER GENERATION
1400 73rd AVE NE
MINNEAPOLIS, MN 55432

TITLE: WD-SCHEMATISC

DWG NO.: A030S865

SHEET: 19 of 61

DWG SIZE: D

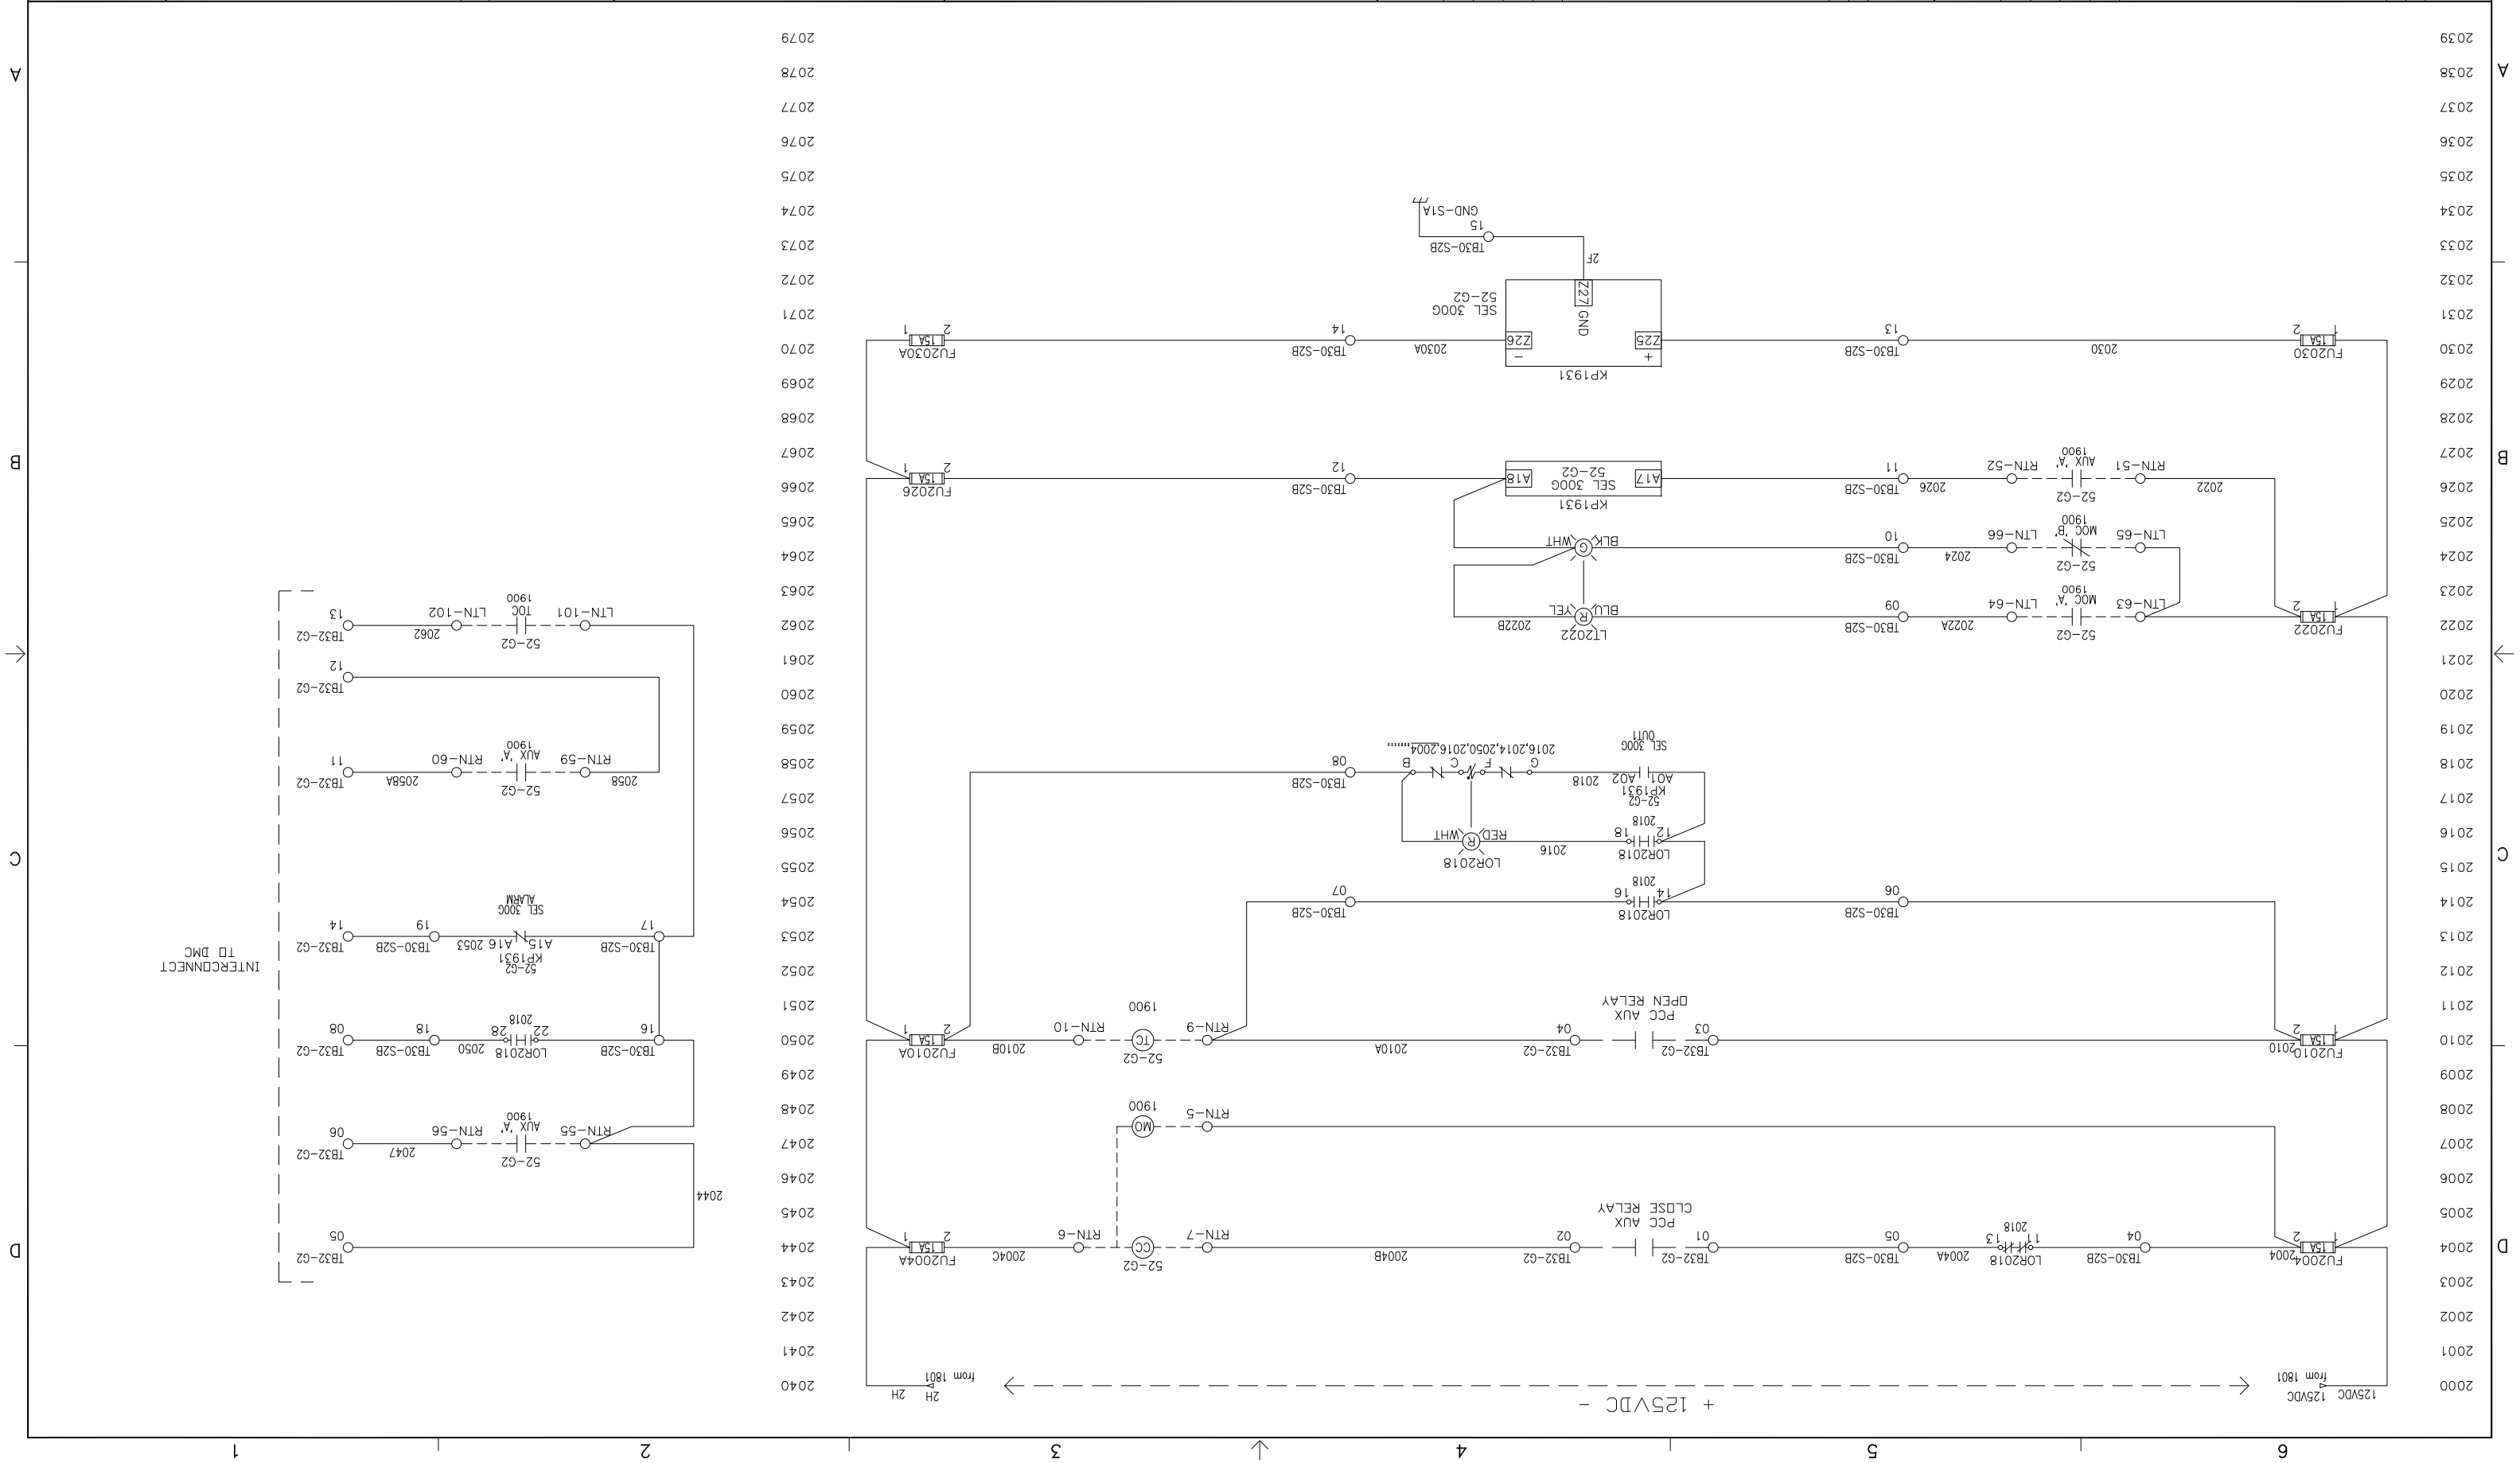

PC NO.	LTR	NO.	REVISION	ZONE	DRA	CHKR	APRV	DATE

PC NO.	LTR	NO.	REVISION	ZONE	DRA	CHKR	APRV	DATE
PC104235	01	A	PRODUCTION RELEASE AS-BUILT	–	VS	VS	KT	06/17/10

PROJECT:
ARECIBO OBSERVATORY SWITCHGEAR
SG 52-G2 DC SCHEMATICS
CUMMINS CARIBBEAN
DISTRIBUTOR:
CUMMINS CARIBBEAN
707168I

AUTOCAD DWG

DO NOT SCALE PRINT

		NAME	DATE
DRAWN	V.SAKLANI		06/17/10
CHKD	V. SIVAN		06/17/10
APPROVED	K.TMUMASI		06/17/10

MODEL FIRST USED ON PCLL200AR-772F

PART NO. | DWG SIZE | DESCRIPTION OF MATERIAL | REF DES

CUMMINS POWER GENERATION
1400 73rd AVE NE
MINNEAPOLIS, MN 55432

TITLE WD-SCHEMATISC

SITE CODE PGA

DWG NO. A030S865 | SHEET 20 OF 61 | DWG SIZE D

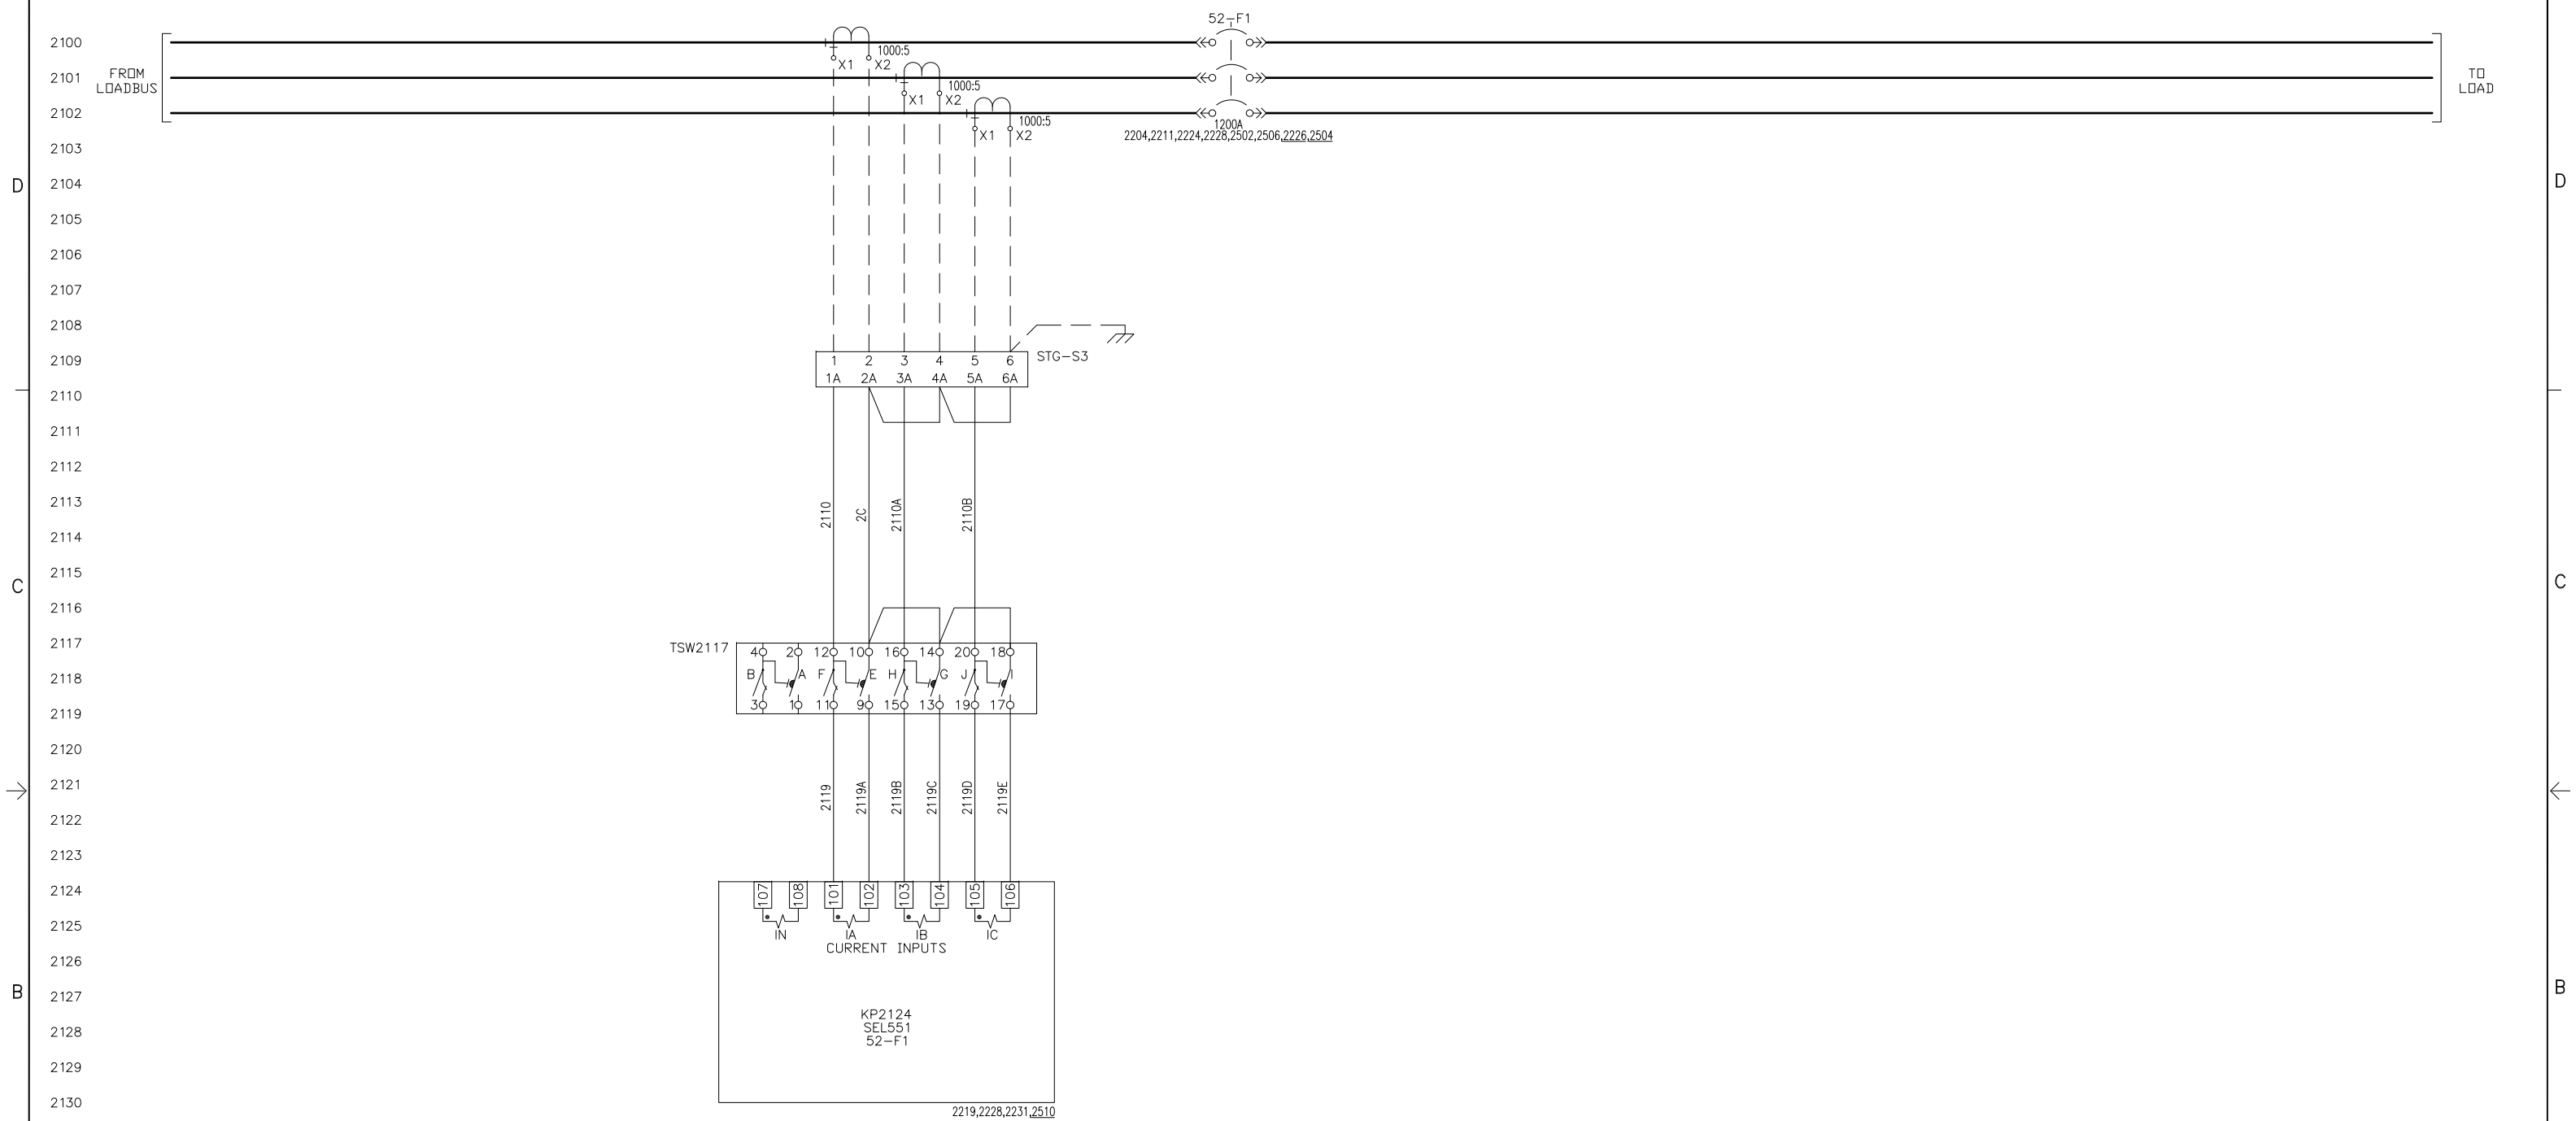

PC NO.	LTR	NO.	REVISION	ZONE	DRA	CHKR	APRV	DATE
PC104235	01	A	PRODUCTION RELEASE AS-BUILT	–	VS	VS	KT	06/17/10

PROJECT:
ARECIBO OBSERVATORY SWITCHGEAR
SG 52-F1 AC SCHEMATIC
DISTRIBUTOR:
CUMMINS CARIBBEAN
7071681

DO NOT SCALE PRINT

AUTOCAD DWG

SIM TO
COPIED FROM
THREE ANGLE PROJECTION
ANG TOL
DRAWN TO SCALE OF

THIS DOCUMENT IS THE PROPERTY OF CUMMINS POWER GENERATION. IT CONTAINS PROPRIETARY AND CONFIDENTIAL INFORMATION WHICH MUST NOT BE DUPLICATED, USED OR DISCLOSED OTHER THAN EXPRESSLY AUTHORIZED BY CUMMINS POWER GENERATION OR ITS REPRESENTATIVE

FOR INTERPRETATION OF DIMENSIONING AND TOLERANCING, SEE ANSI Y14.5M-1982

MODEL FIRST USED ON PCIL2004R-772F

PART NO.	DWG SIZE	DESCRIPTION OF MATERIAL	REF DES

	NAME	DATE
DR	V.SAKLANI	06/17/10
CHKR / MFG	V. SIVAN	06/17/10
APPROVED	K.TWUMASI	06/17/10

SITE CODE: PGA

CUMMINS POWER GENERATION
1400 73rd AVE. NE
MINNEAPOLIS, MN 55432

TITLE: WD-SCHEMATISC

DWG NO. A030S865 | SHEET 21 of 61 | DWG SIZE D

PC NO.	LTR	NO.	REVISION	ZONE	DRA	CHKR	APRV	DATE	PC NO.	LTR	NO.	REVISION	ZONE	DRA	CHKR	APRV	DATE
									PC104235	01	A	PRODUCTION RELEASE AS-BUILT	–	VS	VS	KT	06/17/10

PROJECT:
ARECIBO OBSERVATORY SWITHCGEAR
SG 52-F1 DC SCHEMATICS
CUMMINS CARIBBEAN
DISTRIBUTOR:
CUMMINS CARIBBEAN
707168I

ANS TOL	DRAWN TO SCALE OF		
DO NOT SCALE PRINT			
SW 10	CHKED PROJ		

AUTOCAD DWG

PC NO.	LTR	NO.	REVISION	ZONE	DRA	CHKR	APRV	DATE
PC104235	01	A	PRODUCTION RELEASE AS-BUILT	–	VS	VS	KT	06/17/10

PROJECT:
ARECIBO OBSERVATORY SWITCHGEAR
SG 52-F2 AC SCHEMATIC
DISTRIBUTOR:
CUMMINS CARIBBEAN
707168I

DO NOT SCALE PRINT

AUTOCAD DWG

PART NO.	DWG SIZE	DESCRIPTION OF MATERIAL	REF DES

CUMMINS POWER GENERATION
1400 73rd AVE NE
MINNEAPOLIS, MN 55432

	NAME	DATE
DR	V.SAKLANI	06/17/10
CHKD MFG	V. SIVAN	06/17/10
APPROVED	K.TMUMASI	06/17/10

SITE CODE

TITLE
WD-SCHEMATISC

DWG NO. A030S865 SHEET 23 OF 61 DWG SIZE D

PGA

PCLL200AR-772F

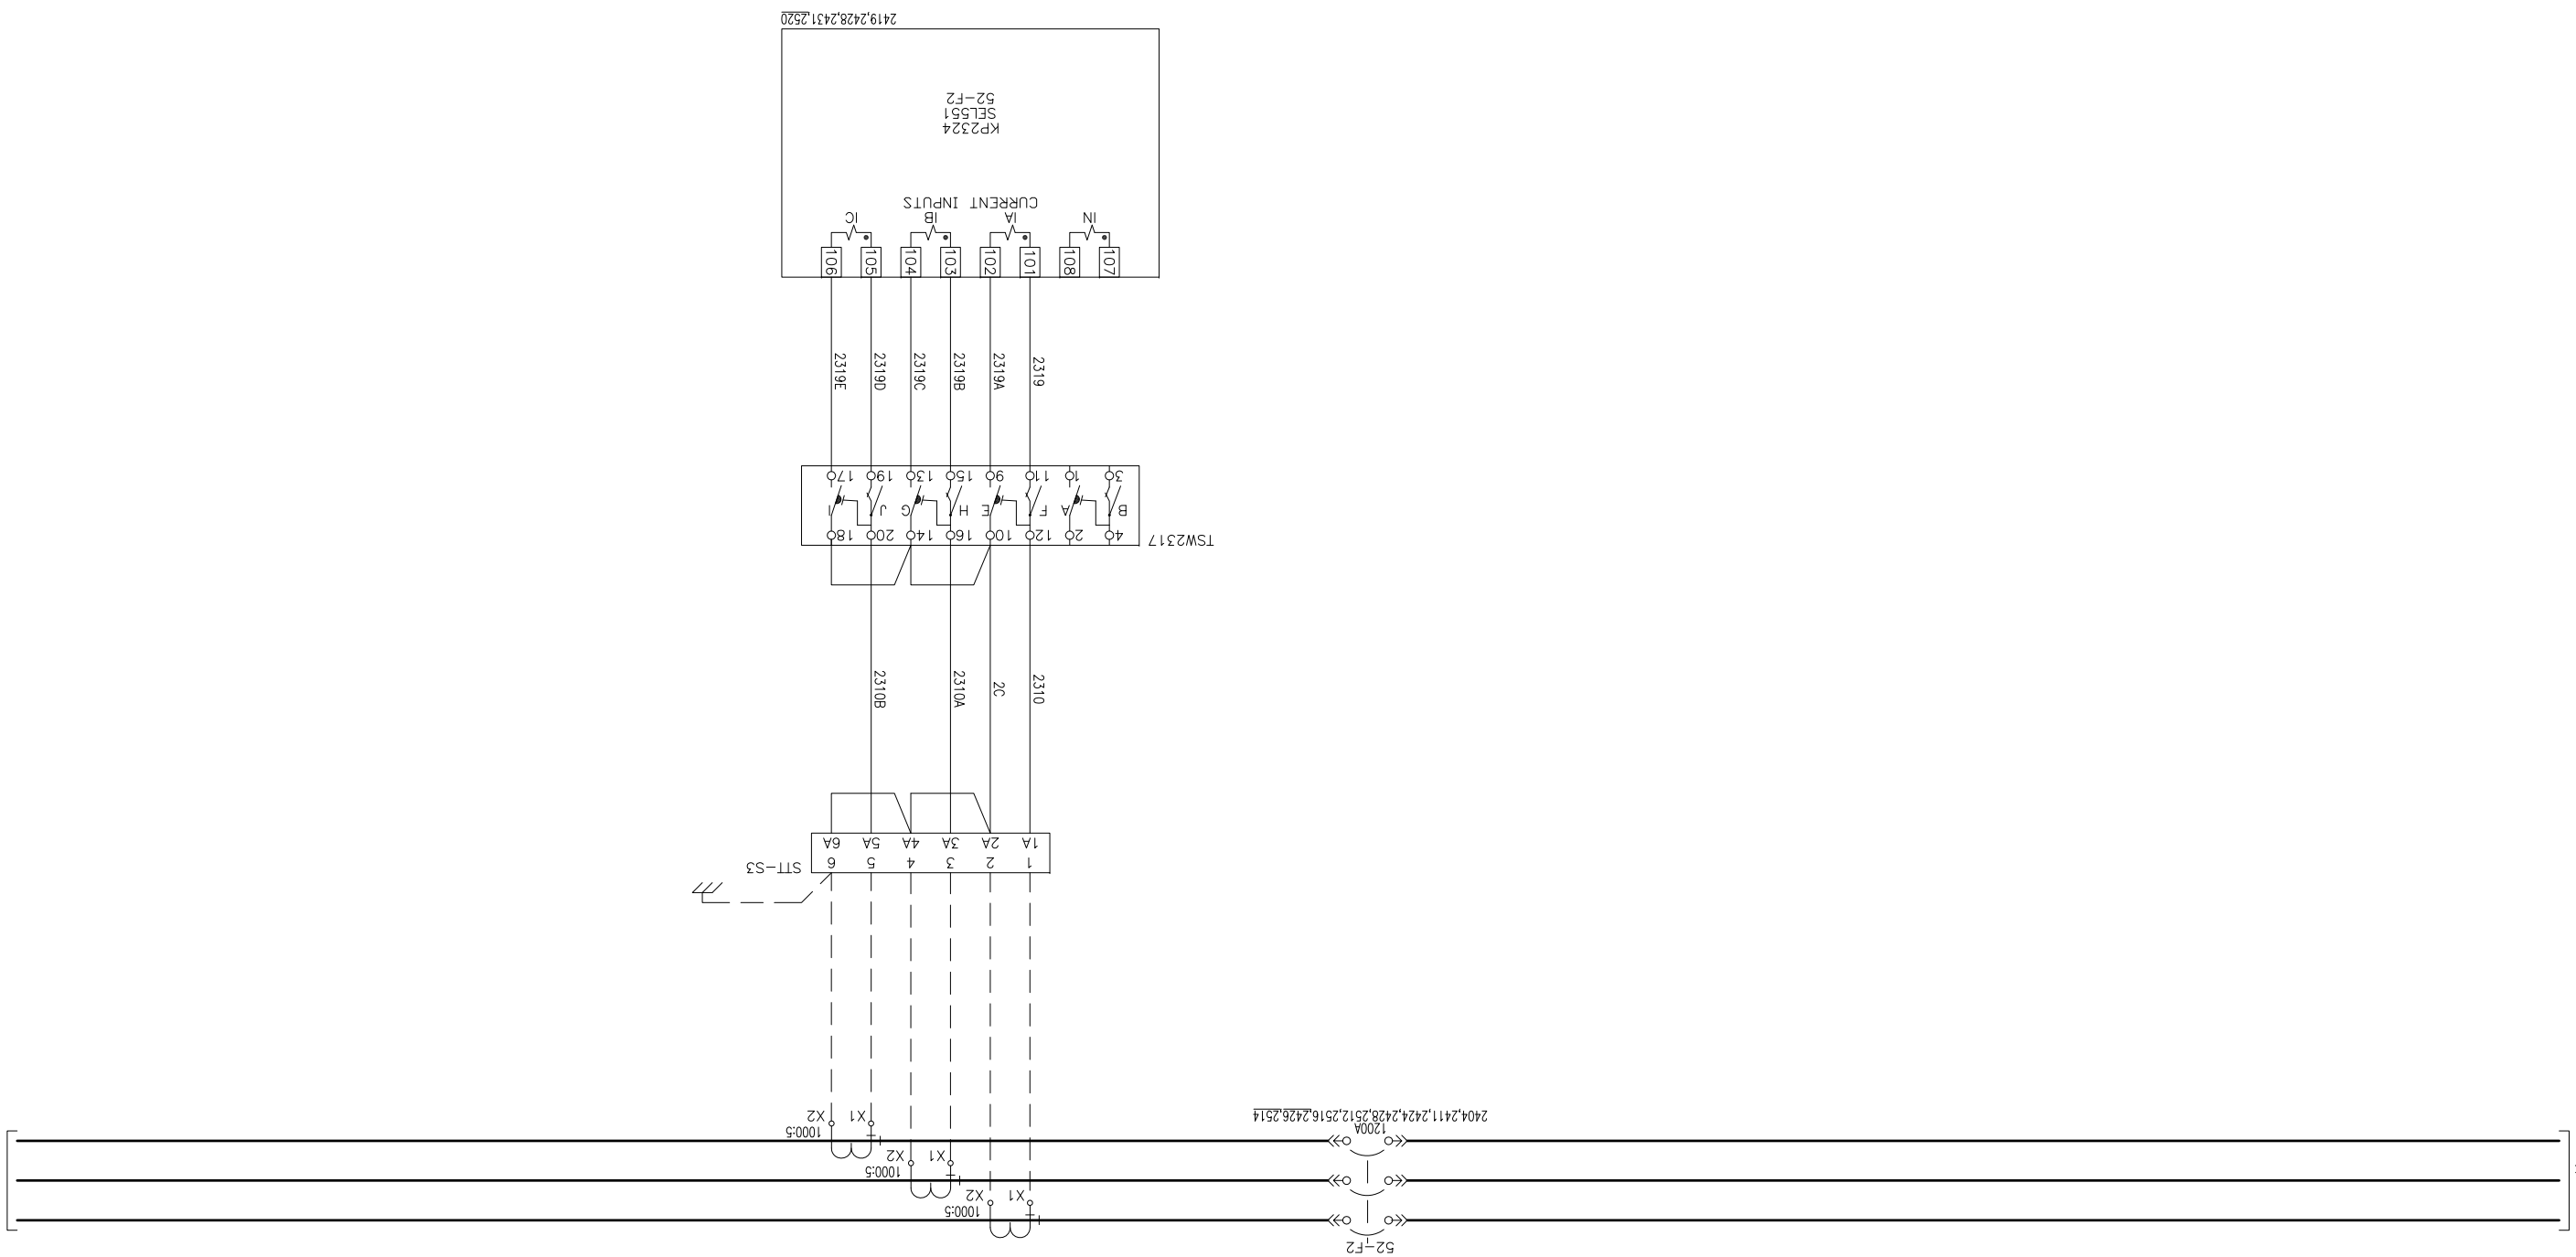

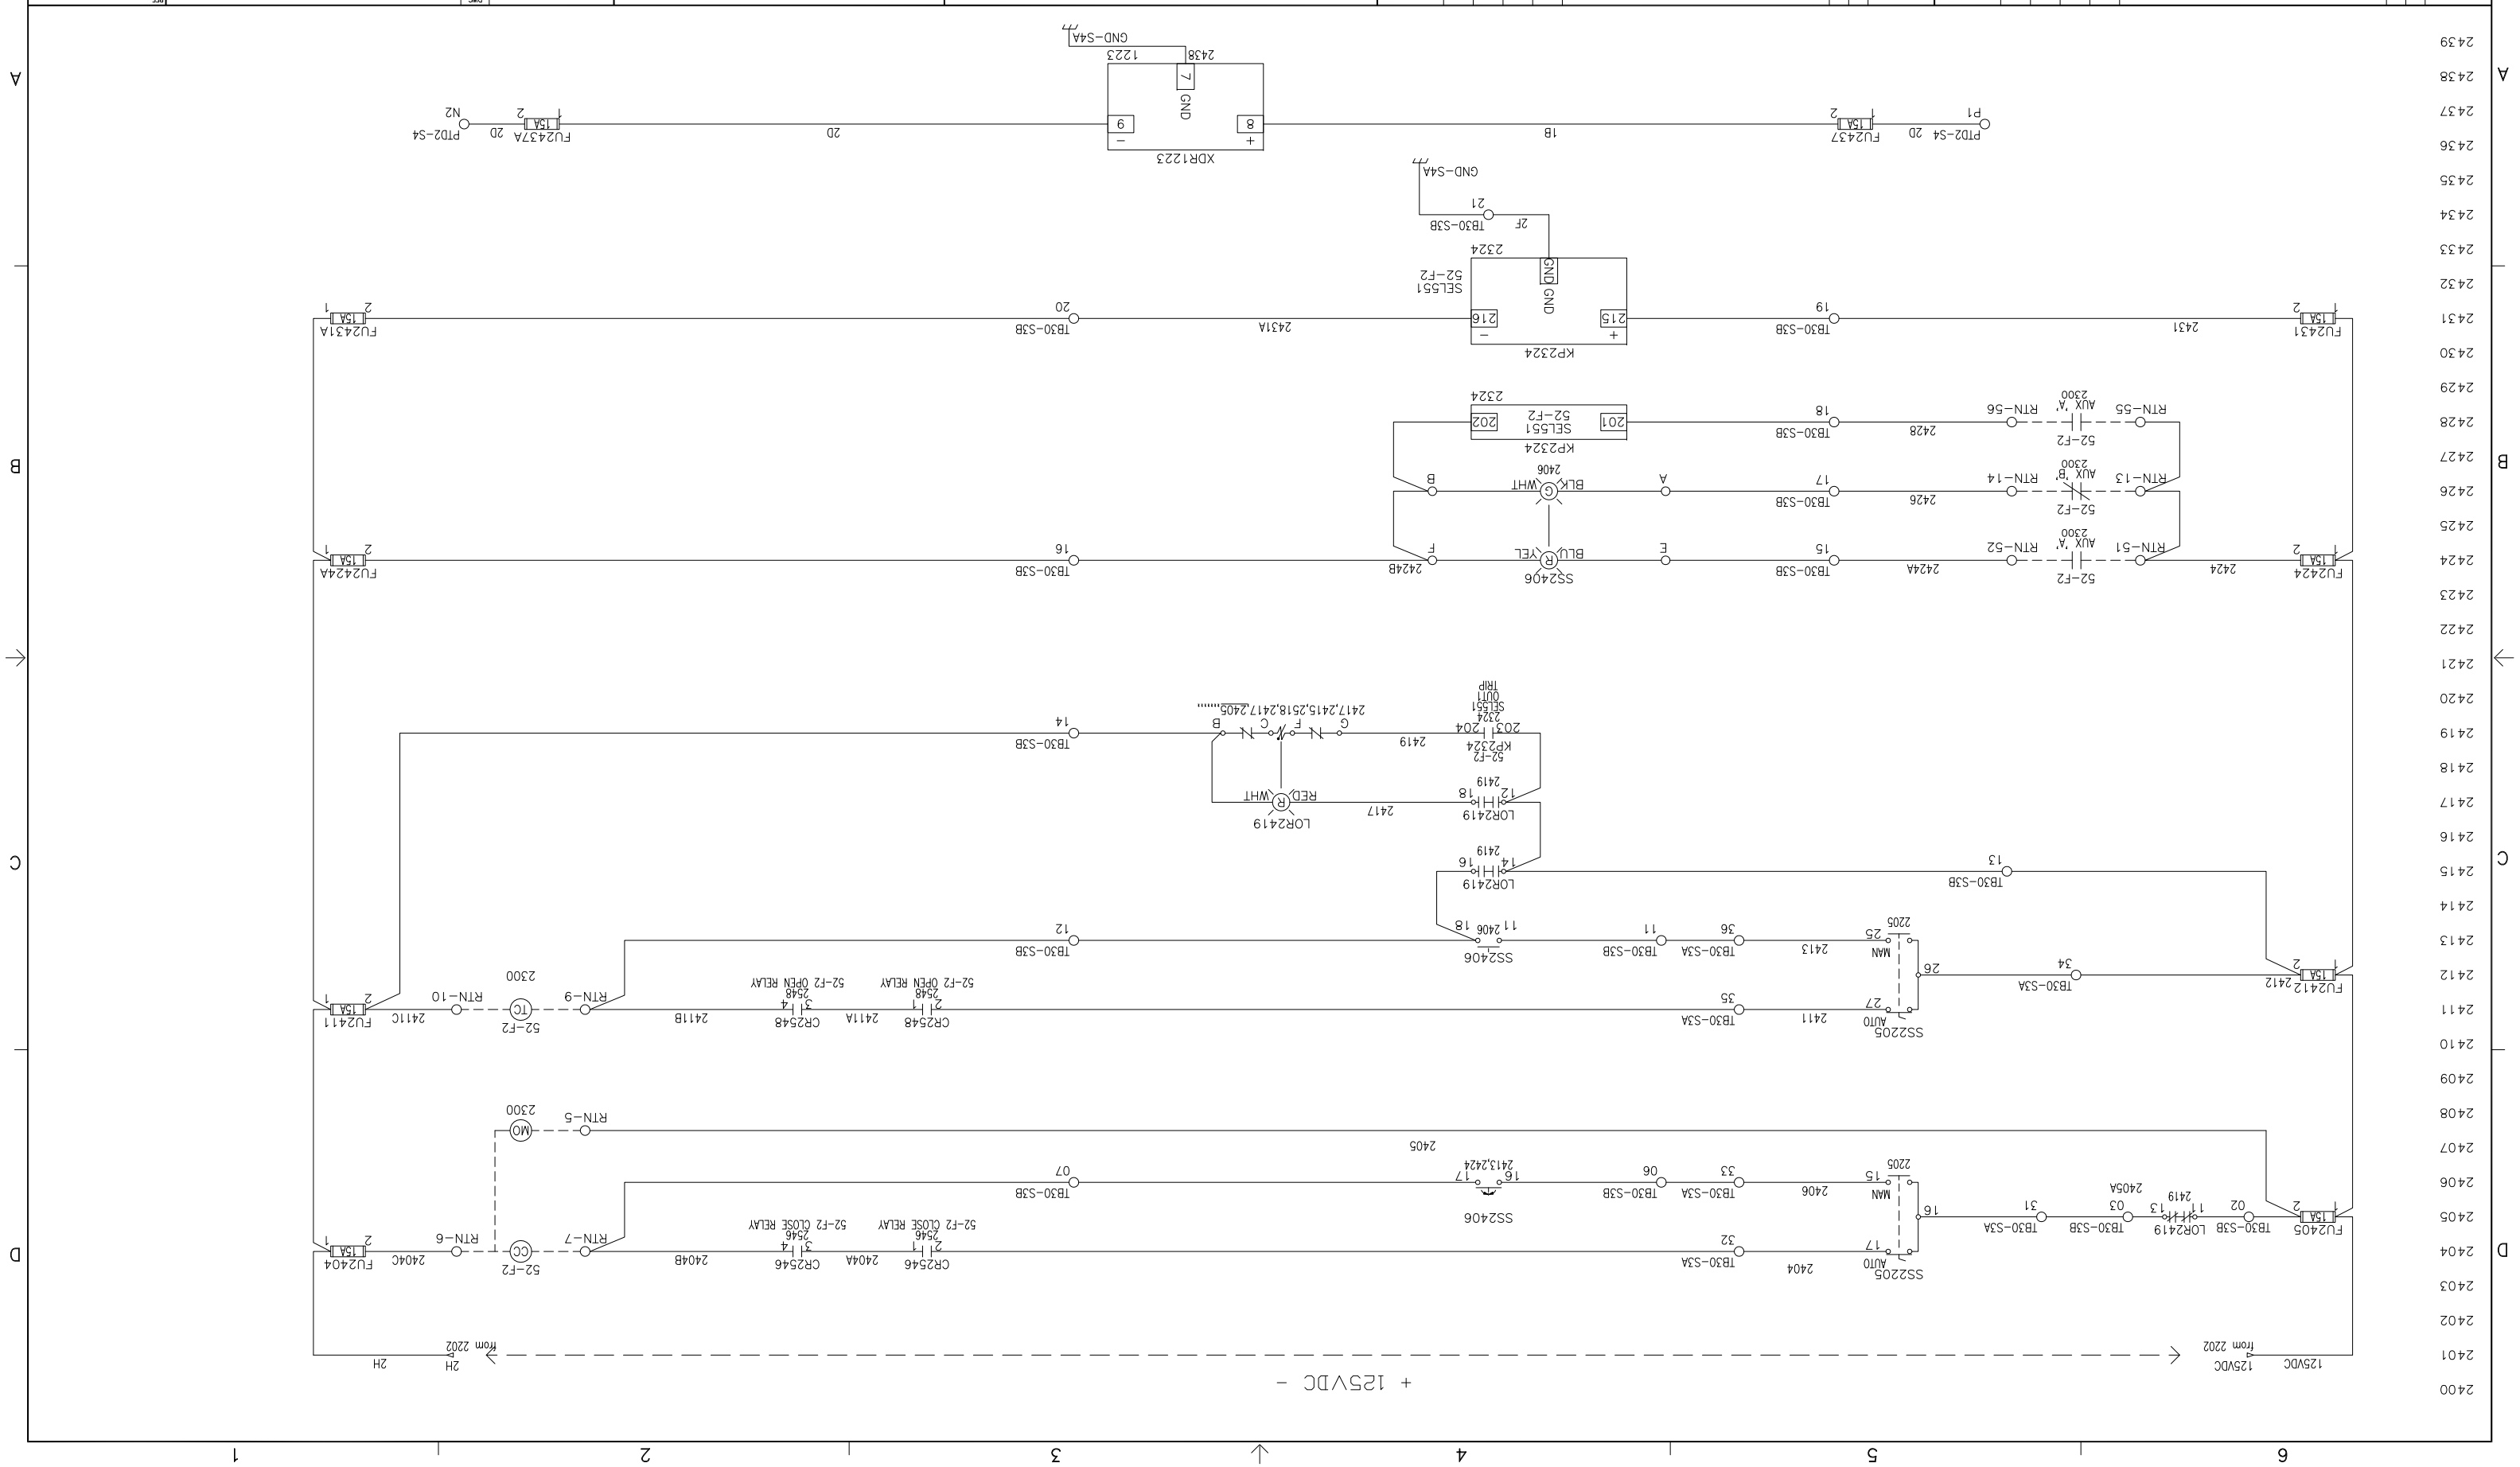
+ 125VDC -
125VDC
from 2202
2H
from 2202
2H
FU2405
FU2412
FU2411
FU2404
FU2424
FU2437
FU2431
FU2424A
FU2437A
FU2431A
FU2411C
SS2205
SS2406
CR2546
CR2548
CR2546
CR2548
LOR2419
KP2324
SEL551
52-F2
TB30-53B
TB30-53A
RTN-5
RTN-6
RTN-7
RTN-9
RTN-10
RTN-51
RTN-52
RTN-55
RTN-56
RTN-13
RTN-14
PTD2-S4
XDR1223
GND-S4A
SS2406
LOR2419
SS2406
LOR2419
SS2205
SS2406
SS2406
SS2406

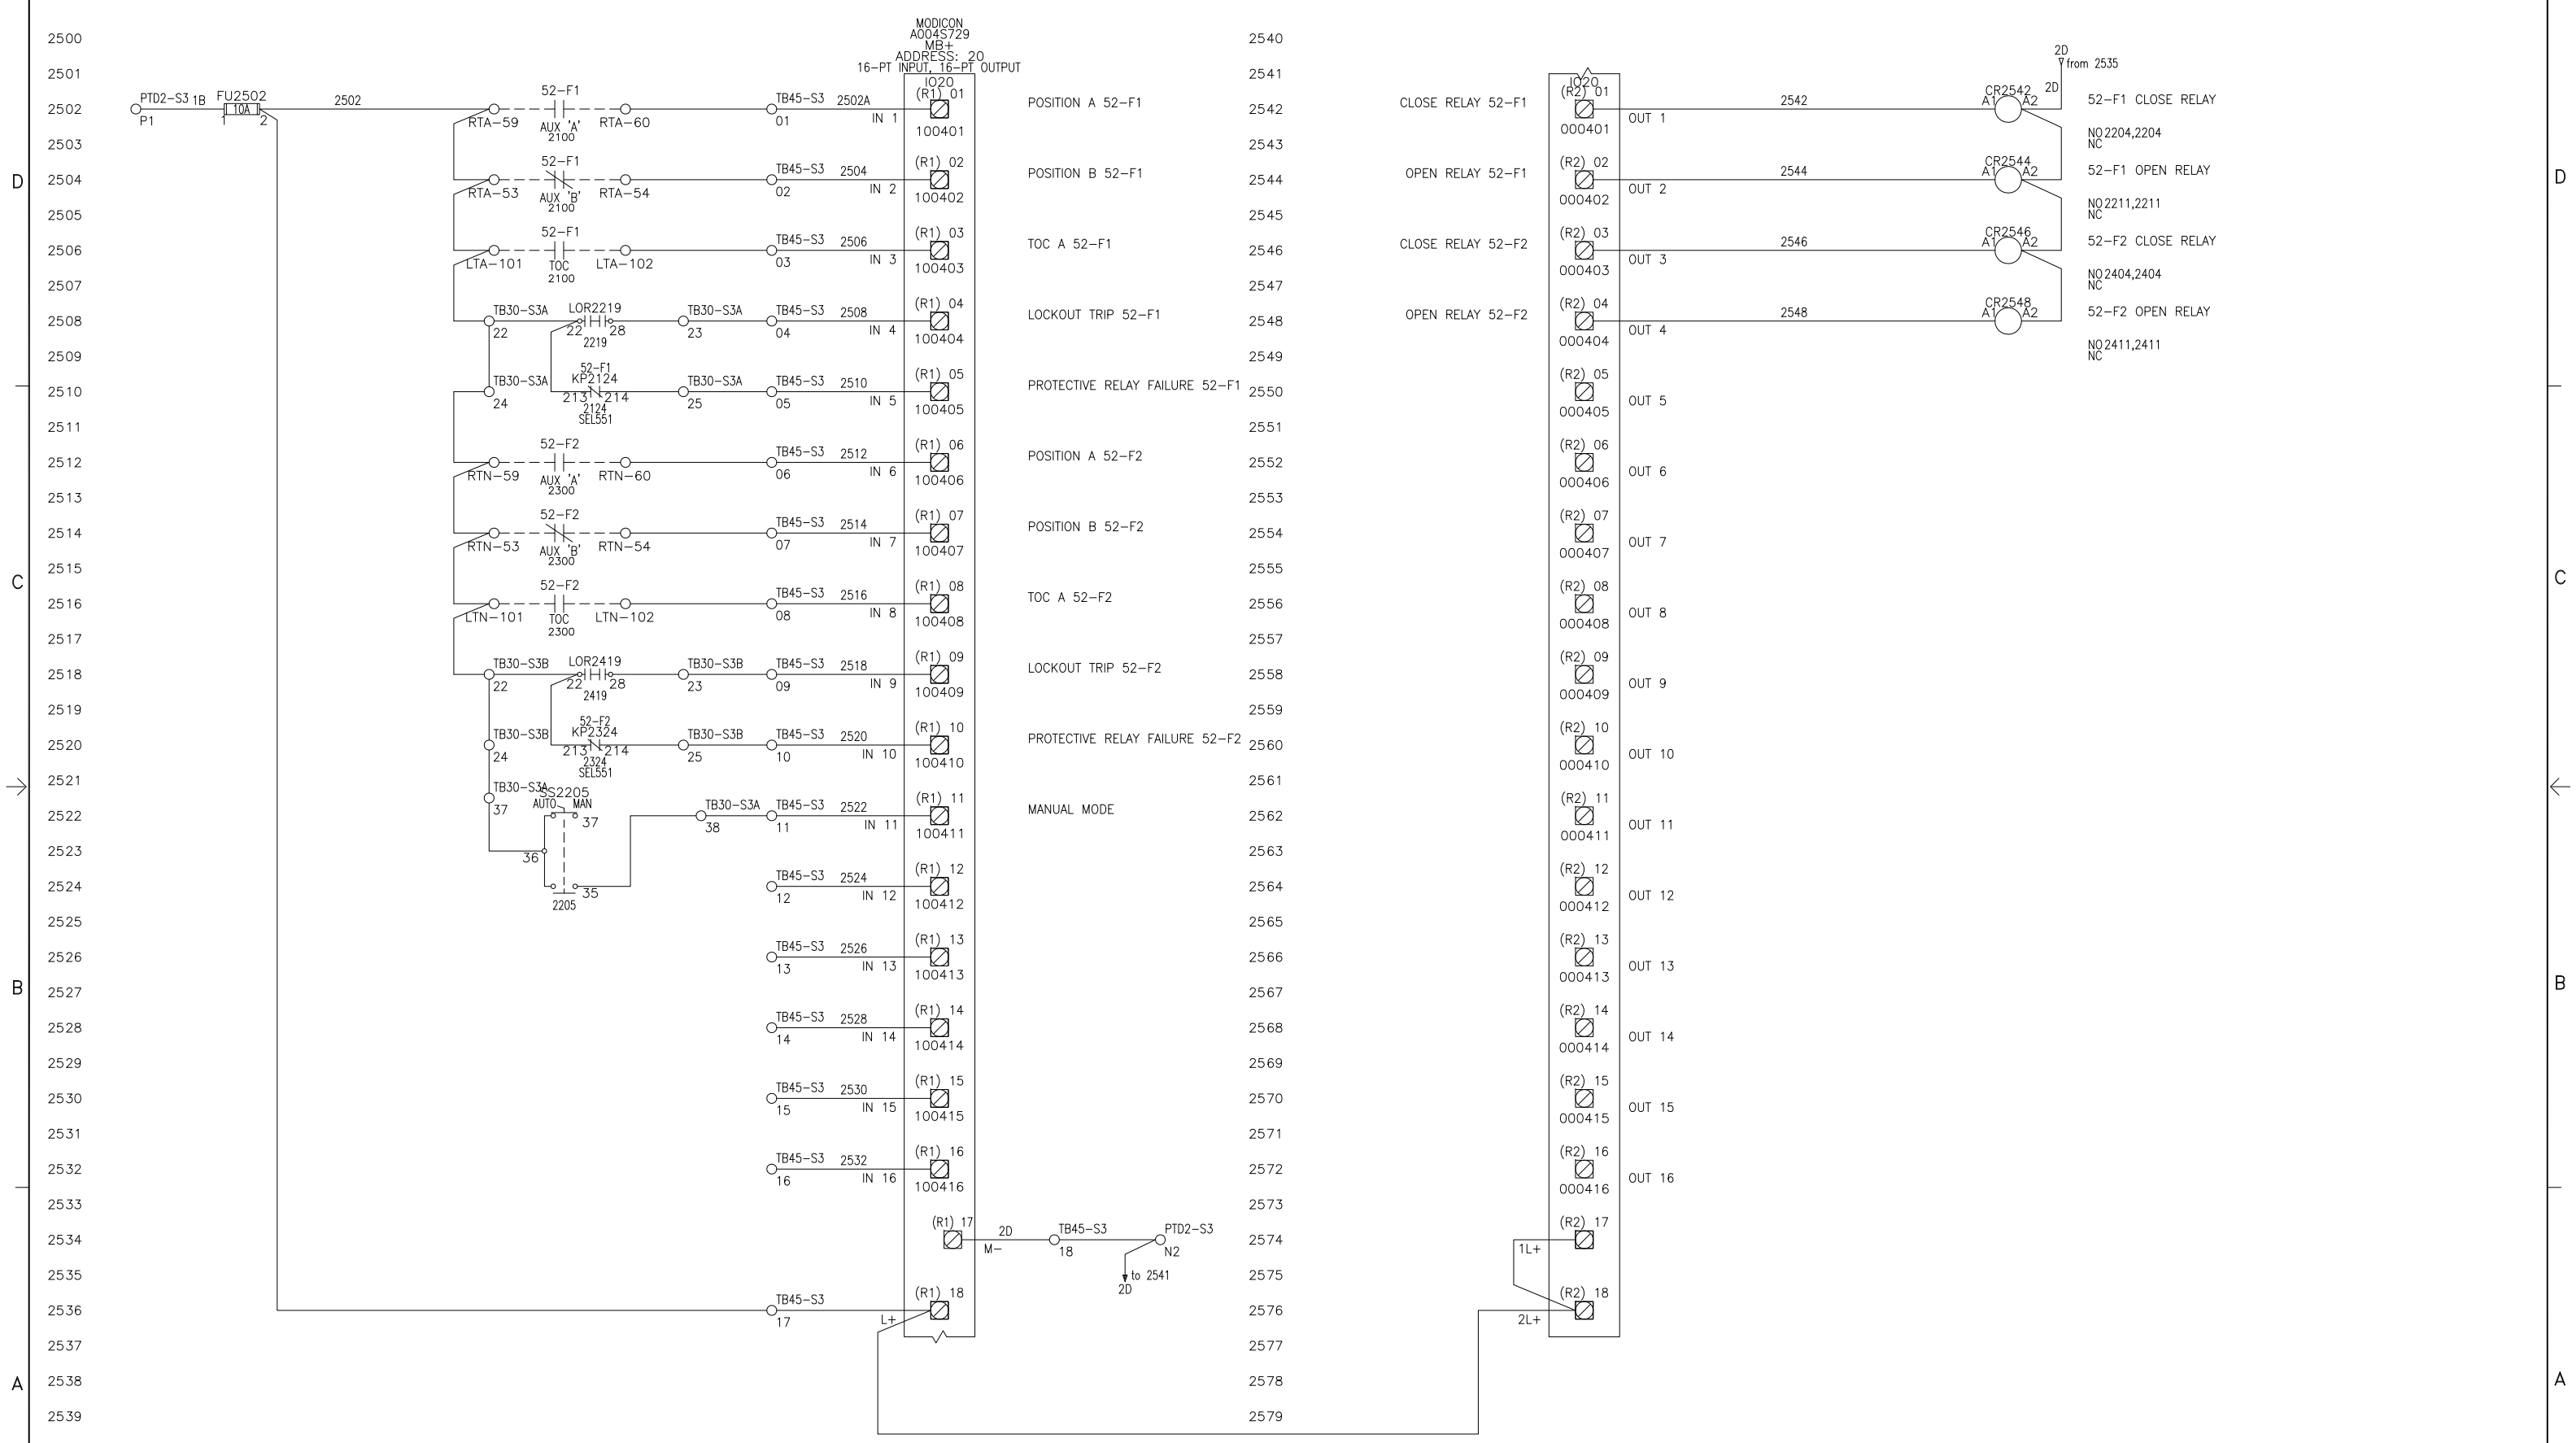

PC NO.	LTR	NO.	REVISION	ZONE	DRA	CHKR	APRV	DATE
PC104235	01	A	PRODUCTION RELEASE AS-BUILT	–	VS	VS	KT	06/17/10

PROJECT:
ARECIBO OBSERVATORY SWITCHGEAR
SG 52-F1 & F2 IO SCHEMATICS
DISTRIBUTOR:
CUMMINS CARIBBEAN
7071681

DO NOT SCALE PRINT

ANG TOL | DRAWN TO SCALE OF

AUTOCAD DWG

SIM TO | COPIED FROM | THREE ANGLE PROJECTION

THIS DOCUMENT IS THE PROPERTY OF CUMMINS POWER GENERATION. IT CONTAINS PROPRIETARY AND CONFIDENTIAL INFORMATION WHICH MUST NOT BE DUPLICATED, USED OR DISCLOSED OTHER THAN EXPRESSLY AUTHORIZED BY CUMMINS POWER GENERATION OR ITS REPRESENTATIVE

	NAME	DATE
DR	V.SAKLANI	06/17/10
CHKR ☐ MFG ☐	V. SIVAN	06/17/10
APPROVED	K.TWUMASI	06/17/10

FOR INTERPRETATION OF DIMENSIONING AND TOLERANCING, SEE ANSI Y14.5M-1982

MODEL FIRST USED ON: PCIL2004R-772F

SITE CODE: PGA

PART NO. | DWG SIZE | DESCRIPTION OF MATERIAL | REF DES

CUMMINS POWER GENERATION
1400 73rd AVE NE
MINNEAPOLIS, MN 55432

TITLE: WD-SCHEMATISC

DWG NO. A030S865 | SHEET 25 of 61 | DWG SIZE D

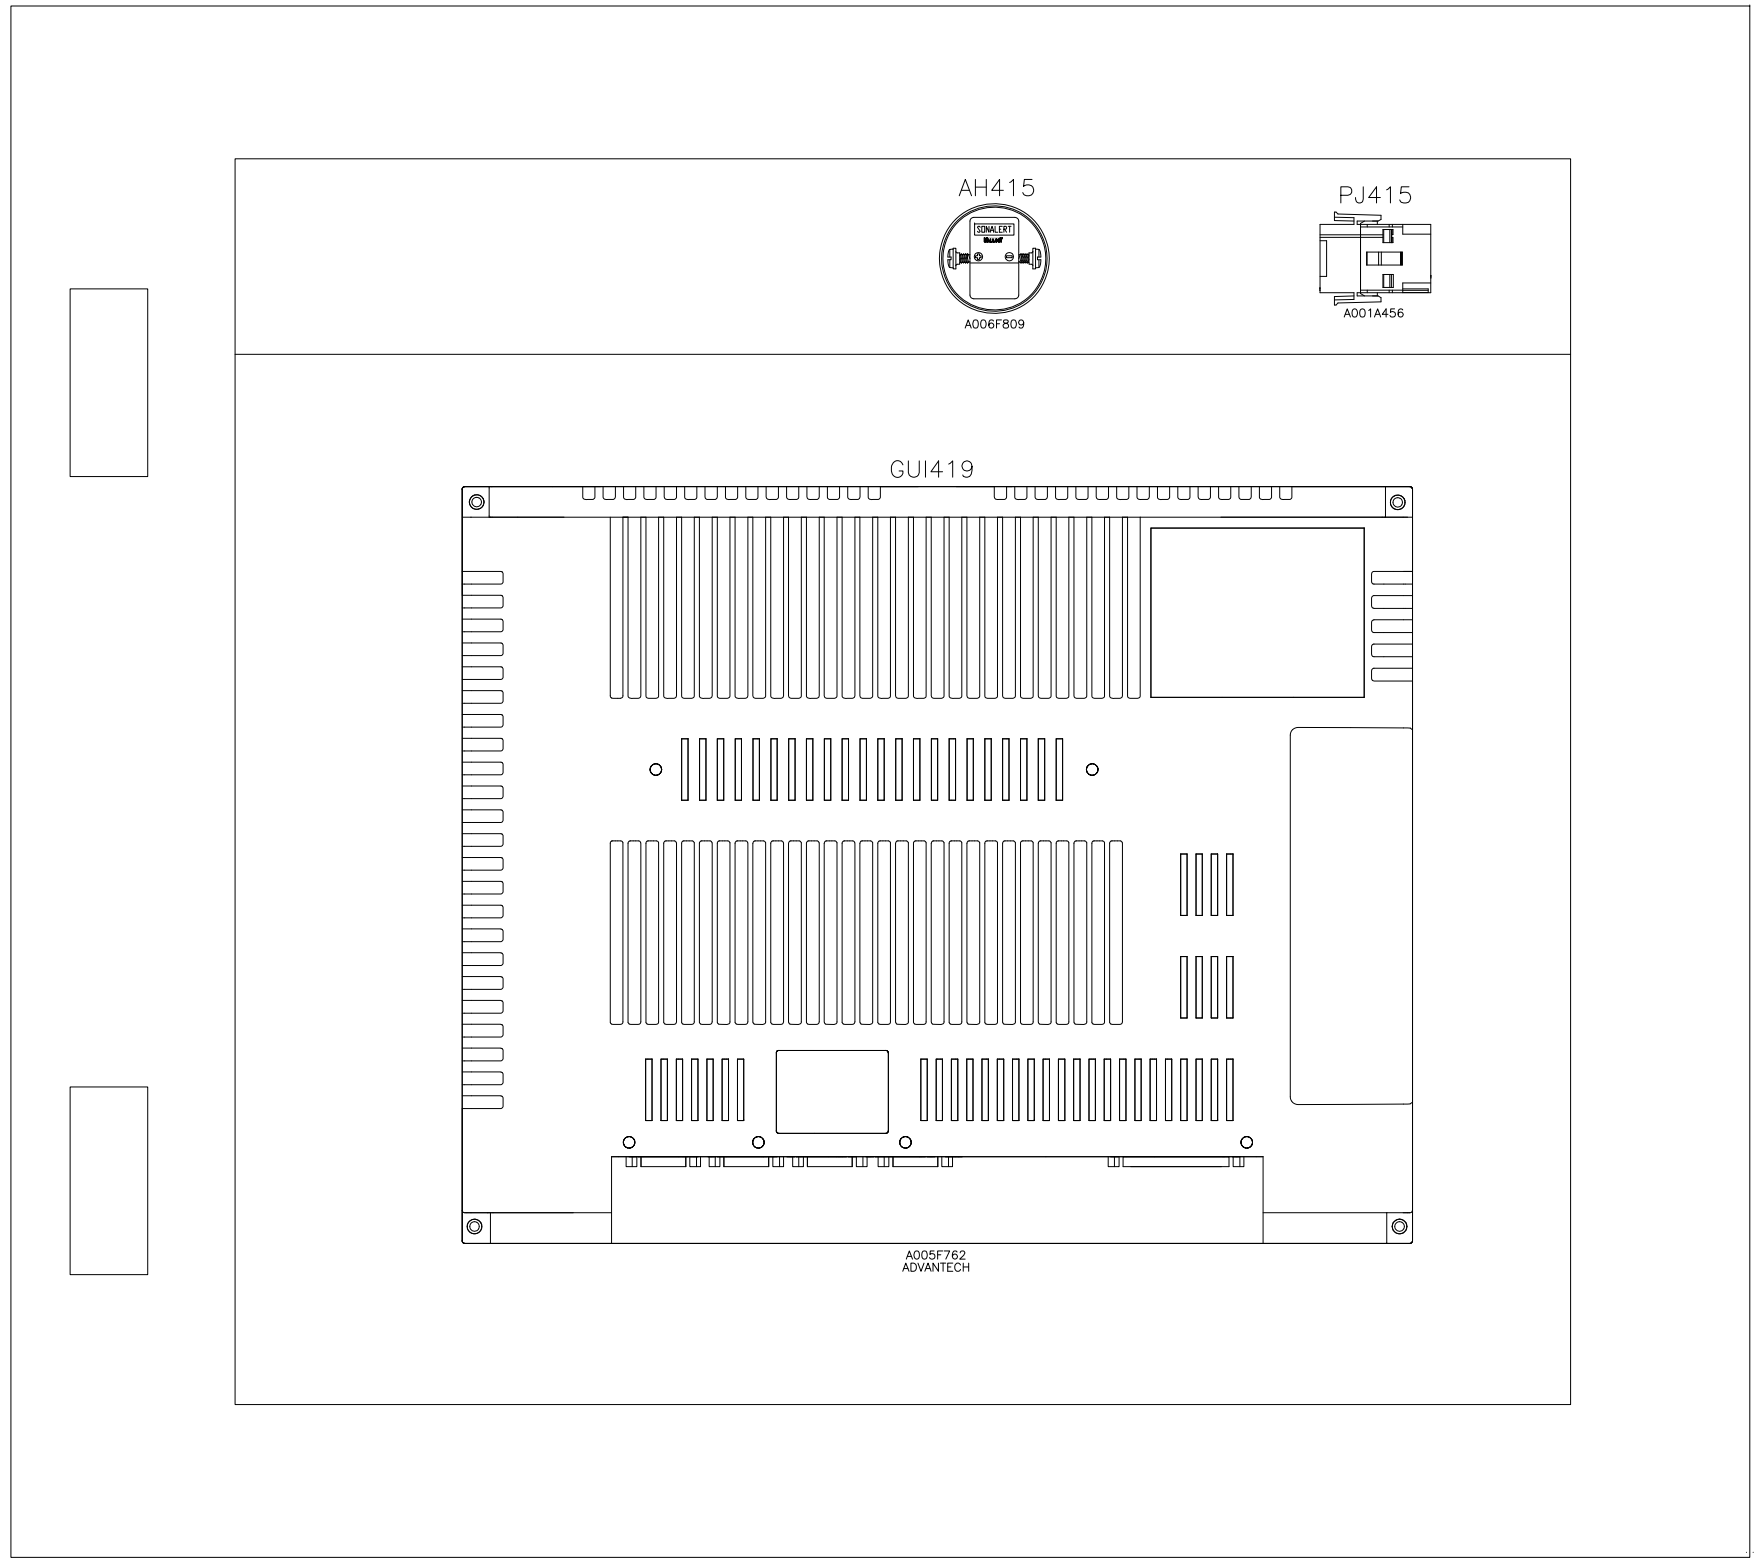

REAR DOOR VIEW

PC NO.	LTR	NO.	REVISION	ZONE	DRA	CHKR	APRV	DATE
PC104235	01	A	PRODUCTION RELEASE AS-BUILT	–	VS	VS	KT	06/17/10

PROJECT:
ARECIBO OBSERVATORY SWITCHGEAR
DMC DOOR PANEL LAYOUT
DISTRIBUTOR:
CUMMINS CARIBBEAN
7071681

DO NOT SCALE PRINT

ANG TOL | DRAWN TO SCALE OF

AUTOCAD DWG

SIM TO | COPIED FROM | THREE ANGLE PROJECTION

THIS DOCUMENT IS THE PROPERTY OF CUMMINS POWER GENERATION. IT CONTAINS PROPRIETARY AND CONFIDENTIAL INFORMATION WHICH MUST NOT BE REPRODUCED, USED OR DISCLOSED OTHER THAN EXPRESSLY AUTHORIZED BY CUMMINS POWER GENERATION OR ITS REPRESENTATIVE

PART NO.	DWG SIZE	DESCRIPTION OF MATERIAL	REF DES

	NAME	DATE
DR	V.SAKLANI	06/17/10
CHKR ☐ MFG ☐	V. SIVAN	06/17/10
APPROVED	K.TWUMASI	06/17/10

FOR INTERPRETATION OF DIMENSIONING AND TOLERANCING, SEE ANSI Y14.5M–1982

MODEL FIRST USED ON PCIL2004R–772F

SITE CODE PGA

CUMMINS POWER GENERATION
1400 73rd AVE. NE
MINNEAPOLIS, MN 55432

TITLE WD–SCHEMATISC

DWG NO. A030S865 | SHEET 26 OF 61 | DWG SIZE D

TAGS	QTY	SUB	CATALOG	CPG LEGACY	MFG	DESCRIPTION
AH415	1		A006F809	0333-0133	MALLORY	SOUND UNIT - 2800 CPS SOUND FREQUENCY SOUND UNIT 6-28 VDC 3-14 mA SC628
PJ415	1	*1	A001A456	0323-1333	AMP	CONNECTOR HOUSING - 4 SOCKET, FEMALE HOUSING 4 MATING PLUG: 0323-1292 1-480703-0
		*1	A005K700	0323-1292	AMP	CONNECTOR HOUSING - 4 SOCKET, MALE HOUSING 4 MATING PLUG: 0323-1333 1-480702-0
		*2	A005H219	0323-1199	AMP	CONNECTOR CONTACT - PIN, 20 - 14 AWG CONTACT 1 MATING SOCKET: 0323-1200 350700-1
		*2	A006J256	0323-1200	AMP	CONNECTOR CONTACT - SOCKET, 20 - 14 AWG CONTACT 1 MATING PIN: 0323-1199 350551-1
GUI419	1		A005F762	0300-6361	ADVANTECH	OPERATOR INTERFACE TOUCHSCREEN 24VDC CE, 2 SERIAL PORTS 15" LCD DISPLAY WEBOIT-1570-CE

PC NO.	LTR	NO.	REVISION	ZONE	DRA	CHKR	APRV	DATE
PC104235	01	A	PRODUCTION RELEASE AS-BUILT	-	VS	VS	KT	06/17/10

PROJECT:
ARECIBO OBSERVATORY SWITCHGEAR
DMC DOOR PANEL LAYOUT BOM
DISTRIBUTOR:
CUMMINS CARIBBEAN
7071681

DO NOT SCALE PRINT

ANG TOL | DRAWN TO SCALE OF

AUTOCAD DWG

SIM TO | COPIED FROM | THREE ANGLE PROJECTION

THIS DOCUMENT IS THE PROPERTY OF CUMMINS POWER GENERATION. IT CONTAINS PROPRIETARY AND CONFIDENTIAL INFORMATION WHICH MUST NOT BE DUPLICATED, USED OR DISCLOSED OTHER THAN EXPRESSLY AUTHORIZED BY CUMMINS POWER GENERATION OR ITS REPRESENTATIVE

PART NO.	DWG SIZE	DESCRIPTION OF MATERIAL	REF DES

	NAME	DATE
DR	V.SAKLANI	06/17/10
CHKR ☐ MFG ☐	V. SIVAN	06/17/10
APPROVED	K.TWUMASI	06/17/10

FOR INTERPRETATION OF DIMENSIONING AND TOLERANCING, SEE ANSI Y14.5M-1982

MODEL FIRST USED ON PCIL2004R-772F

SITE CODE PGA

CUMMINS POWER GENERATION
1400 73rd AVE NE
MINNEAPOLIS, MN 55432

TITLE WD-SCHEMATISC

DWG NO. A030S865 | SHEET 27 OF 61 | DWG SIZE D

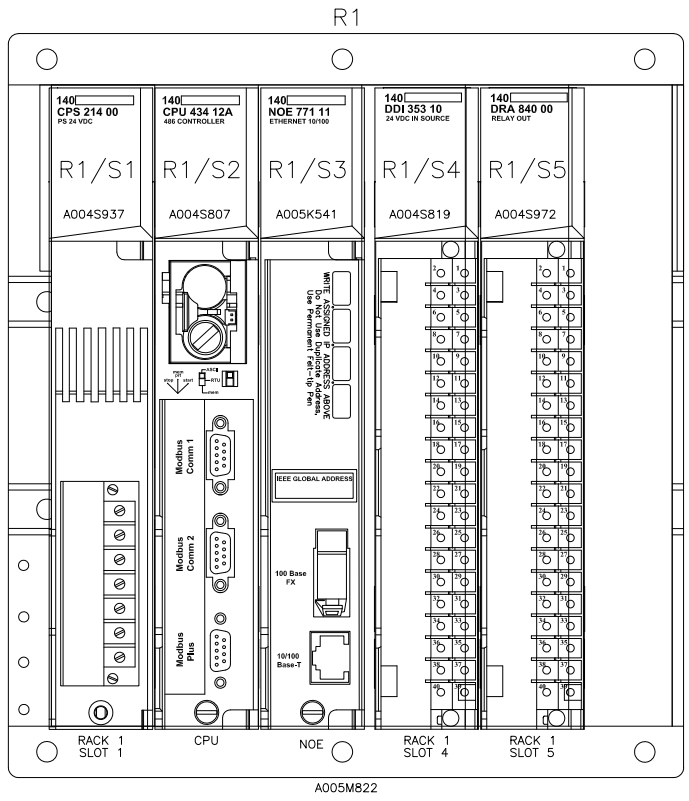

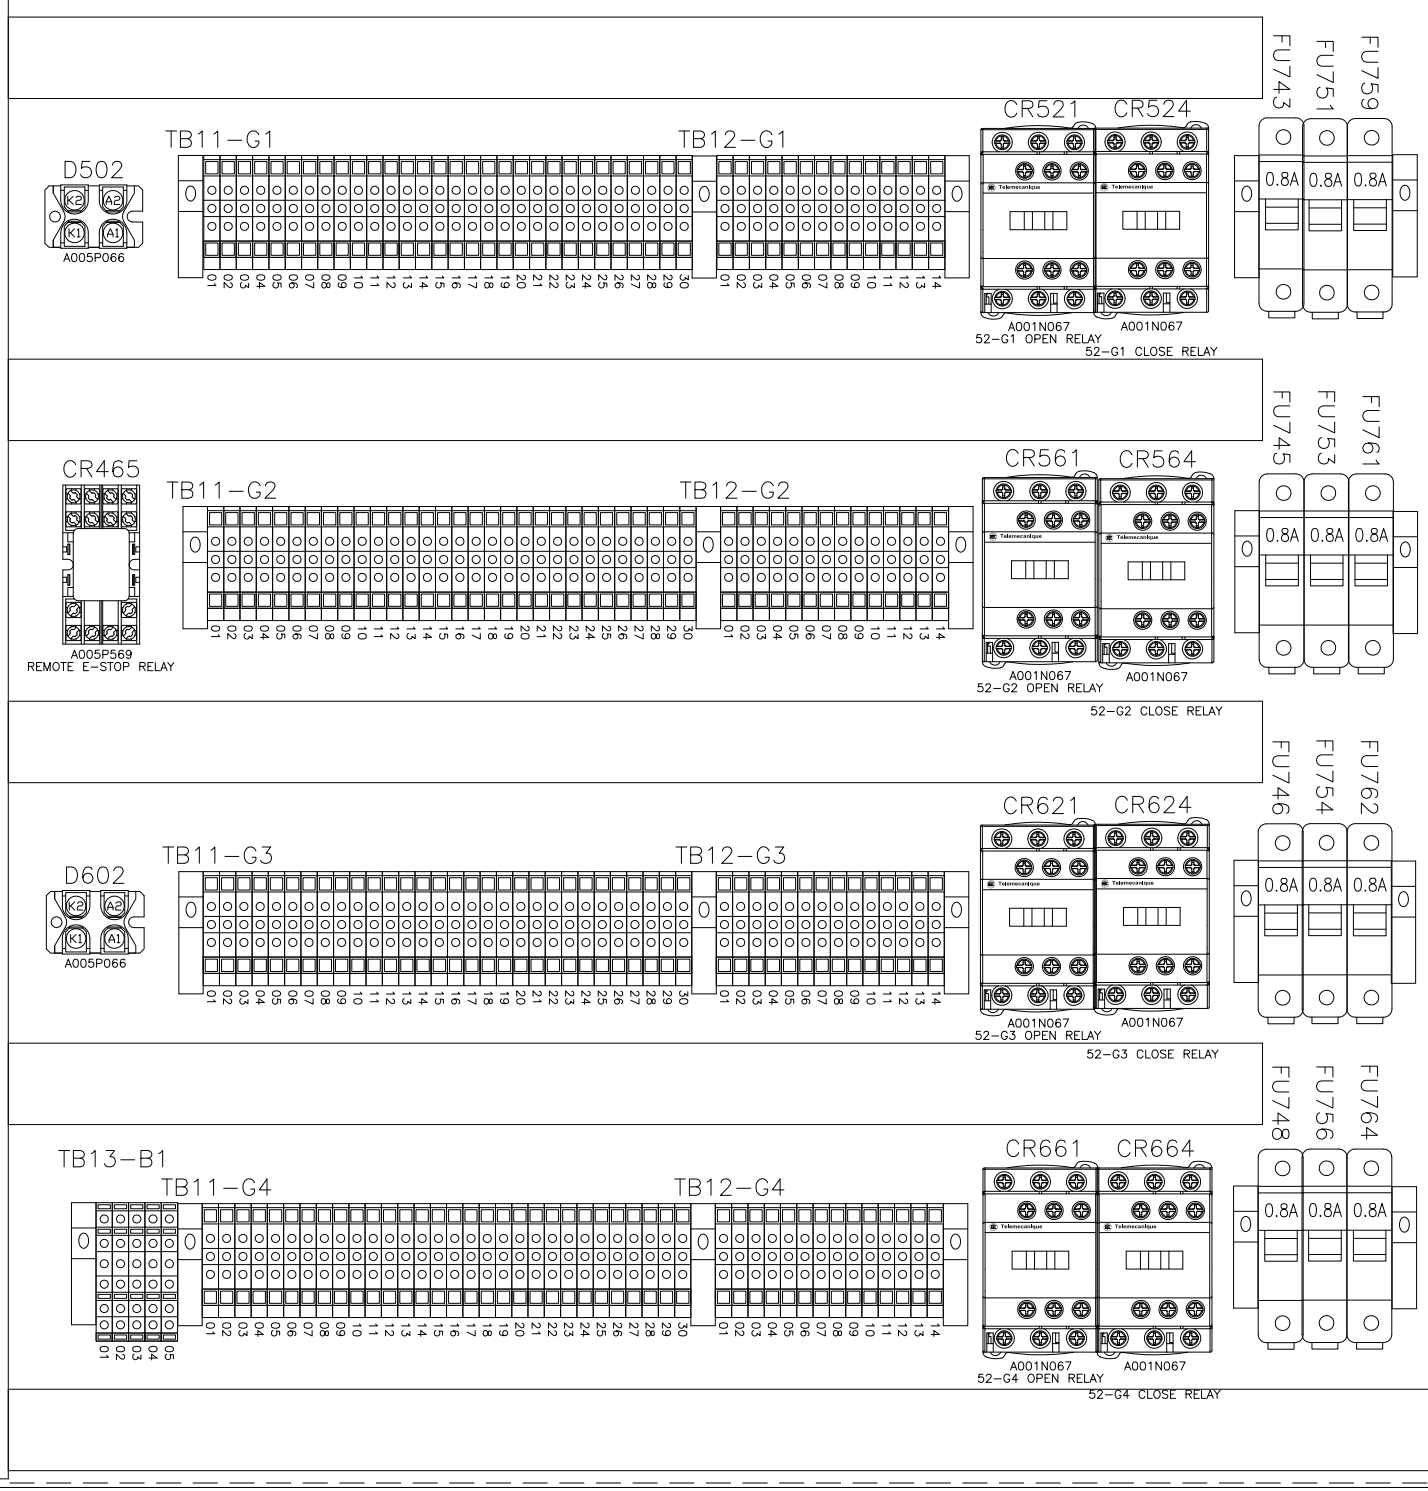

REV. NO.	LTR	REVISION	ZONE	DRA	CHKR	APRV	DATE
PC104235	01	A PRODUCTION RELEASE AS-BUILT	–	VS	VS	KT	06/17/10

PROJECT:
ARECIBO OBSERVATORY SWITCHGEAR
DMC UPR REAR PANEL LAYOUT
DISTRIBUTOR:
CUMMINS CARIBBEAN
7071681

DO NOT SCALE PRINT

ANG TOL
DRAWN TO SCALE OF
AUTOCAD DWG

SIM TO
COPIED FROM
THREE-ANGLE PROJECTION

THIS DOCUMENT IS THE PROPERTY OF CUMMINS POWER GENERATION AND CONTAINS PROPRIETARY AND CONFIDENTIAL INFORMATION WHICH MUST NOT BE REPRODUCED OR TRANSMITTED IN WHOLE OR IN PART, EXPRESSLY AUTHORIZED BY CUMMINS POWER GENERATION OR ITS REPRESENTATIVE

	NAME	DATE
DR	V.SAKLANI	06/17/10
CHKR MFG.	V. SIVAN	06/17/10
APPROVED	K.TWUMASI	06/17/10

FOR INTERPRETATION OF DIMENSIONS AND TOLERANCES SEE ANSI Y14.5M-1982

MODEL FIRST USED ON PCIL2004R-772F

PART NO.
DWG SIZE
DESCRIPTION OF MATERIAL
REF DES

SITE CODE PGA

CUMMINS POWER GENERATION
1400 73RD AVE. N.E.
MINNEAPOLIS, MN 55432

TITLE WD-SCHEMATISC

DWG NO. A030S865

SHEET 28 OF 61

DWG SIZE D

TAGS	QTY	SUB	CATALOG	CPG LEGACY	MFG	DESCRIPTION
CR465	1	*1	A005P569	0307-1821	P&B	RELAY-CONTROL, 24VDC CONTROL RELAY 24 VDC 4 C FORM, 1A, 30VDC / 120 VAC GOLD OVERLAY SILVER CONTACTS KHAU-17D16-24
		*1	A006J313	0323-1410-02	IDEC	SOCKET-RELAY SOCKET 14 PIN SY45-05 & SY4S-51F1
		*1	A006L639	0307-1673	P&B	RELAY HOLD DOWN SPRING ACCESSORY USE WITH 307-1821 RELAY AND BASE 20C217
CR521 CR524 CR561 CR564 CR621 CR624 CR661 CR664	8		A001N067	0307-2900-05	TELEMECHANIQUE	CONTACTOR-LOW PWR COIL, 24VDC CONTACTOR 24 VDC 4 NO,1 NC, 18A/32A LC1D18BL
D502 D602	2		A005P066	0357-0150	MICROELECTRONIC	RECTIFIER- 30A, ULTRA FAST DIODE, POWER 50A, 200V 2 X 50A, 0.72V STTH10002TV1
	7		GENERIC		PANDUIT	
FU743 FU745 FU746 FU748 FU751 FU753 FU754 FU756 FU759 FU761 FU762 FU764	12	*1	A002K940	0321-0363-03	BUSSMANN	FUSE - CLASS CC TIME DELAY, CURRENT LIMITING 8/10AMPS 600VAC LP-CC-8/10 USE WITH FUSE BLOCK 0321-0344
		*1	A002L124	0321-0344	GOULD	1 POLE FUSE BLOCK - CLASS CC FUSE HOLDER 1/10-30AMPS 600VAC PRESSURE PLATE TERM USCC1 USE WITH FUSES LP-CC*
R1/S2	1		A004S807	0326-0160-03	MODICON	QUANTUM CPU QUANTUM PROCESSOR 2M, 486 DX2, 2 MODBUS, 1 MB+, 64K USER LOGIC CO-PROCESSOR INTEGRATED 140CPU43412A
R1/S4	1	*1	A004S819	0326-0185	MODICON	DISCRETE DC INPUT QUANTUM DISCRETE INPUT 24 VDC DISCRETE, 32 POINT, 4 GROUPS, SOURCE 140DDI35310
		*1	A006Z406	0332-3523	MODICON	QUANTUM TERMINAL STRIP QUANTUM TERMINAL STRIP 40 TERMINALS 20 AWG MINIMUM WIRE SIZE 140XTS00200
R1/S1	1		A004S937	0326-0161-02	MODICON	POWER SUPPLY QUANTUM POWER SUPPLY 24 VDC, 8A SUMMABLE 140CPS21400
R1/S5	1	*1	A004S972	0326-0166	MODICON	DISCRETE RELAY OUTPUT QUANTUM DISCRETE OUTPUT 2A DISCRETE RELAY 16 POINT OUTPUT, NO 140DRA84000
		*1	A006Z406	0332-3523	MODICON	QUANTUM TERMINAL STRIP QUANTUM TERMINAL STRIP 40 TERMINALS 20 AWG MINIMUM WIRE SIZE 140XTS00200
R1/S3	1		A005K541	0300-5769	MODICON	ETHERNET TCP/IP AND MODBUS QUANTUM COMMUNICATION 10/100BASE-T ETHERNET (RJ-45) & 10BASE-FX ETHERNET (MT-RJ) FACTORY CAST, TWISTED PAIR & FIBER LINK, 1 CHANNEL 140NOE77111
R1	1		A005M822	0326-0172-04	MODICON	BACKPLANE QUANTUM BACKPLANE BACKPLANE, 6 SLOT, 265 MM, 10.4 IN 140XBP00600
TB13-B1	5		A006Z109	0332-3125-04	WEIDMULLER	TERMINAL BLOCK DOUBLE LEVEL 300V, 27A DOUBLE LEVEL, FEED THROUGH, WITH INTERNAL LINK 22-12 AWG 3636.6
TB11-G1 TB11-G2 TB11-G3 TB11-G4 TB12-G1 TB12-G2 TB12-G3 TB12-G4	176		A006Z117	0332-3125-01	WEIDMULLER	TERMINAL BLOCK SINGLE LEVEL 600V, 20A SINGLE LEVEL, FEED THROUGH 22-12 AWG 3804.6

PC NO.	LTR	NO.	REVISION	ZONE	DRA	CHKR	APRV	DATE
PC104235	01	A	PRODUCTION RELEASE AS-BUILT	–	VS	VS	KT	06/17/10

PROJECT:
ARECIBO OBSERVATORY SWITCHGEAR
DMC UPR REAR PANEL LAYOUT BOM
DISTRIBUTOR:
CUMMINS CARIBBEAN
7071681

DO NOT SCALE PRINT

ANG TOL | DRAWN TO SCALE OF

AUTOCAD DWG

SIM TO | COPIED FROM | THREE ANGLE PROJECTION

THIS DOCUMENT IS THE PROPERTY OF CUMMINS POWER GENERATION. IT CONTAINS PROPRIETARY AND CONFIDENTIAL INFORMATION WHICH MUST NOT BE DUPLICATED, USED OR DISCLOSED OTHER THAN EXPRESSLY AUTHORIZED BY CUMMINS POWER GENERATION OR ITS REPRESENTATIVE

PART NO.	DWG SIZE	DESCRIPTION OF MATERIAL	REF DES

	NAME	DATE
DR	V.SAKLANI	06/17/10
CHKR ☐ MFG ☐	V. SIVAN	06/17/10
APPROVED	K.TWUMASI	06/17/10

FOR INTERPRETATION OF DIMENSIONING AND TOLERANCING, SEE ANSI Y14.5M-1982

MODEL FIRST USED ON: PCIL2004R-772F

SITE CODE: PGA

CUMMINS POWER GENERATION
1400 73rd AVE.NE.
MINNEAPOLIS, MN 55432

TITLE: WD-SCHEMATISC

DWG NO. A030S865 | SHEET 29 OF 61 | DWG SIZE D

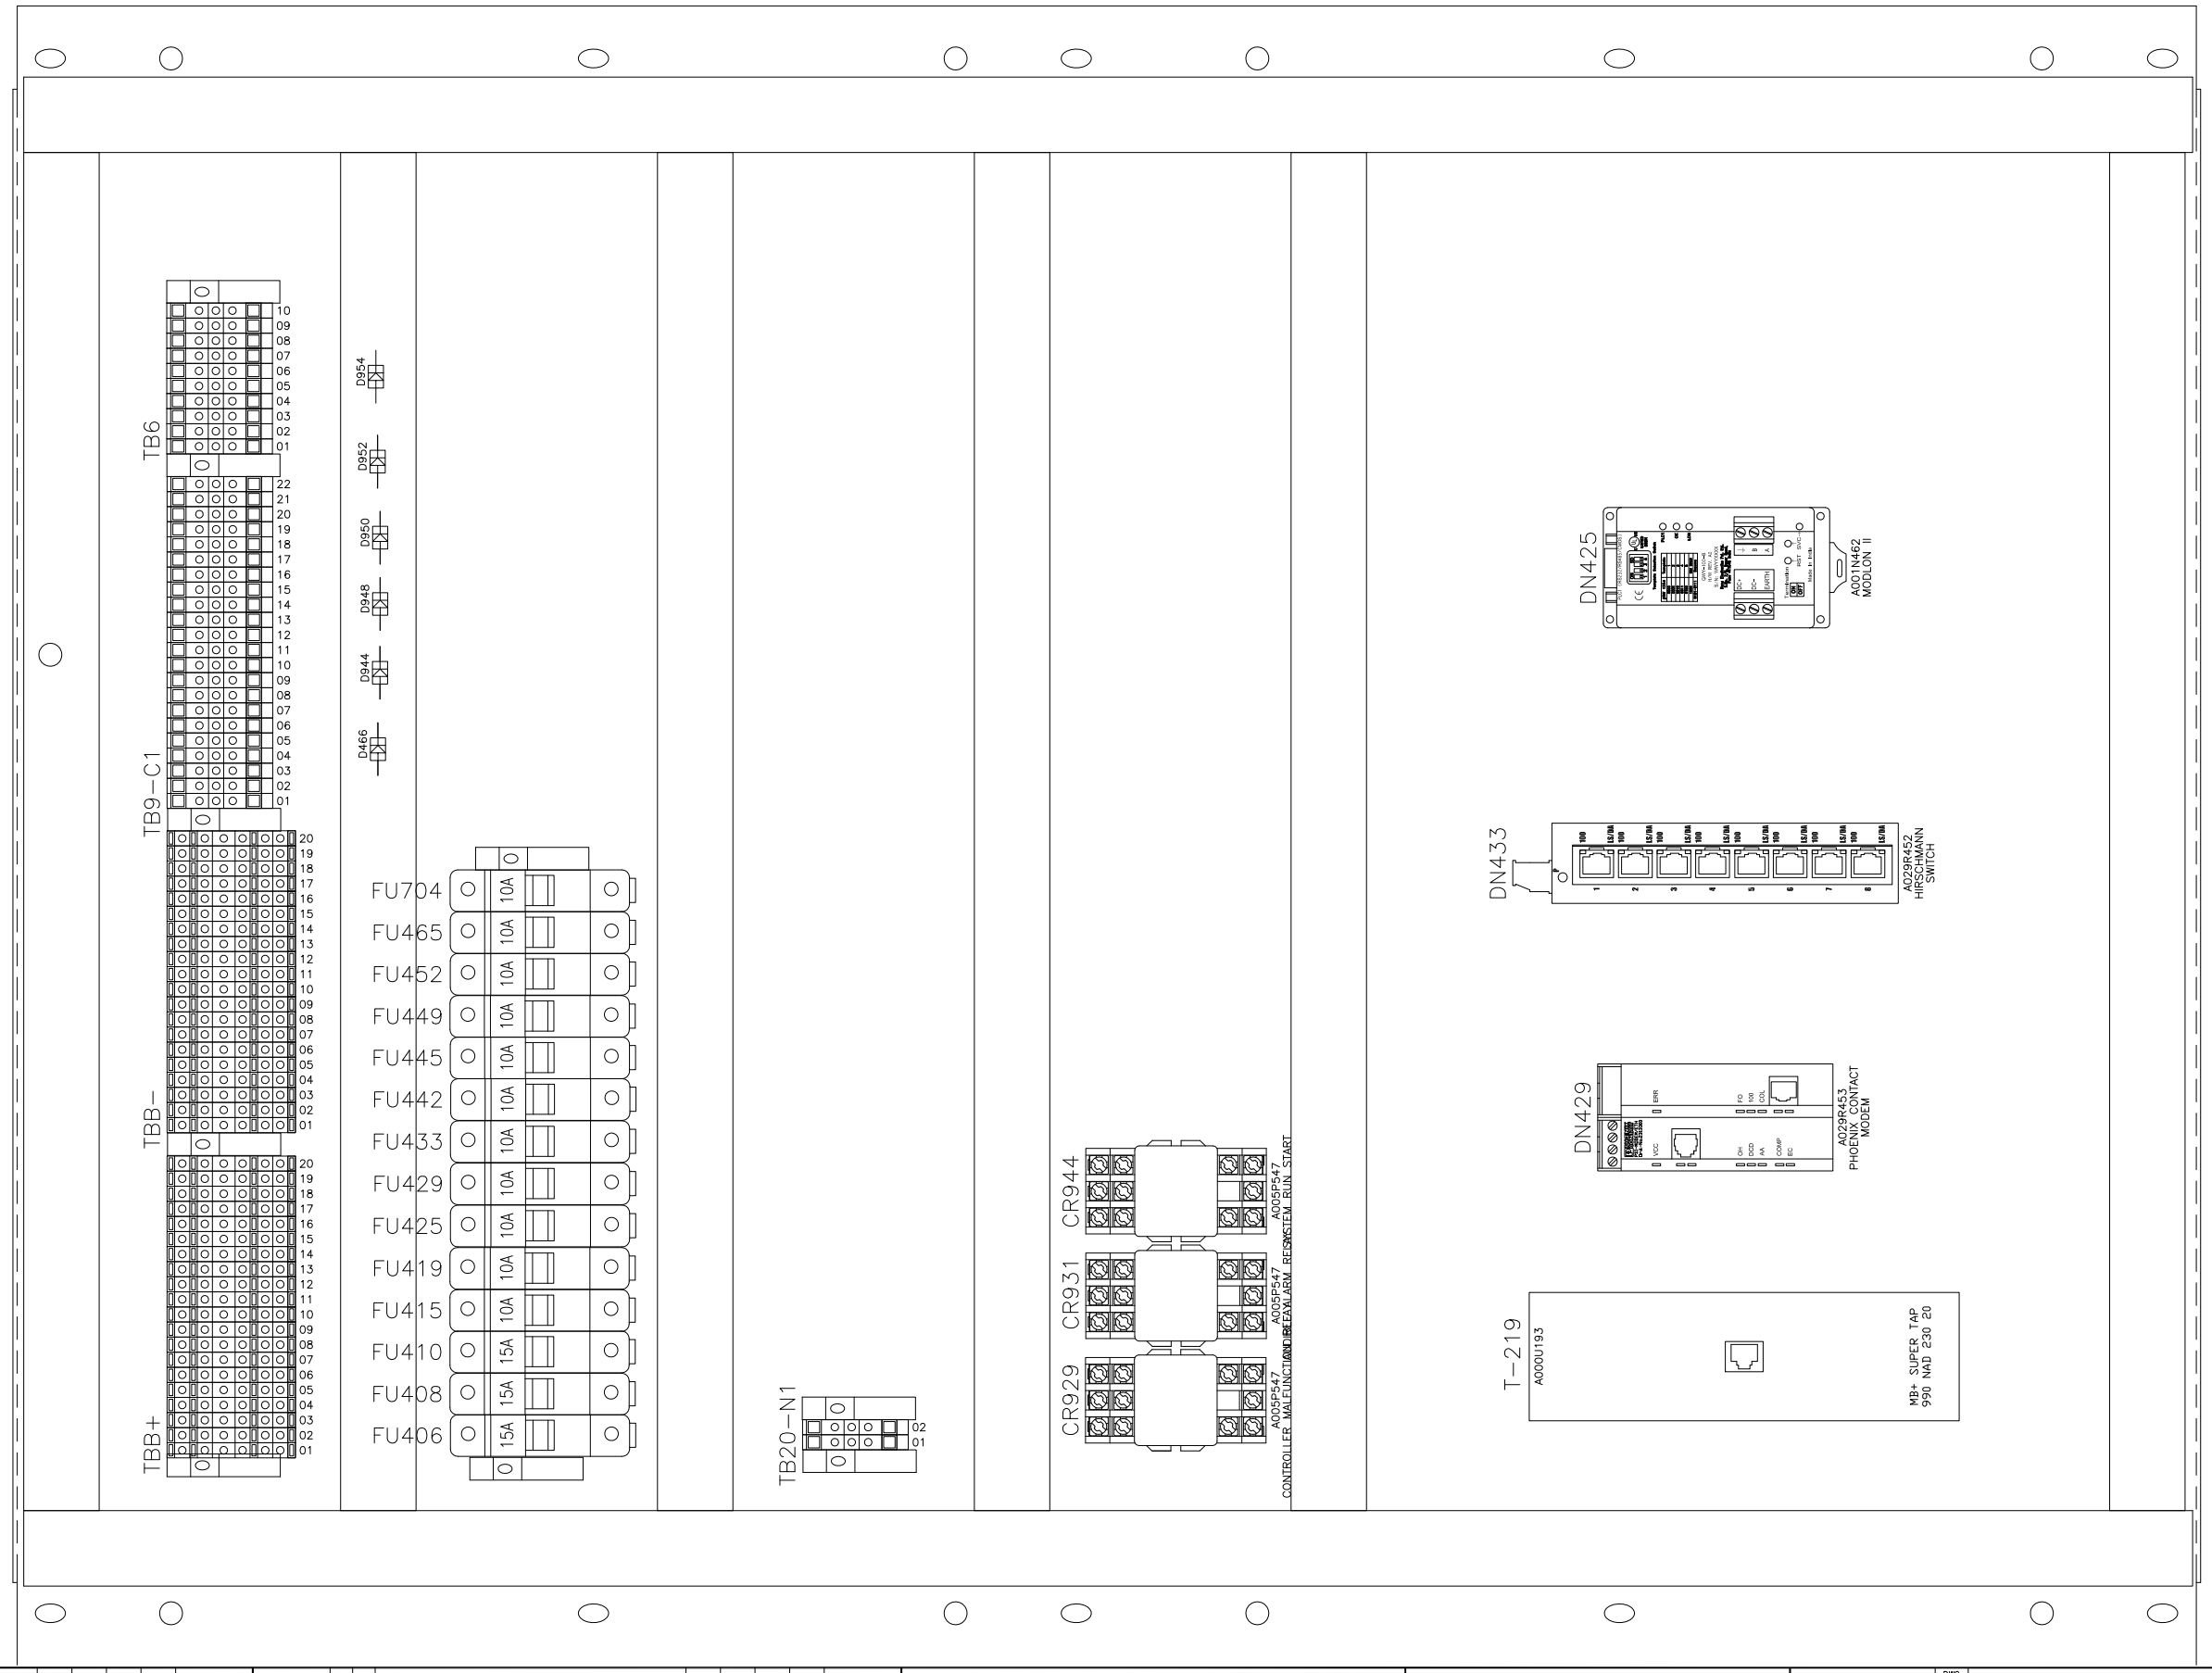

PC NO.	LTR	NO.	REVISION	ZONE	DRA	CHKR	APRV	DATE
PC104235	01	A	PRODUCTION RELEASE AS-BUILT	–	VS	VS	KT	06/17/10

PROJECT:
ARECIBO OBSERVATORY SWITCHGEAR
DMC LOWER REAR PANEL LAYOUT
DISTRIBUTOR:
CUMMINS CARIBBEAN
7071681

DO NOT SCALE PRINT

AUTOCAD DWG

SIM TO
COPIED FROM
THREE ANGLE PROJECTION
ANG TOL
DRAWN TO SCALE OF

THIS DOCUMENT IS THE PROPERTY OF CUMMINS POWER GENERATION. IT CONTAINS PROPRIETARY AND CONFIDENTIAL INFORMATION WHICH MUST NOT BE REPRODUCED, USED OR DISCLOSED OTHER THAN EXPRESSLY AUTHORIZED BY CUMMINS POWER GENERATION OR ITS REPRESENTATIVE

PART NO.	DWG SIZE	DESCRIPTION OF MATERIAL	REF DES

	NAME	DATE
DR	V.SAKLANI	06/17/10
CHKR	V. SIVAN	06/17/10
MFG		
APPROVED	K.TWUMASI	06/17/10

FOR INTERPRETATION OF DIMENSIONING AND TOLERANCING, SEE ANSI Y14.5M-1982

MODEL FIRST USED ON PCIL2004R-772F

SITE CODE PGA

CUMMINS POWER GENERATION
1400 73rd AVE. NE
MINNEAPOLIS, MN 55432

TITLE WD-SCHEMATISC

DWG NO. A030S865

SHEET 30 OF 61

DWG SIZE D

TAGS	QTY	SUB	CATALOG	CPG LEGACY	MFG	DESCRIPTION
T-219	1		A000U193	0324-0027-01	MODICON	MODBUS PLUS SUPER TAP CABLE TAP W/ RJ45 PORT 990 NAD 230 20
CR929 CR931 CR944	3	*1	A005P547	0307-2721	DELTROL	RELAY-CONTROL, 24VDC CONTROL RELAY 24 VDC 3 C FORM 23153-71
		*1	A006J318	0323-1410-01	IDEC	SOCKET-RELAY SOCKET 11 PIN SR3B-05 & SR3B-02F1
	8		GENERIC		PANDUIT	
D466 D944 D948 D950 D952 D954	6		A005P063	0357-0114	VENDOR SOURCE CONTROLLED	RECTIFIER - 3A DIODE, POWER 3A, 400V CONTROLLED
DN433	1		A029R452	A029R452	HIRSCHMANN	ETHERNET SWITCH SPIDER II 8TX SWITCH 24VDC RJ45, 10/100 MBITS DIN RAIL MOUNT 943 957-001
DN429	1		A029R453	A029R453	PHOENIX CONTACT	NETWORK MODEM (PSI-MODEM/ETH) MODEM 24VDC DIN RAIL MOUNT 2313300
DN425	1		A001N462	0300-5926	RENU	MODLON GATEWAY - MODLON II GATEWAY 9-32VDC GWY-100
FU406 FU408 FU410	3	*1	A002K943	0321-0363-30	BUSSMANN	FUSE - CLASS CC TIME DELAY, CURRENT LIMITING 15AMPS 600VAC LP-CC-15 USE WITH FUSE BLOCK 0321-0344
		*1	A002L124	0321-0344	GOULD	1 POLE FUSE BLOCK - CLASS CC FUSE HOLDER 1/10-30AMPS 600VAC PRESSURE PLATE TERM USCC1 USE WITH FUSES LP-CC*
FU415 FU419 FU425 FU429 FU433 FU442 FU445 FU449 FU452 FU465 FU704	11	*1	A002K944	0321-0363-28	BUSSMANN	FUSE - CLASS CC TIME DELAY, CURRENT LIMITING 10AMPS 600VAC LP-CC-10 USE WITH FUSE BLOCK 0321-0344
		*1	A002L124	0321-0344	GOULD	1 POLE FUSE BLOCK - CLASS CC FUSE HOLDER 1/10-30AMPS 600VAC PRESSURE PLATE TERM USCC1 USE WITH FUSES LP-CC*
TBB+ TBB-	40		A006Z109	0332-3125-04	WEIDMULLER	TERMINAL BLOCK DOUBLE LEVEL 300V, 27A DOUBLE LEVEL, FEED THROUGH, WITH INTERNAL LINK 22-12 AWG 3636.6
TB20-N1 TB6 TB9-C1	34		A006Z117	0332-3125-01	WEIDMULLER	TERMINAL BLOCK SINGLE LEVEL 600V, 20A SINGLE LEVEL, FEED THROUGH 22-12 AWG 3804.6
CBL215 CBL227 CBL228	3		A000Y479	0335-0198-02	BORDER STATES	CABLE ASSY(ETHERNET) COMMUNICATION ETHERNET PATCH CABLE,10FT, RJ45 24AWG, 4 TWISTED PAIR
CBL229	1		A000Y495	0335-0250-02	CUMMINS	CABLE ASSY(MODLON) COMMUNICATION MODBUS FOR QUANTUM TO MODLON II
CBL214	1		A000Y609	0326-0173	MODICON	CABLE - DROP, MODBUS+ COMMUNICATION MODBUS PLUS 8 FT LONG, 9 PIN 'D' SHELL 990 NAD 211 10
CBL203 CBL203A	2		A000Y808	0326-0149-04	MODICON	CABLE-MODBUS+ TRUNK COMMUNICATION MODBUS PLUS SPECIFY FEET NEEDED, TP-PVC VACCETED REEL
CBL235	1		A000Y856	0334-1350	VENDOR SOURCE CONTROLLED	CABLE - CAT IV COMMUNICATION 22AWG PVC JACKET

PC NO.	LTR	NO.	REVISION	ZONE	DRA	CHKR	APRV	DATE
PC104235	01	A	PRODUCTION RELEASE AS-BUILT	-	VS	VS	KT	06/17/10

PROJECT:
ARECIBO OBSERVATORY SWITCHGEAR
DMC LOWER REAR PANEL LAYOUT BOM
DISTRIBUTOR:
CUMMINS CARIBBEAN
7071681

DO NOT SCALE PRINT

ANG TOL | DRAWN TO SCALE OF

AUTOCAD DWG

SIM TO | COPIED FROM | THREE ANGLE PROJECTION

THIS DOCUMENT IS THE PROPERTY OF CUMMINS POWER GENERATION. IT CONTAINS PROPRIETARY AND CONFIDENTIAL INFORMATION WHICH MUST NOT BE DUPLICATED, USED OR DISCLOSED OTHER THAN EXPRESSLY AUTHORIZED BY CUMMINS POWER GENERATION OR ITS REPRESENTATIVE

	NAME	DATE
DR	V.SAKLANI	06/17/10
CHKR ☐ MFG ☐	V. SIVAN	06/17/10
APPROVED	K.TWUMASI	06/17/10

FOR INTERPRETATION OF DIMENSIONING AND TOLERANCING, SEE ANSI Y14.5M-1982

MODEL FIRST USED ON: PCIL2004R-772F

SITE CODE: PGA

PART NO. | DWG SIZE | DESCRIPTION OF MATERIAL | REF DES

CUMMINS POWER GENERATION
1400 73rd AVE.NE
MINNEAPOLIS, MN 55432

TITLE: WD-SCHEMATISC

DWG NO. A030S865 | SHEET 31 OF 61 | DWG SIZE D

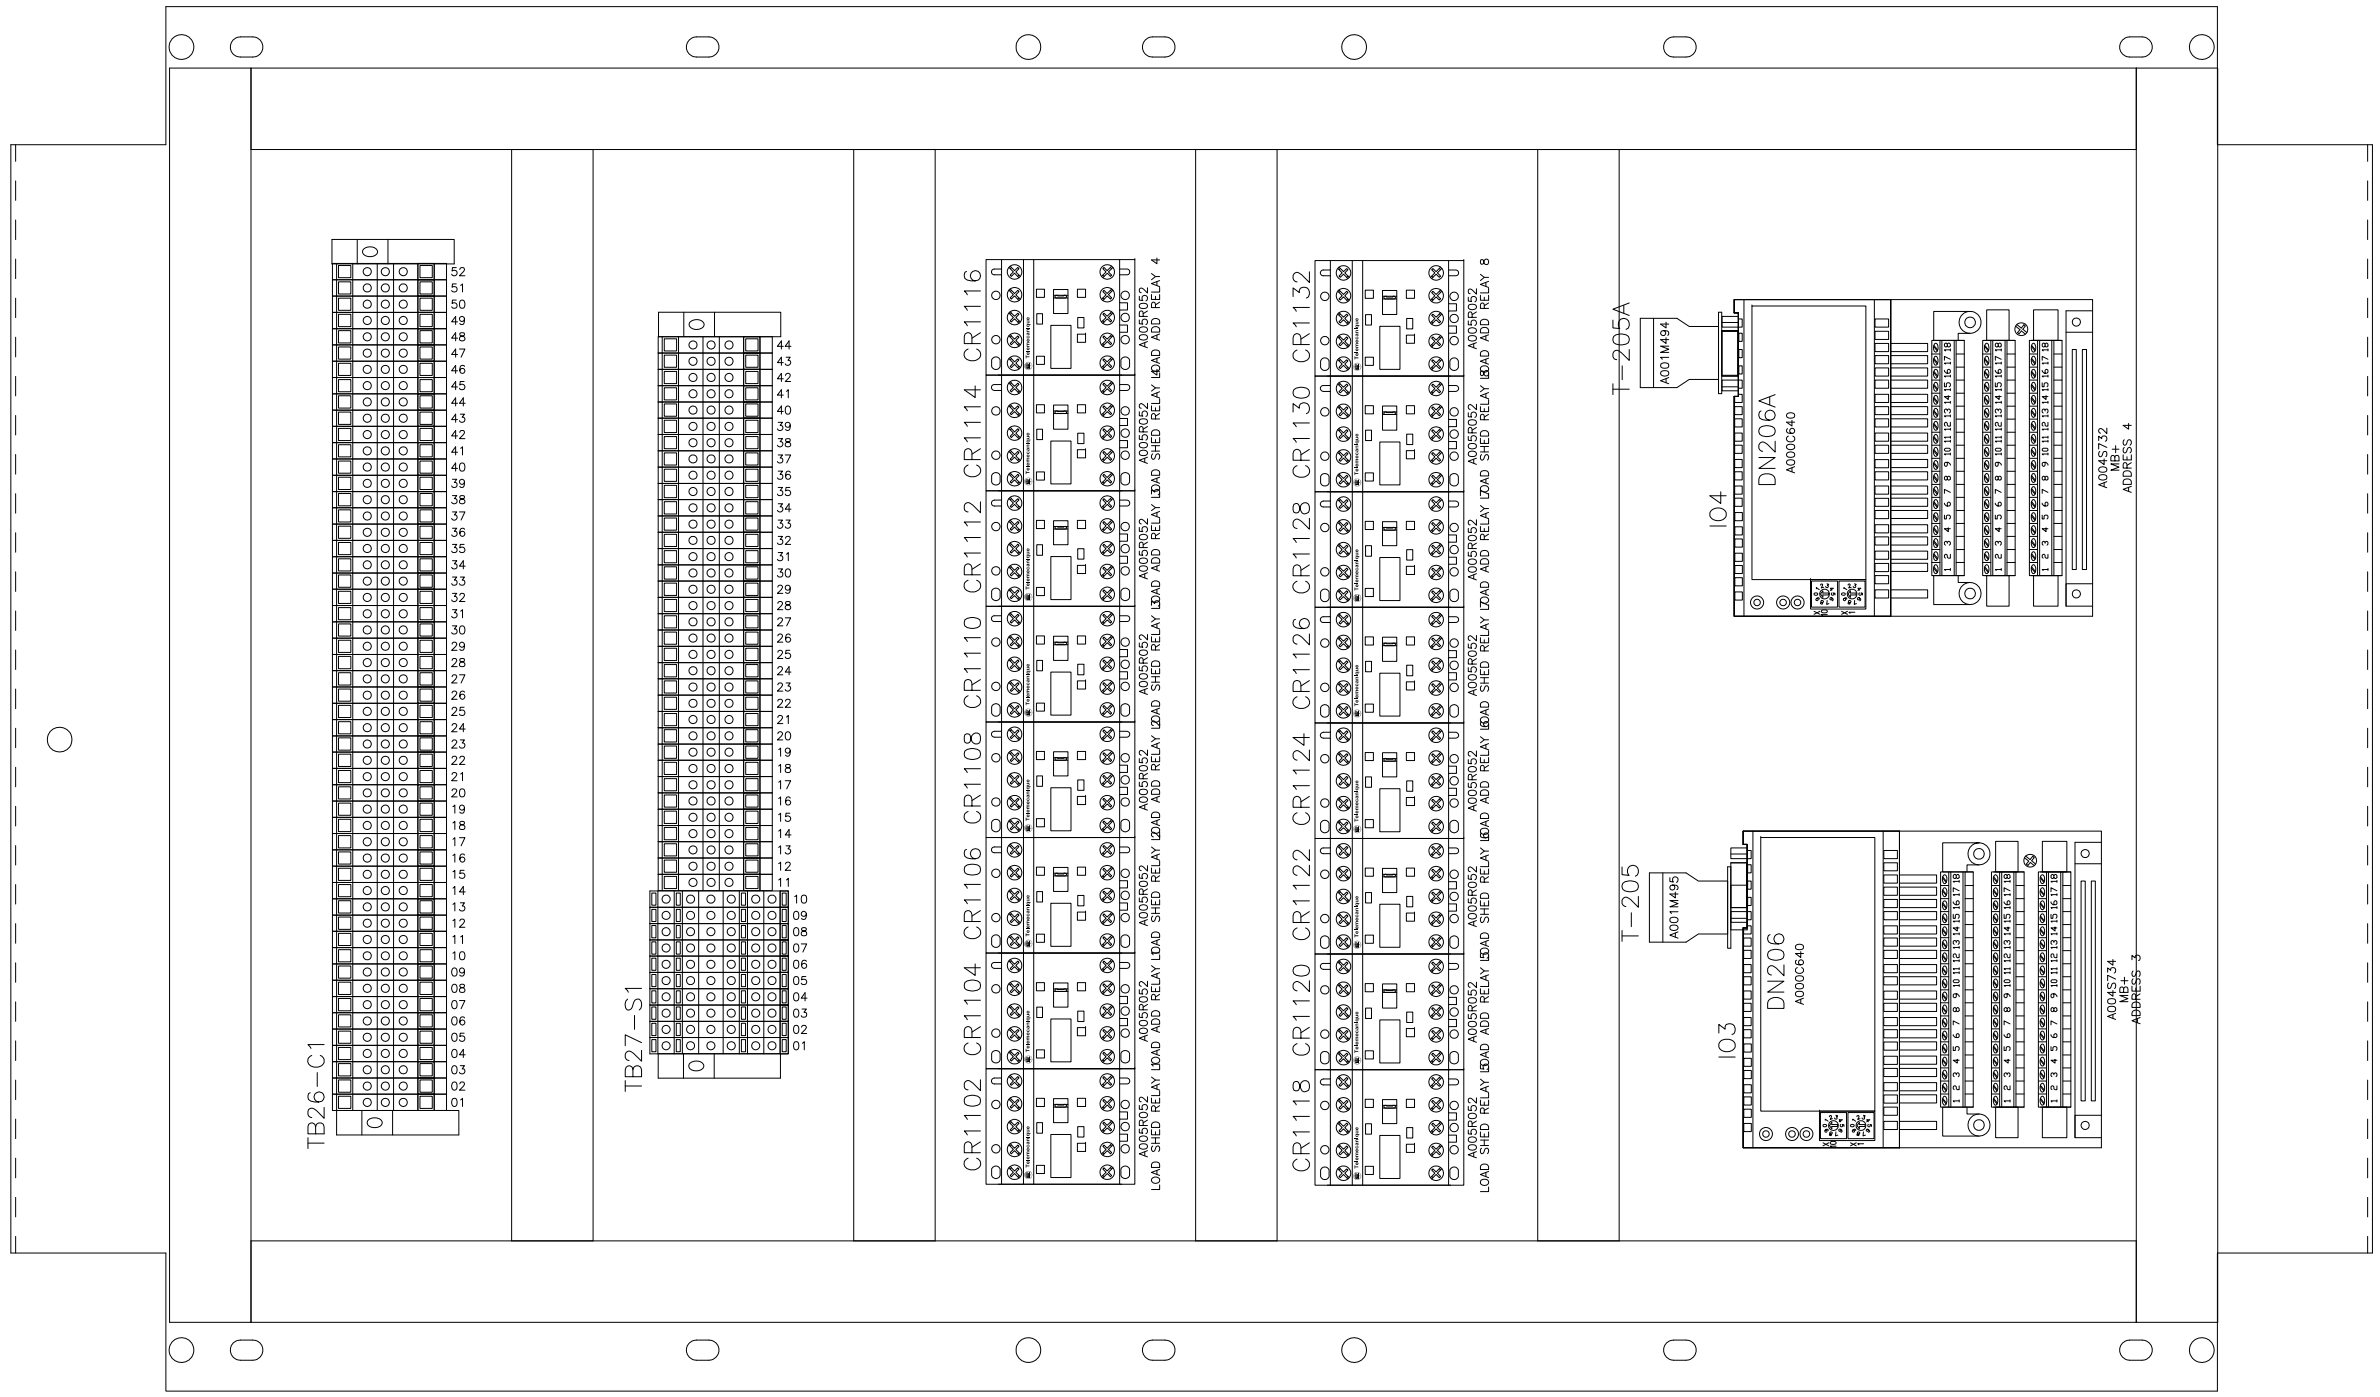

PC NO.	LTR	NO.	REVISION	ZONE	DRA	CHKR	APRV	DATE
PC104235	01	A	PRODUCTION RELEASE AS-BUILT	–	VS	VS	KT	06/17/10

PROJECT:
ARECIBO OBSERVATORY SWITCHGEAR
DMC UPR LH PANEL LAYOUT
DISTRIBUTOR:
CUMMINS CARIBBEAN
7071681

DO NOT SCALE PRINT

ANG TOL | DRAWN TO SCALE OF

AUTOCAD DWG

SIM TO | COPIED FROM | THREE ANGLE PROJECTION

THIS DOCUMENT IS THE PROPERTY OF CUMMINS POWER GENERATION. IT CONTAINS PROPRIETARY AND CONFIDENTIAL INFORMATION WHICH MUST NOT BE DUPLICATED, USED OR DISCLOSED OTHER THAN EXPRESSLY AUTHORIZED BY CUMMINS POWER GENERATION OR ITS REPRESENTATIVE

PART NO.	DWG SIZE	DESCRIPTION OF MATERIAL	REF DES

	NAME	DATE
DR	V.SAKLANI	06/17/10
CHKR / MFG	V. SIVAN	06/17/10
APPROVED	K.TWUMASI	06/17/10

FOR INTERPRETATION OF DIMENSIONING AND TOLERANCING, SEE ANSI Y14.5M-1982

MODEL FIRST USED ON PCIL2004R-772F

SITE CODE PGA

CUMMINS POWER GENERATION
1400 73rd AVE.NE
MINNEAPOLIS, MN 55432

TITLE WD-SCHEMATISC

DWG NO. A030S865 | SHEET 32 OF 61 | DWG SIZE D

TAGS	QTY	SUB	CATALOG	CPG LEGACY	MFG	DESCRIPTION
T-205A	1		A001M494	0323-1735-01	MODICON	CONNECTOR - MODBUS INLINE KIT CONNECTOR ONE PER KIT AS-MBKT-085
T-205	1		A001M495	0323-1735-02	MODICON	CONNECTOR - MODBUS TERMINATING KIT CONNECTOR TWO PER KIT ASMBKT-185
CR1102 CR1104 CR1106 CR1108 CR1110 CR1112 CR1114 CR1116 CR1118 CR1120 CR1122 CR1124 CR1126 CR1128 CR1130 CR1132	16		A005R052	0307-2861-06	TELEMECHANIQUE	RELAY-CONTROL, 24VDC CONTROL RELAY 24 VDC 2 NO, 2 NC 18 - 12 AWG CA4-KN22BW3
	8		GENERIC		PANDUIT	
DN206 DN206A	2		A000C640	0326-0205	MODICON	ADAPTER-COMMUNICATION MOMENTUM COMMUNICATION COMMUNICATION ADAPTER MB+ SINGLE PORT, 984 DATA FORMAT 170NEF11021
IO4	1	*1	A004S732	0326-0201-02	MODICON	DISCRETE INPUT MODULE MOMENTUM DISCRETE INPUT 24VDC 32 POINT INPUT 170ADI35000
		*1	A005L063	0332-3524	MODICON	TERMINAL STRIP MOMENTUM TERMINAL TERMINAL PLUG, 18 PLACE 170XTS00100
IO3	1	*1	A004S734	0326-0202-01	MODICON	DISCRETE OUTPUT MODULE MOMENTUM DISCRETE OUTPUT 24VDC 16 POINT OUTPUT 170ADO34000
		*1	A005L063	0332-3524	MODICON	TERMINAL STRIP MOMENTUM TERMINAL TERMINAL PLUG, 18 PLACE 170XTS00100
TB27-S1	10		A006Z109	0332-3125-04	WEIDMULLER	TERMINAL BLOCK DOUBLE LEVEL 300V, 27A DOUBLE LEVEL, FEED THROUGH, WITH INTERNAL LINK 22-12 AWG 3636.6
TB26-C1 TB27-S1	86		A006Z117	0332-3125-01	WEIDMULLER	TERMINAL BLOCK SINGLE LEVEL 600V, 20A SINGLE LEVEL, FEED THROUGH 22-12 AWG 3804.6

PC NO.	LTR	NO.	REVISION	ZONE	DRA	CHKR	APRV	DATE
PC104235	01	A	PRODUCTION RELEASE AS-BUILT	-	VS	VS	KT	06/17/10

PROJECT:
ARECIBO OBSERVATORY SWITCHGEAR
DMC UPR LH PANEL LAYOUT BOM
DISTRIBUTOR:
CUMMINS CARIBBEAN
7071681

DO NOT SCALE PRINT

AUTOCAD DWG

SIM TO
COPIED FROM
THREE ANGLE PROJECTION
ANG TOL
DRAWN TO SCALE OF

THIS DOCUMENT IS THE PROPERTY OF CUMMINS POWER GENERATION. IT CONTAINS PROPRIETARY AND CONFIDENTIAL INFORMATION WHICH MUST NOT BE DUPLICATED, USED OR DISCLOSED OTHER THAN EXPRESSLY AUTHORIZED BY CUMMINS POWER GENERATION OR ITS REPRESENTATIVE

PART NO.	DWG SIZE	DESCRIPTION OF MATERIAL	REF DES

	NAME	DATE
DR	V.SAKLANI	06/17/10
CHKR ☐ MFG ☐	V. SIVAN	06/17/10
APPROVED	K.TWUMASI	06/17/10

FOR INTERPRETATION OF DIMENSIONING AND TOLERANCING, SEE ANSI Y14.5M-1982

MODEL FIRST USED ON PCIL2004R-772F

SITE CODE PGA

CUMMINS POWER GENERATION
1400 73rd AVE NE
MINNEAPOLIS, MN 55432

TITLE WD-SCHEMATISC

DWG NO. A030S865 | SHEET 33 OF 61 | DWG SIZE D

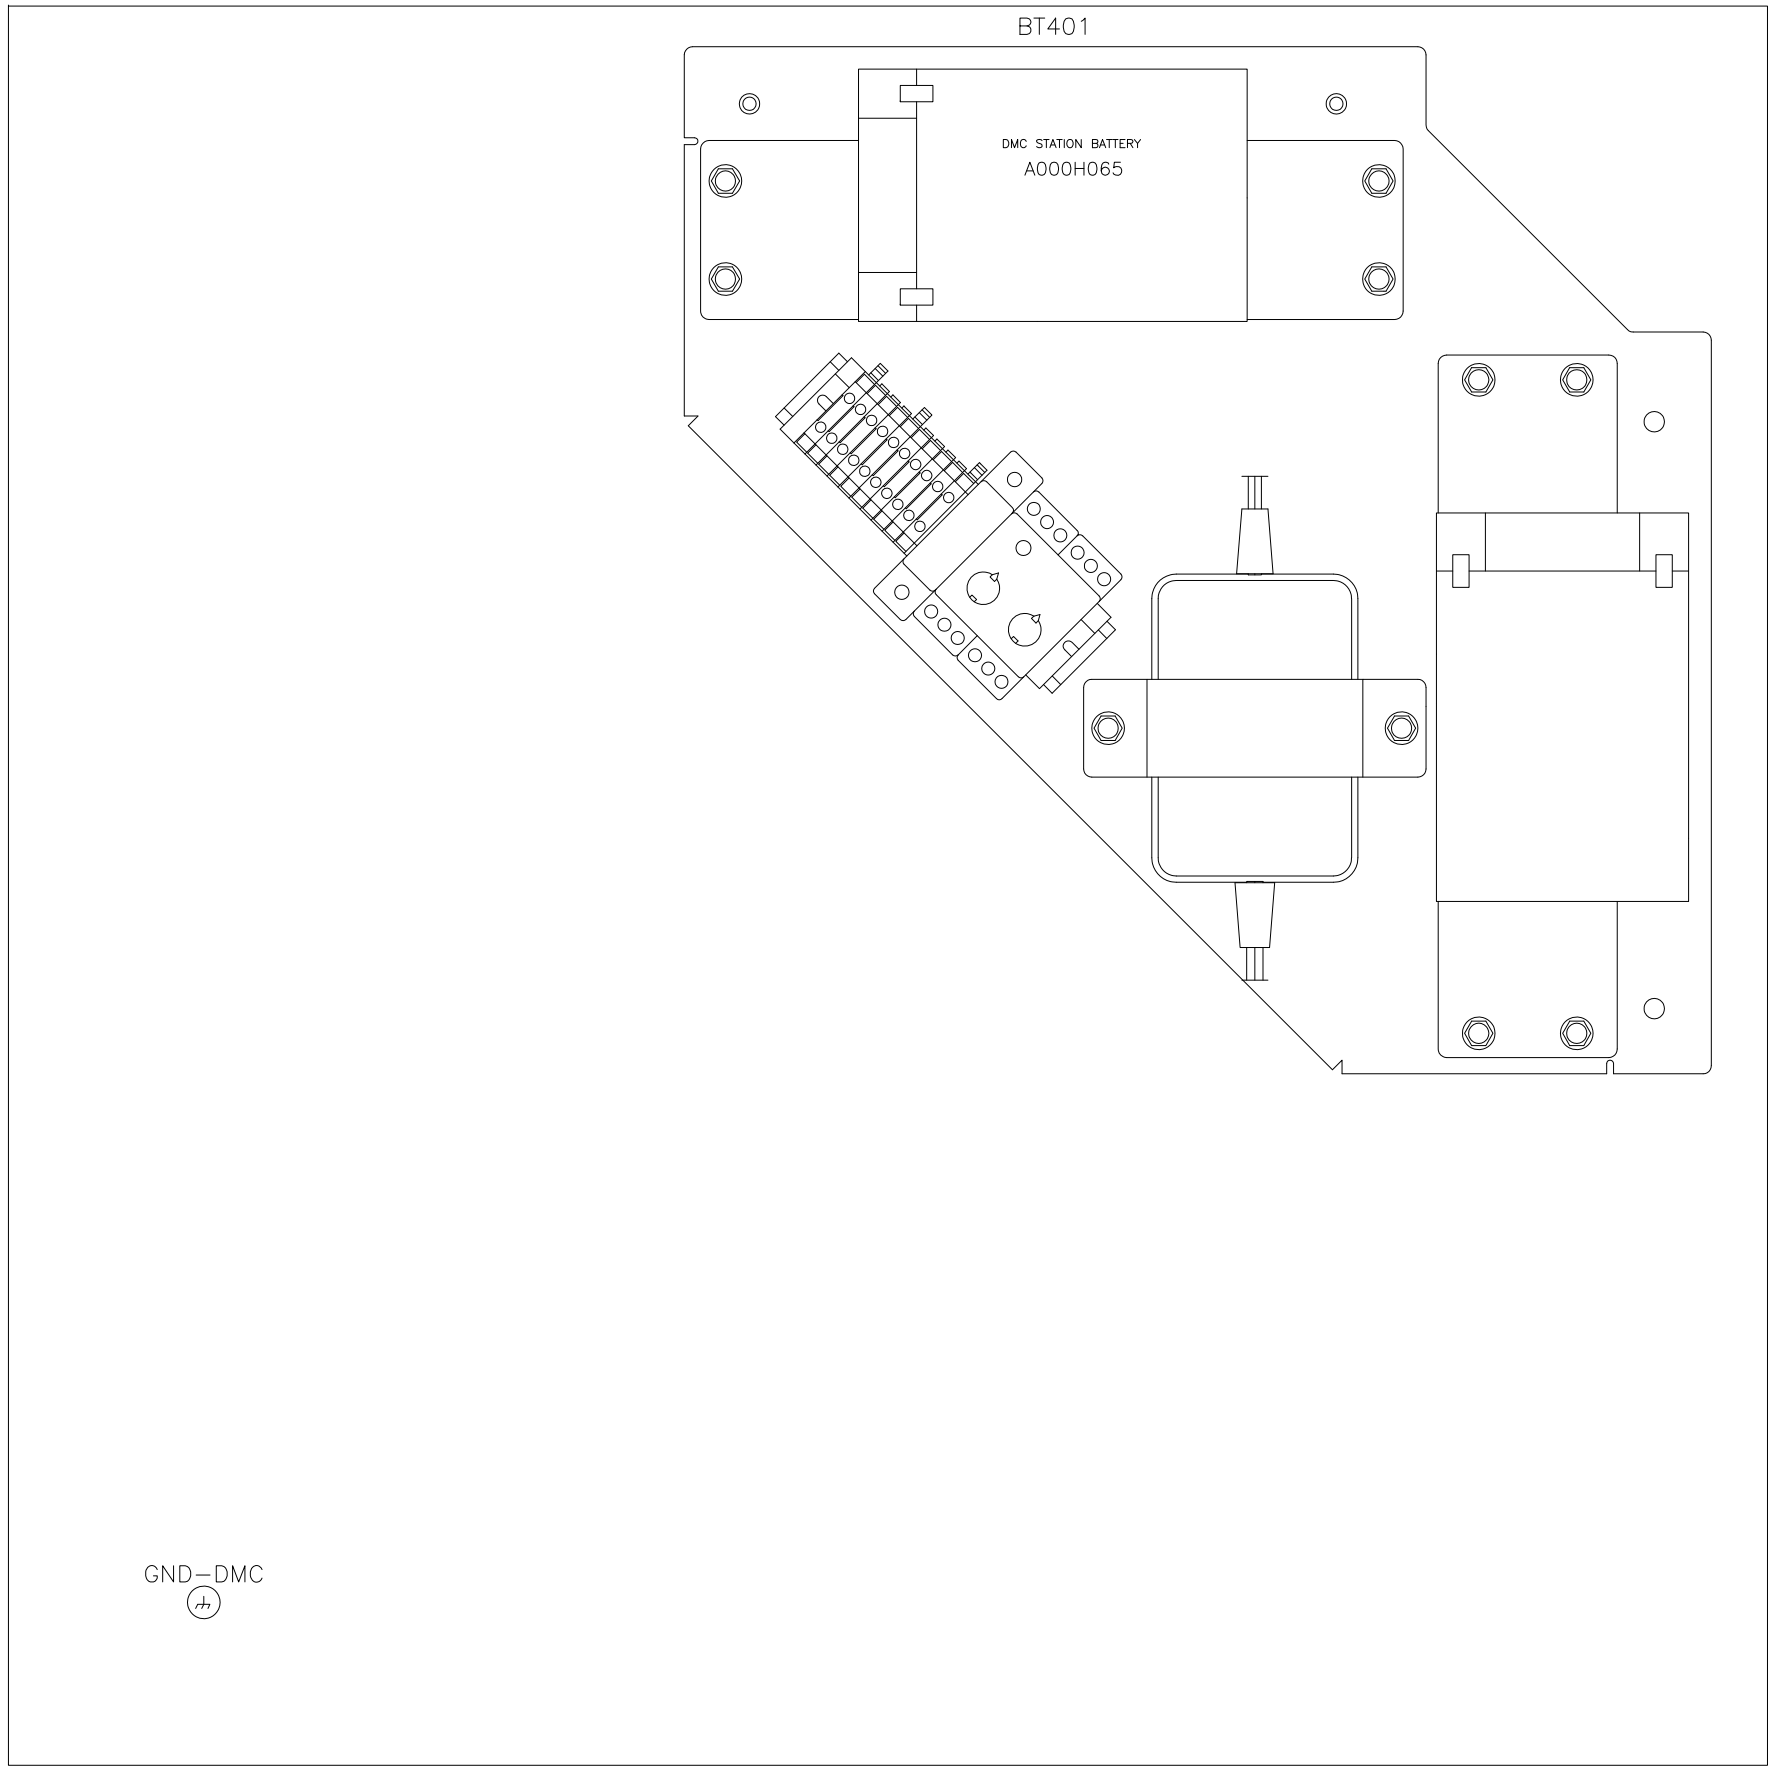

PC NO.	LTR	NO.	REVISION	ZONE	DRA	CHKR	APRV	DATE
PC104235	01	A	PRODUCTION RELEASE AS-BUILT	–	VS	VS	KT	06/17/10

PROJECT:
ARECIBO OBSERVATORY SWITCHGEAR
DMC FLOOR PANEL LAYOUT
DISTRIBUTOR:
CUMMINS CARIBBEAN
7071681

DO NOT SCALE PRINT

ANG TOL | DRAWN TO SCALE OF

AUTOCAD DWG

SIM TO | COPIED FROM | THREE ANGLE PROJECTION

THIS DOCUMENT IS THE PROPERTY OF CUMMINS POWER GENERATION. IT CONTAINS PROPRIETARY AND CONFIDENTIAL INFORMATION WHICH MUST NOT BE DUPLICATED, USED OR DISCLOSED OTHER THAN EXPRESSLY AUTHORIZED BY CUMMINS POWER GENERATION OR ITS REPRESENTATIVE

PART NO.	DWG SIZE	DESCRIPTION OF MATERIAL	REF DES

	NAME	DATE
DR	V.SAKLANI	06/17/10
CHKR	V. SIVAN	06/17/10
APPROVED	K.TWUMASI	06/17/10

FOR INTERPRETATION OF DIMENSIONING AND TOLERANCING, SEE ANSI Y14.5M-1982

MODEL FIRST USED ON PCIL2004R-772F

SITE CODE PGA

CUMMINS POWER GENERATION
1400 73rd AVE.NE
MINNEAPOLIS, MN 55432

TITLE WD-SCHEMATISC

DWG NO. A030S865 | SHEET 34 OF 61 | DWG SIZE D

TAGS	QTY	SUB	CATALOG	CPG LEGACY	MFG	DESCRIPTION
BT401	1	*1	A000H065	0416-1147-01	CUMMINS	BATTERY ASSEMBLY - STATION BATTERY SYSTEM ASSEMBLY 24 VDC 30" FRAME DEPTH
		*2	A000H022	0416-1143	VENDOR	BATTERY - LEAD ACID, 6 CELL, 12VDC BATTERY 12 VDC 12 AMP-HOURS
GND-DMC	1		FRAME GROUND		VENDOR SOURCE CONTROLLED	GROUNDING TERMINAL LUG

PC NO.	LTR	NO.	REVISION	ZONE	DRA	CHKR	APRV	DATE
PC104235	01	A	PRODUCTION RELEASE AS-BUILT	-	VS	VS	KT	06/17/10

PROJECT:
ARECIBO OBSERVATORY SWITCHGEAR
DMC FLOOR PANEL LAYOUT BOM
DISTRIBUTOR:
CUMMINS CARIBBEAN
7071681

DO NOT SCALE PRINT

ANG TOL | DRAWN TO SCALE OF

AUTOCAD DWG

SIM TO | COPIED FROM | THREE ANGLE PROJECTION

THIS DOCUMENT IS THE PROPERTY OF CUMMINS POWER GENERATION. IT CONTAINS PROPRIETARY AND CONFIDENTIAL INFORMATION WHICH MUST NOT BE DUPLICATED, USED OR DISCLOSED OTHER THAN EXPRESSLY AUTHORIZED BY CUMMINS POWER GENERATION OR ITS REPRESENTATIVE

PART NO.	DWG SIZE	DESCRIPTION OF MATERIAL	REF DES

	NAME	DATE
DR	V.SAKLANI	06/17/10
CHKR	V. SIVAN	06/17/10
MFG		
APPROVED	K.TWUMASI	06/17/10

FOR INTERPRETATION OF DIMENSIONING AND TOLERANCING, SEE ANSI Y14.5M-1982

MODEL FIRST USED ON PCIL2004R-772F

SITE CODE PGA

CUMMINS POWER GENERATION
1400 73rd AVE. NE
MINNEAPOLIS, MN 55432

TITLE WD-SCHEMATISC

DWG NO. A030S865

SHEET 35 OF 61

DWG SIZE D

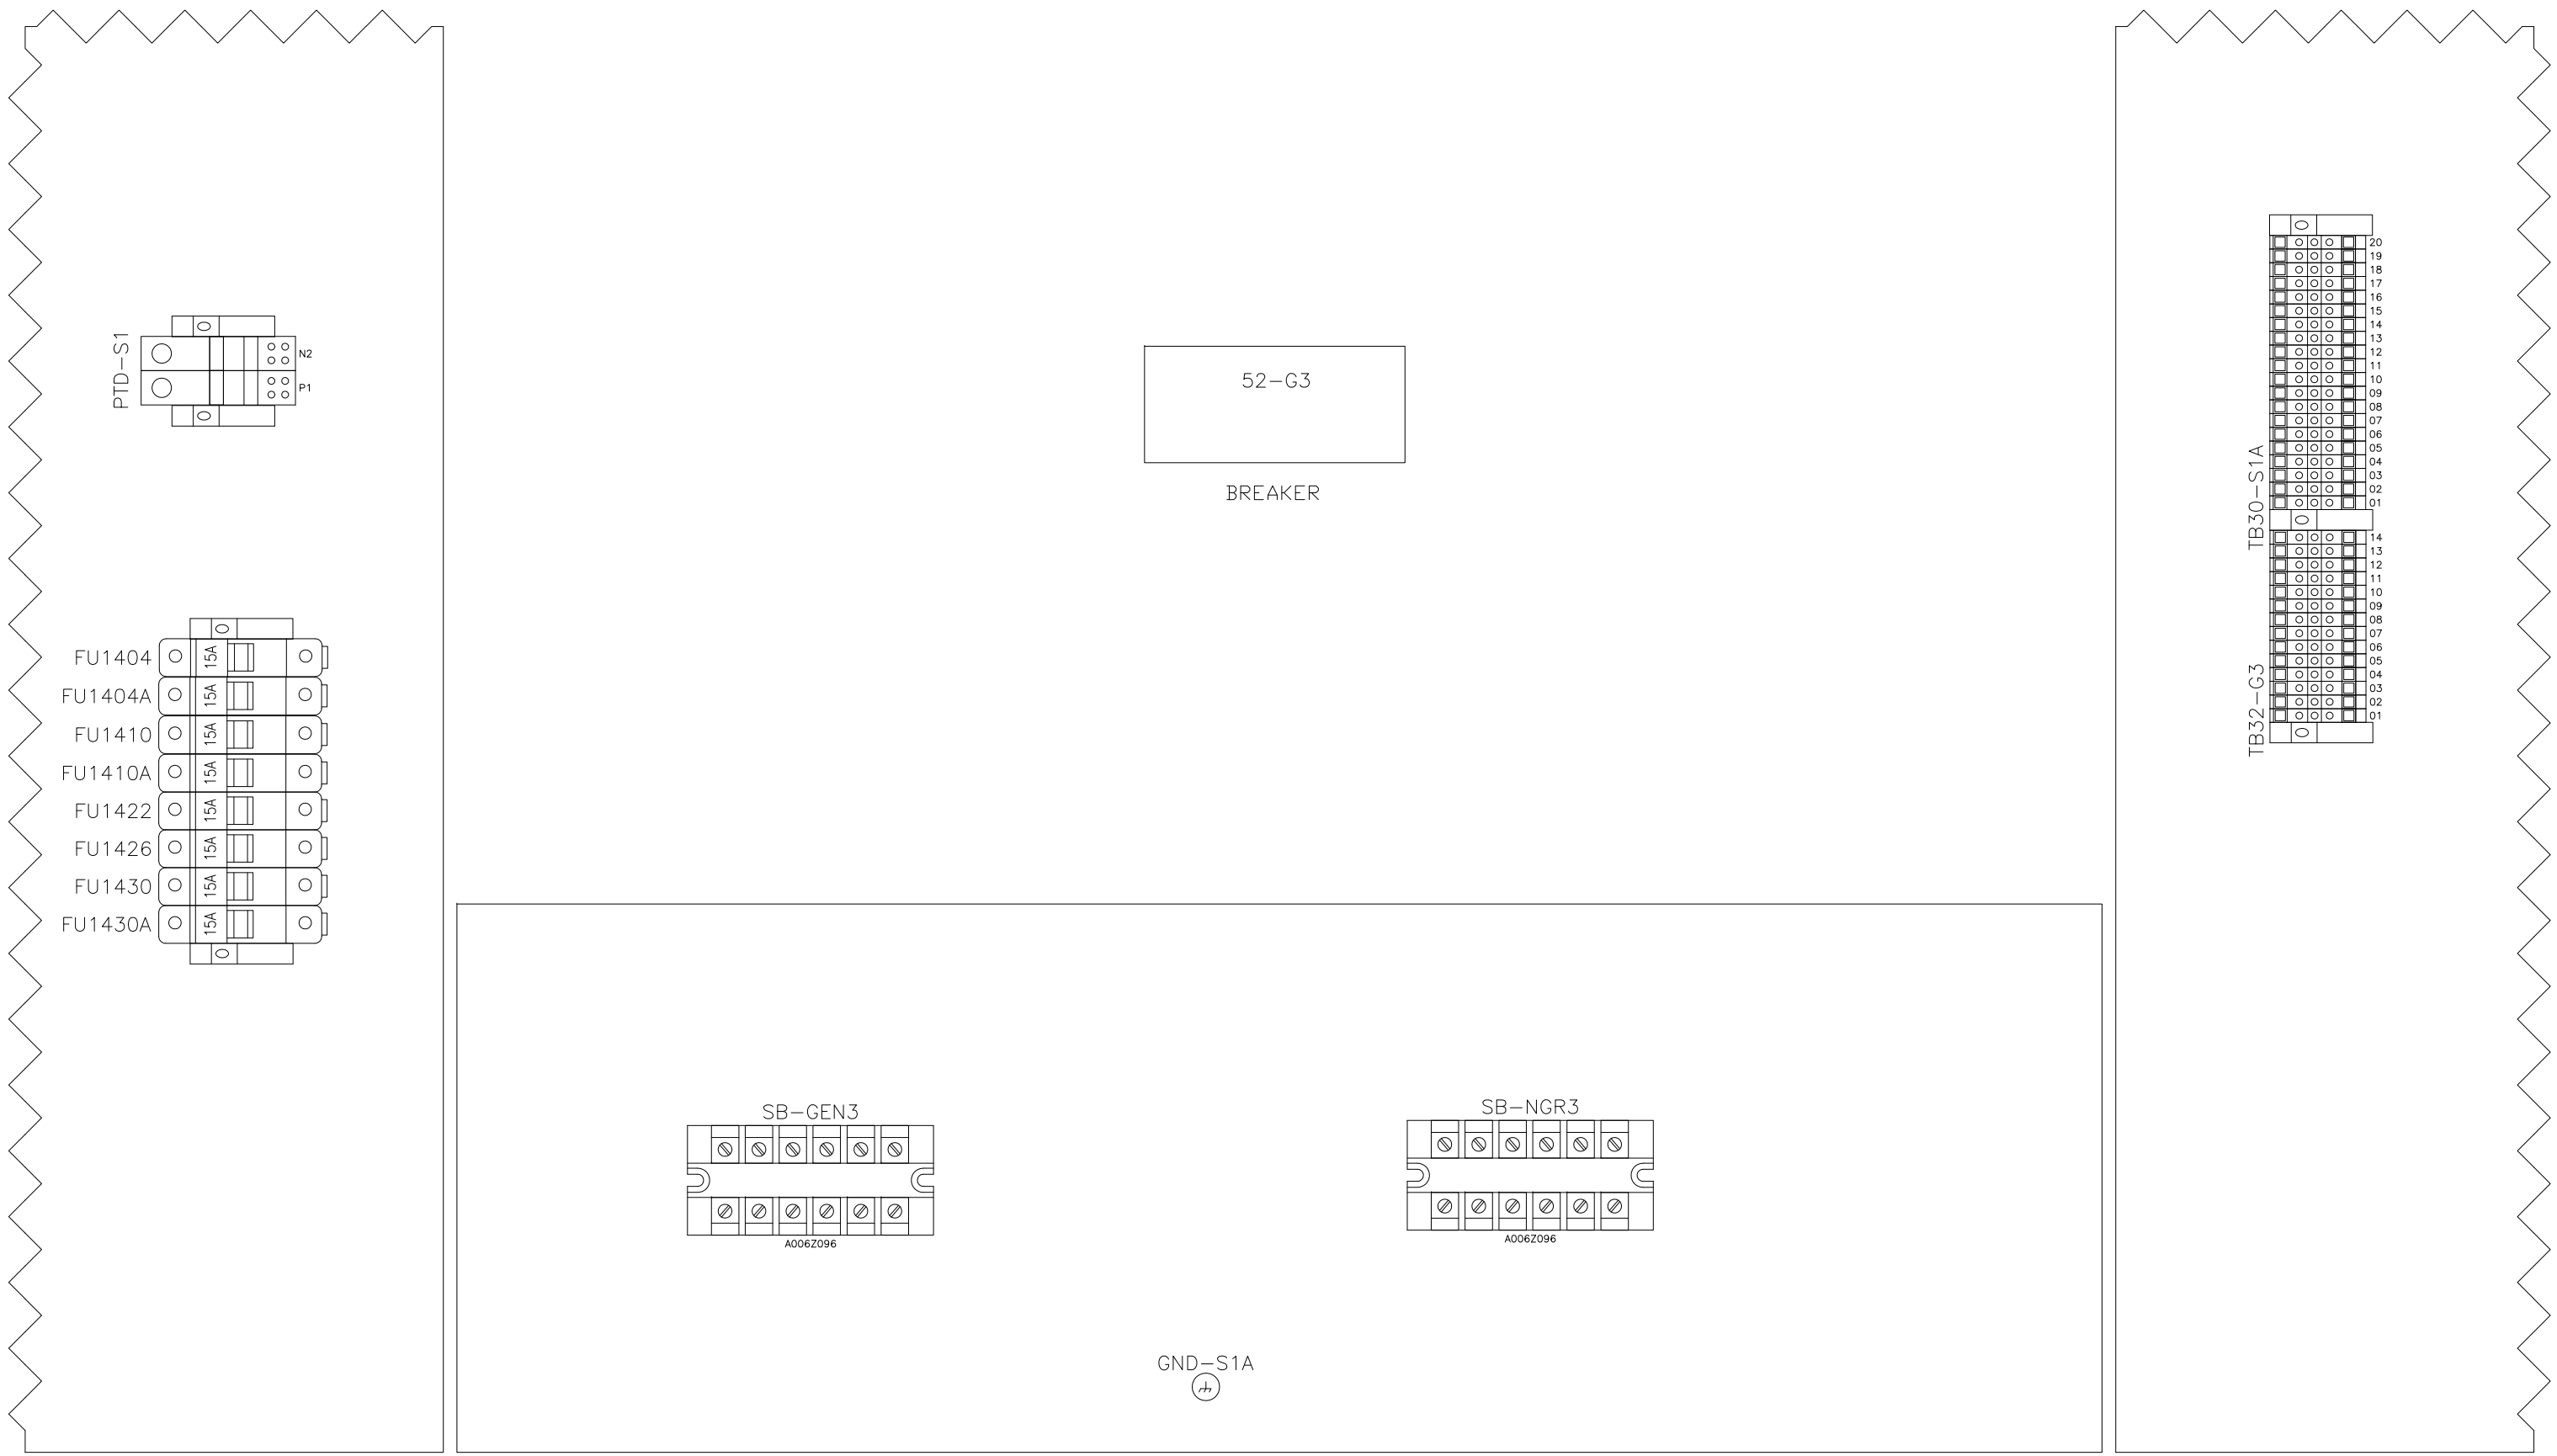

PC NO.	LTR	NO.	REVISION	ZONE	DRA	CHKR	APRV	DATE
PC104235	01	A	PRODUCTION RELEASE AS-BUILT	–	VS	VS	KT	06/17/10

PROJECT:
ARECIBO OBSERVATORY SWITCHGEAR
SG S1A CELL PANEL LAYOUT
DISTRIBUTOR:
CUMMINS CARIBBEAN
7071681

DO NOT SCALE PRINT

ANG TOL | DRAWN TO SCALE OF

AUTOCAD DWG

SIM TO | COPIED FROM | THREE ANGLE PROJECTION

THIS DOCUMENT IS THE PROPERTY OF CUMMINS POWER GENERATION. IT CONTAINS PROPRIETARY AND CONFIDENTIAL INFORMATION WHICH MUST NOT BE DUPLICATED, USED OR DISCLOSED OTHER THAN EXPRESSLY AUTHORIZED BY CUMMINS POWER GENERATION OR ITS REPRESENTATIVE.

PART NO.	DWG SIZE	DESCRIPTION OF MATERIAL	REF DES

	NAME	DATE
DR	V.SAKLANI	06/17/10
CHKR / MFG	V. SIVAN	06/17/10
APPROVED	K.TWUMASI	06/17/10

FOR INTERPRETATION OF DIMENSIONING AND TOLERANCING, SEE ANSI Y14.5M-1982

MODEL FIRST USED ON: PCIL2004R-772F

SITE CODE: PGA

CUMMINS POWER GENERATION
1400 73rd AVE NE
MINNEAPOLIS, MN 55432

TITLE: WD-SCHEMATISC

DWG NO. A030S865 | SHEET 36 OF 61 | DWG SIZE D

TAGS	QTY	SUB	CATALOG	CPG LEGACY	MFG	DESCRIPTION
52-G3	1		MV UPPER CELL		SQUARE D	CIRCUIT BREAKER VENDOR
FU1404 FU1404A FU1410 FU1410A FU1422 FU1426 FU1430 FU1430A	8	*1	A002K943	0321-0363-30	BUSSMANN	FUSE - CLASS CC TIME DELAY, CURRENT LIMITING 15AMPS 600VAC LP-CC-15 USE WITH FUSE BLOCK 0321-0344
		*1	A002L124	0321-0344	GOULD	1 POLE FUSE BLOCK - CLASS CC FUSE HOLDER 1/10-30AMPS 600VAC PRESSURE PLATE TERM USCC1 USE WITH FUSES LP-CC*
GND-S1A	1		FRAME GROUND		VENDOR SOURCE CONTROLLED	GROUNDING TERMINAL LUG
SB-GEN3 SB-NGR3	2		A006Z096	0332-3178-01	CUMMINS	TERMINAL BLOCK SHORTING BLOCK 600V, 30A 6 TERMINAL
PTD-S1	2		SQD PTD		SQUARE D	SUPPLIED BY SQUARE D TERMINAL DC BUS TERMINAL VENDOR SUPPLIED
STA-S1 STG-S1	2		SQD SHORTING BLOCK		SQUARE D	SUPPLIED BY SQUARE D SHORTING BLOCK 6 TERMINAL BY SQUARE D
TB30-S1A TB32-G3	34		A006Z117	0332-3125-01	WEIDMULLER	TERMINAL BLOCK SINGLE LEVEL 600V, 20A SINGLE LEVEL, FEED THROUGH 22-12 AWG 3804.6

PC NO.	LTR	NO.	REVISION	ZONE	DRA	CHKR	APRV	DATE
PC104235	01	A	PRODUCTION RELEASE AS-BUILT	-	VS	VS	KT	06/17/10

PROJECT:
ARECIBO OBSERVATORY SWITCHGEAR
SG S1A CELL PANEL LAYOUT BOM
DISTRIBUTOR:
CUMMINS CARIBBEAN
7071681

DO NOT SCALE PRINT

ANG TOL | DRAWN TO SCALE OF

AUTOCAD DWG

SIM TO | COPIED FROM | THREE ANGLE PROJECTION

THIS DOCUMENT IS THE PROPERTY OF CUMMINS POWER GENERATION. IT CONTAINS PROPRIETARY AND CONFIDENTIAL INFORMATION WHICH MUST NOT BE DUPLICATED, USED OR DISCLOSED OTHER THAN EXPRESSLY AUTHORIZED BY CUMMINS POWER GENERATION OR ITS REPRESENTATIVE

PART NO.	DWG SIZE	DESCRIPTION OF MATERIAL	REF DES

	NAME	DATE
DR	V.SAKLANI	06/17/10
CHKR / MFG	V. SIVAN	06/17/10
APPROVED	K.TWUMASI	06/17/10

FOR INTERPRETATION OF DIMENSIONING AND TOLERANCING, SEE ANSI Y14.5M-1982

MODEL FIRST USED ON PCIL2004R-772F

SITE CODE PGA

CUMMINS POWER GENERATION
1400 73rd AVE. NE
MINNEAPOLIS, MN 55432

TITLE WD-SCHEMATISC

DWG NO. A030S865 | SHEET 37 OF 61 | DWG SIZE D

KP1331

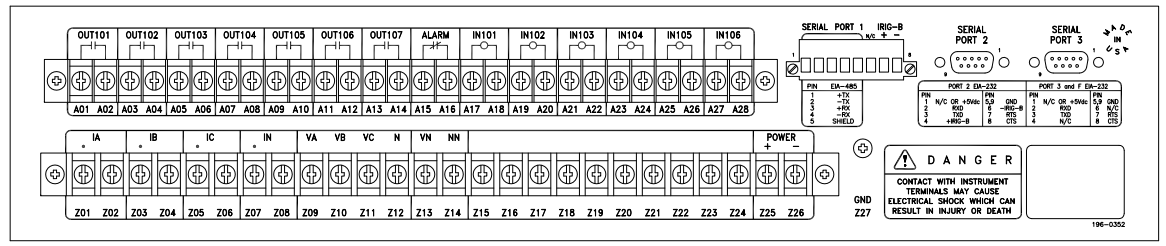

A005P688
SEL 300G
52-G3

TSW1323A

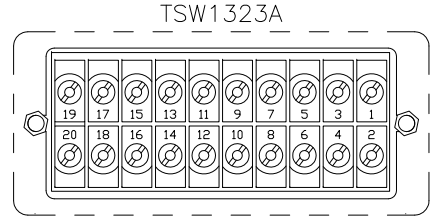

A006X609

TSW1323

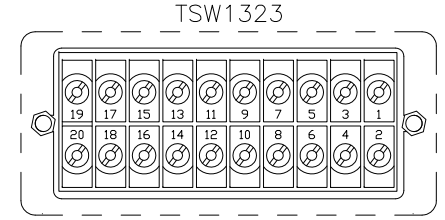

A014T691

LT1422

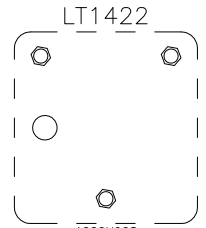

A000H908

LOR1418

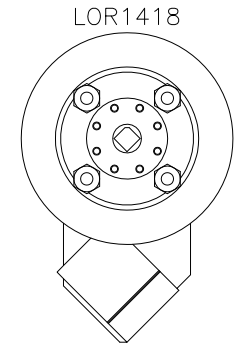

A005R200

REAR DOOR VIEW

PC NO.	LTR	NO.	REVISION	ZONE	DRA	CHKR	APRV	DATE
PC104235	01	A	PRODUCTION RELEASE AS-BUILT	–	VS	VS	KT	06/17/10

PROJECT:
ARECIBO OBSERVATORY SWITCHGEAR
SG S1A DOOR PANEL LAYOUT
DISTRIBUTOR:
CUMMINS CARIBBEAN
7071681

DO NOT SCALE PRINT

ANG TOL | DRAWN TO SCALE OF

AUTOCAD DWG

SIM TO | COPIED FROM | THREE ANGLE PROJECTION

THIS DOCUMENT IS THE PROPERTY OF CUMMINS POWER GENERATION. IT CONTAINS PROPRIETARY AND CONFIDENTIAL INFORMATION WHICH MUST NOT BE DUPLICATED, USED OR DISCLOSED OTHER THAN EXPRESSLY AUTHORIZED BY CUMMINS POWER GENERATION OR ITS REPRESENTATIVE

PART NO.	DWG SIZE	DESCRIPTION OF MATERIAL	REF DES

	NAME	DATE
DR	V.SAKLANI	06/17/10
CHKR ☐ MFG ☐	V. SIVAN	06/17/10
APPROVED	K.TWUMASI	06/17/10

FOR INTERPRETATION OF DIMENSIONING AND TOLERANCING, SEE ANSI Y14.5M-1982

MODEL FIRST USED ON PCIL2004R-772F

SITE CODE PGA

CUMMINS POWER GENERATION
1400 73rd AVE. NE
MINNEAPOLIS, MN 55432

TITLE WD-SCHEMATISC

DWG NO. A030S865 | SHEET 38 OF 61 | DWG SIZE D

TAGS	QTY	SUB	CATALOG	CPG LEGACY	MFG	DESCRIPTION
KP1331	1		A005P688	0307-3033-08	SCHWEITZER	PROTECTIVE RELAY (SEL 300G MULTIFUNCT) SEL-300G 48-125 VDC PS/ 125 VDC CV W/ DIFFERENTIAL PROJECTION MOUNT 0300G105325XX4X
LOR1418	1		A005R200	0307-2981-09	ELECTROSWITCH	LOCKOUT RELAY /W INDICATOR 4 DECK 125VDC RED LED INDICATOR, MAINTAINED CONTACTS 20A, 600V 78PA04D-011
LT1422	1		A000H908	0308-1117-02	ELECTROSWITCH	BEZEL - BREAKER STATUS LIGHTS BREAKER STATUS 48-125 VDC RED & GRN LED INDICATED 658PB201LA
TSW1323A	1		A006X609	0308-1156-01	ABB	RELAY TEST SWITCH - 6 CURRENT, 4 POTENTIAL 4 POLE 6 POLE 498A010G01
TSW1323	1		A014T691	0308-1156-05	ABB	RELAY TEST SWITCH - 8 CURRENT 8 POLE 9672A10G01

PC NO.	LTR	NO.	REVISION	ZONE	DRA	CHKR	APRV	DATE
PC104235	01	A	PRODUCTION RELEASE AS-BUILT	-	VS	VS	KT	06/17/10

PROJECT:
ARECIBO OBSERVATORY SWITCHGEAR
SG S1A DOOR PANEL LAYOUT BOM
DISTRIBUTOR:
CUMMINS CARIBBEAN
7071681

DO NOT SCALE PRINT

ANG TOL | DRAWN TO SCALE OF

AUTOCAD DWG

SIM TO | COPIED FROM | THREE ANGLE PROJECTION

THIS DOCUMENT IS THE PROPERTY OF CUMMINS POWER GENERATION. IT CONTAINS PROPRIETARY AND CONFIDENTIAL INFORMATION WHICH MUST NOT BE DUPLICATED, USED OR DISCLOSED OTHER THAN EXPRESSLY AUTHORIZED BY CUMMINS POWER GENERATION OR ITS REPRESENTATIVE

PART NO.	DWG SIZE	DESCRIPTION OF MATERIAL	REF DES

	NAME	DATE
DR	V.SAKLANI	06/17/10
CHKR / MFG	V. SIVAN	06/17/10
APPROVED	K.TWUMASI	06/17/10

FOR INTERPRETATION OF DIMENSIONING AND TOLERANCING, SEE ANSI Y14.5M-1982

MODEL FIRST USED ON PCIL2004R-772F

SITE CODE PGA

CUMMINS POWER GENERATION
1400 73rd AVE. NE
MINNEAPOLIS, MN 55432

TITLE WD-SCHEMATISC

DWG NO. A030S865

SHEET 39 OF 61

DWG SIZE D

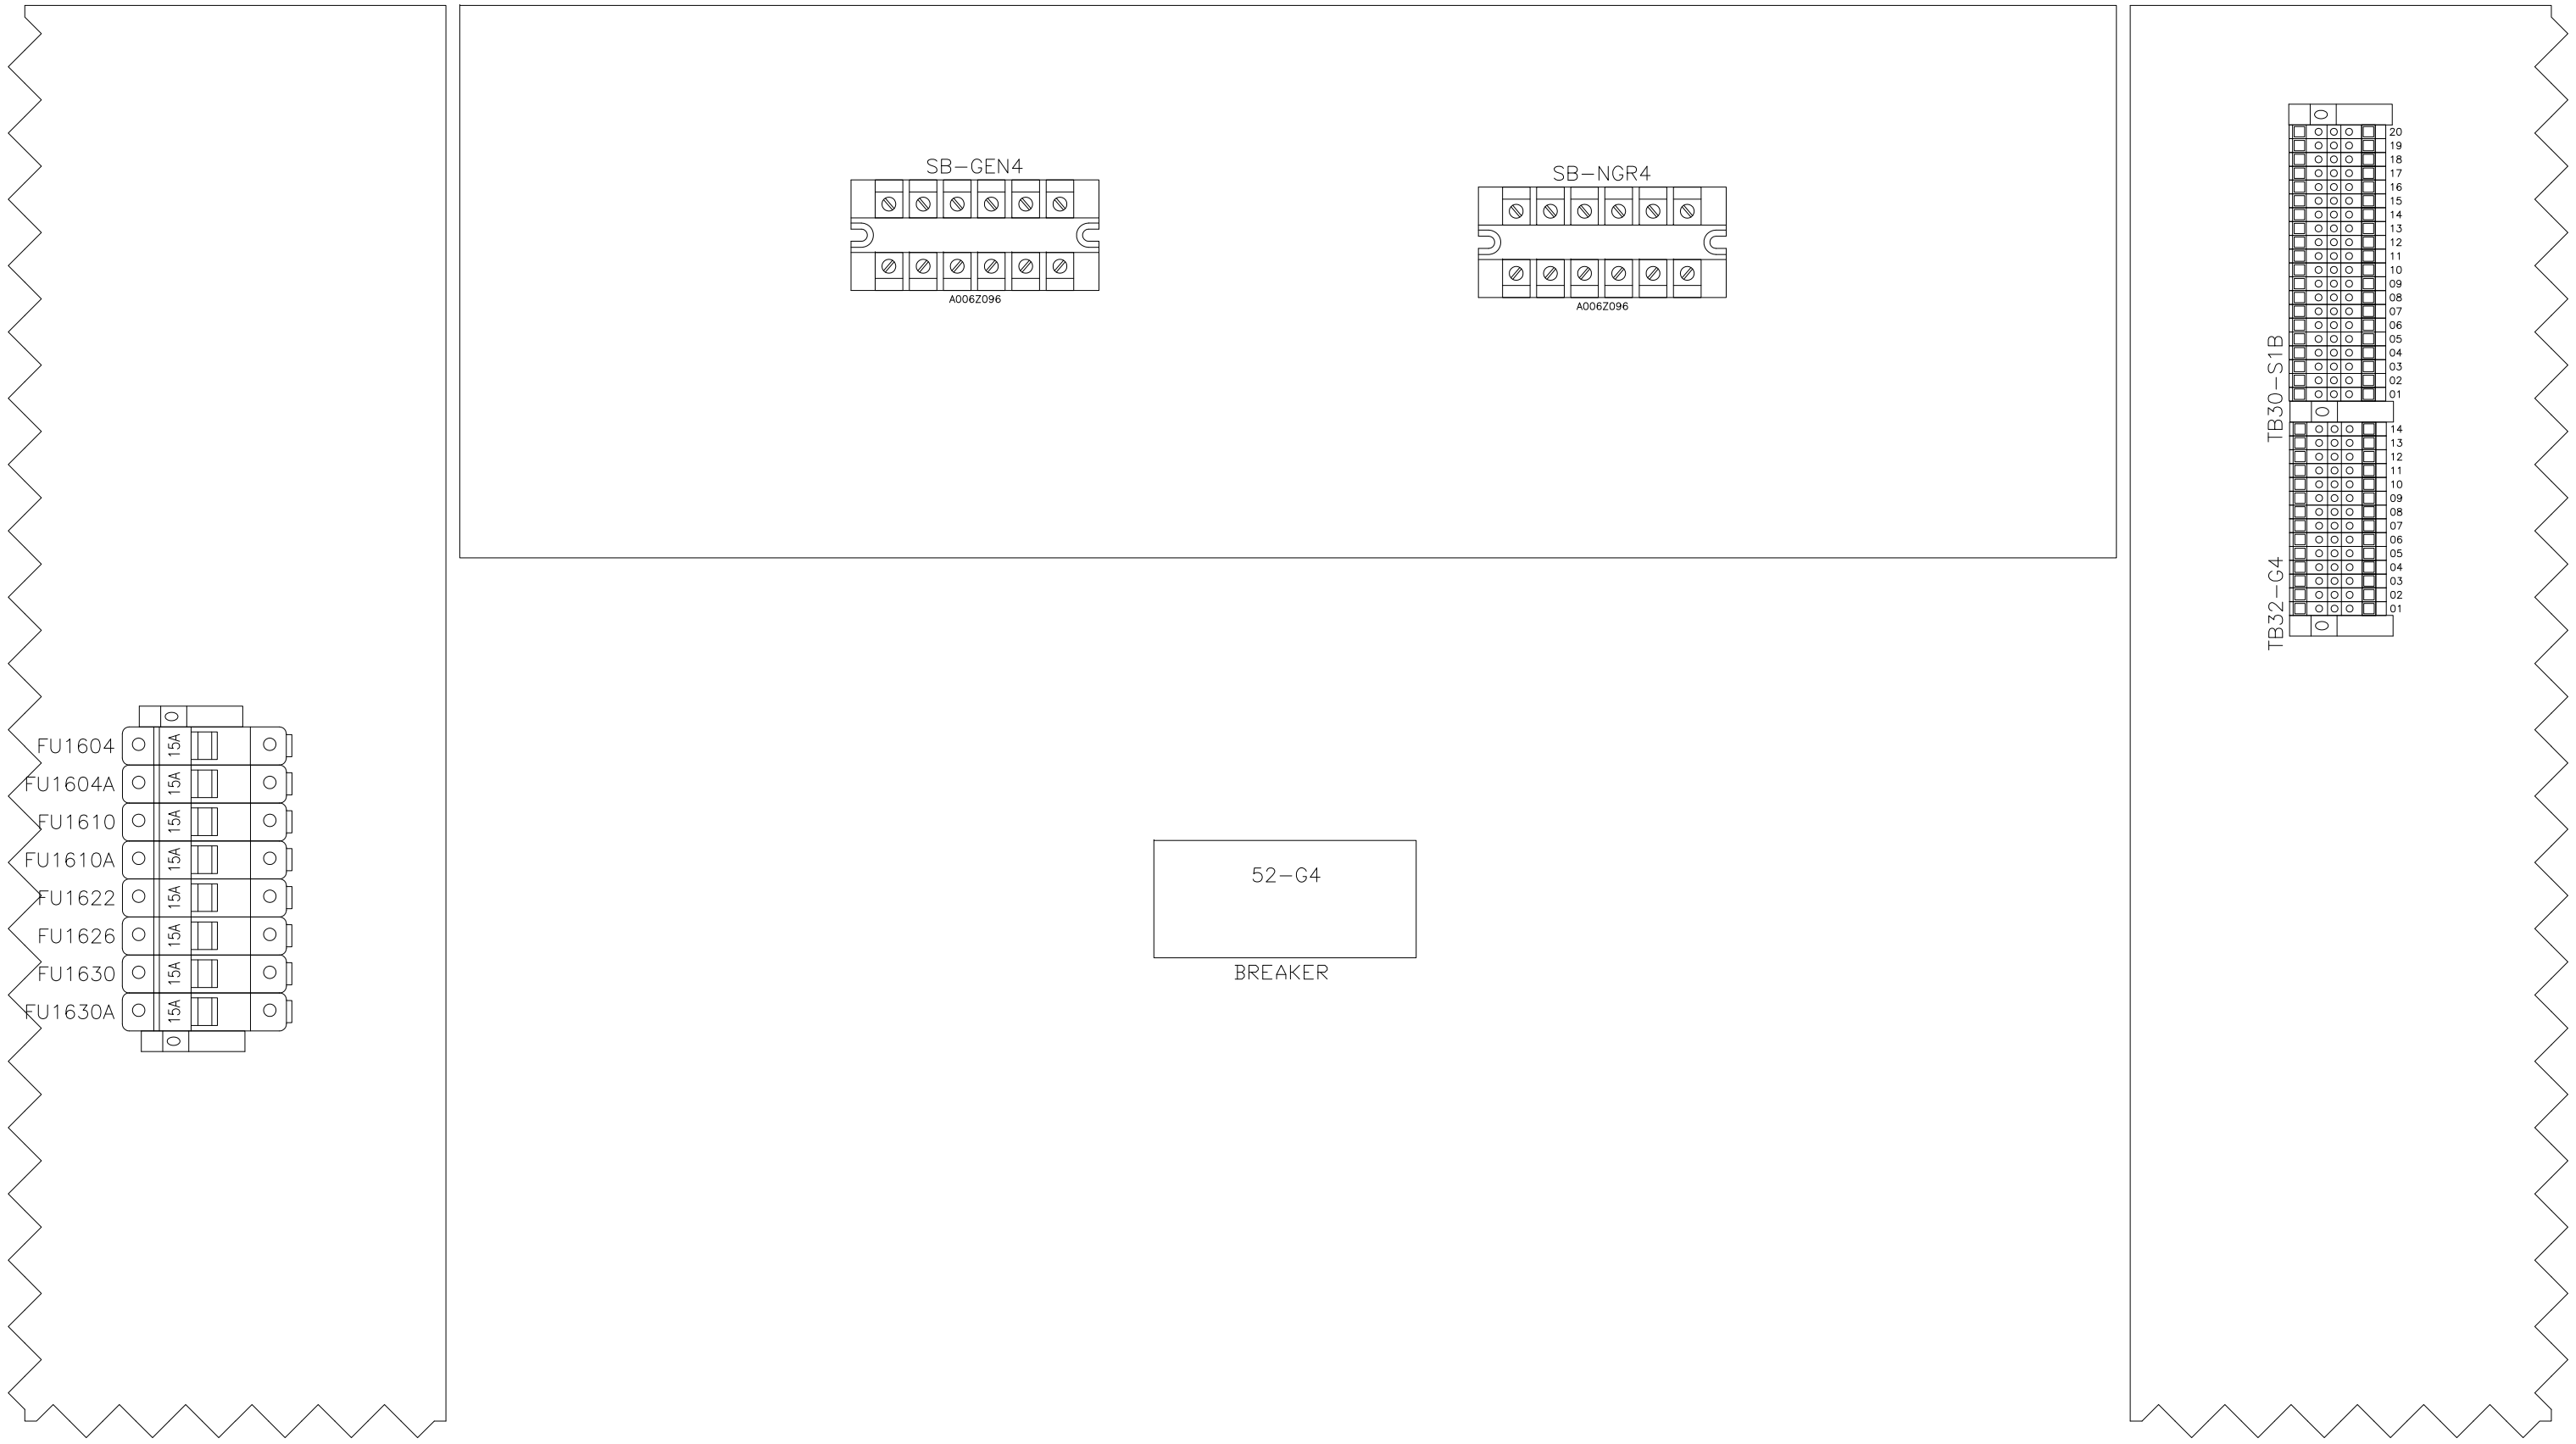

PC NO.	LTR	NO.	REVISION	ZONE	DRA	CHKR	APRV	DATE
PC104235	01	A	PRODUCTION RELEASE AS-BUILT	–	VS	VS	KT	06/17/10

PROJECT:
ARECIBO OBSERVATORY SWITCHGEAR
SG S1B CELL PANEL LAYOUT
DISTRIBUTOR:
CUMMINS CARIBBEAN
7071681

DO NOT SCALE PRINT

AUTOCAD DWG

SIM TO
COPIED FROM
THREE ANGLE PROJECTION
ANG TOL
DRAWN TO SCALE OF

THIS DOCUMENT IS THE PROPERTY OF CUMMINS POWER GENERATION. IT CONTAINS PROPRIETARY AND CONFIDENTIAL INFORMATION WHICH MUST NOT BE DUPLICATED, USED OR DISCLOSED OTHER THAN EXPRESSLY AUTHORIZED BY CUMMINS POWER GENERATION OR ITS REPRESENTATIVE

FOR INTERPRETATION OF DIMENSIONING AND TOLERANCING, SEE ANSI Y14.5M-1982

PART NO.	DWG SIZE	DESCRIPTION OF MATERIAL	REF DES

	NAME	DATE
DR	V.SAKLANI	06/17/10
CHKR / MFG	V. SIVAN	06/17/10
APPROVED	K.TWUMASI	06/17/10

MODEL FIRST USED ON: PCIL2004R-772F

SITE CODE: PGA

CUMMINS POWER GENERATION
1400 73rd AVE. NE
MINNEAPOLIS, MN 55432

TITLE: WD-SCHEMATISC

DWG NO. A030S865

SHEET 40 OF 61

DWG SIZE D

TAGS	QTY	SUB	CATALOG	CPG LEGACY	MFG	DESCRIPTION
52-G4	1		MV LOWER CELL		SQUARE D	CIRCUIT BREAKER VENDOR
FU1604 FU1604A FU1610 FU1610A FU1622 FU1626 FU1630 FU1630A	8	*1	A002K943	0321-0363-30	BUSSMANN	FUSE - CLASS CC TIME DELAY, CURRENT LIMITING 15AMPS 600VAC LP-CC-15 USE WITH FUSE BLOCK 0321-0344
		*1	A002L124	0321-0344	GOULD	1 POLE FUSE BLOCK - CLASS CC FUSE HOLDER 1/10-30AMPS 600VAC PRESSURE PLATE TERM USCC1 USE WITH FUSES LP-CC*
SB-GEN4 SB-NGR4	2		A006Z096	0332-3178-01	CUMMINS	TERMINAL BLOCK SHORTING BLOCK 600V, 30A 6 TERMINAL
STN-S1 STT-S1	2		SQD SHORTING BLOCK		SQUARE D	SUPPLIED BY SQUARE D SHORTING BLOCK 6 TERMINAL BY SQUARE D
TB30-S1B TB32-G4	34		A006Z117	0332-3125-01	WEIDMULLER	TERMINAL BLOCK SINGLE LEVEL 600V, 20A SINGLE LEVEL, FEED THROUGH 22-12 AWG 3804.6

PC NO.	LTR	NO.	REVISION	ZONE	DRA	CHKR	APRV	DATE
PC104235	01	A	PRODUCTION RELEASE AS-BUILT	-	VS	VS	KT	06/17/10

PROJECT:
ARECIBO OBSERVATORY SWITCHGEAR
SG S1B CELL PANEL LAYOUT BOM
DISTRIBUTOR:
CUMMINS CARIBBEAN
7071681

DO NOT SCALE PRINT

ANG TOL | DRAWN TO SCALE OF

AUTOCAD DWG

SIM TO | COPIED FROM | THREE ANGLE PROJECTION

THIS DOCUMENT IS THE PROPERTY OF CUMMINS POWER GENERATION. IT CONTAINS PROPRIETARY AND CONFIDENTIAL INFORMATION WHICH MUST NOT BE DUPLICATED, USED OR DISCLOSED OTHER THAN EXPRESSLY AUTHORIZED BY CUMMINS POWER GENERATION OR ITS REPRESENTATIVE

PART NO.	DWG SIZE	DESCRIPTION OF MATERIAL	REF DES

	NAME	DATE
DR	V.SAKLANI	06/17/10
CHKR / MFG	V. SIVAN	06/17/10
APPROVED	K.TWUMASI	06/17/10

FOR INTERPRETATION OF DIMENSIONING AND TOLERANCING, SEE ANSI Y14.5M-1982

MODEL FIRST USED ON: PCIL2004R-772F

SITE CODE: PGA

CUMMINS POWER GENERATION
1400 73rd AVE NE
MINNEAPOLIS, MN 55432

TITLE: WD-SCHEMATISC

DWG NO. A030S865 | SHEET 41 OF 61 | DWG SIZE D

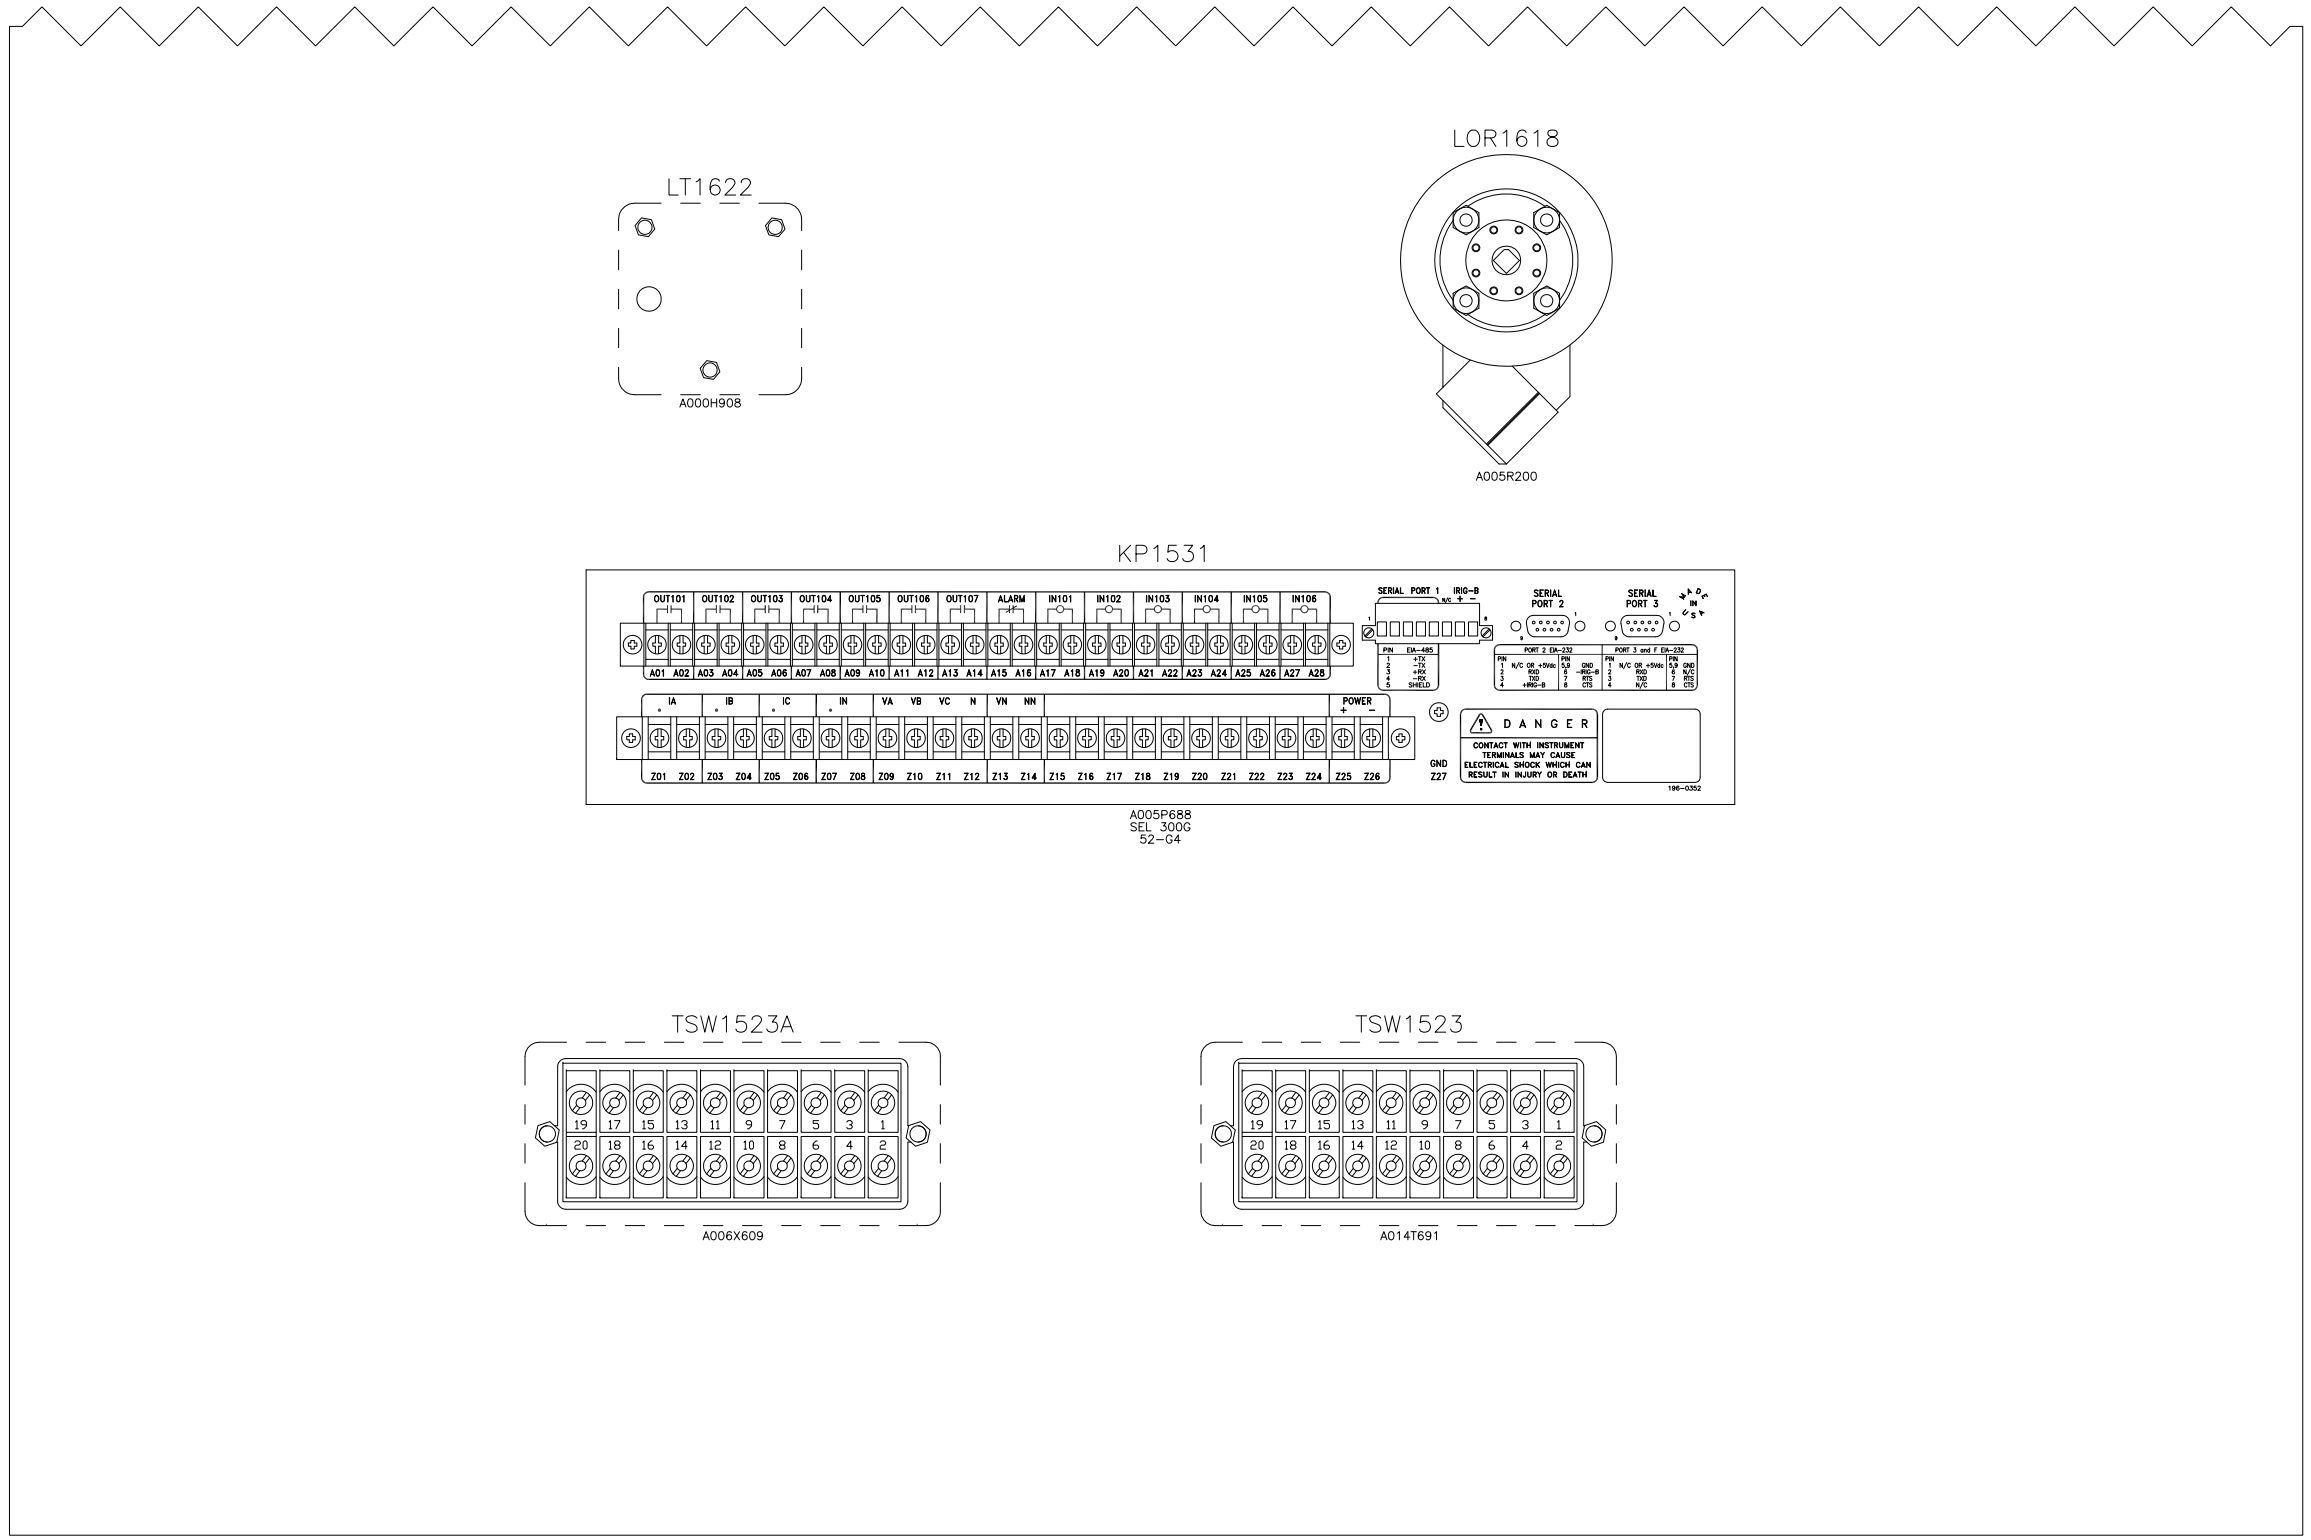

REAR DOOR VIEW

PC NO.	LTR	NO.	REVISION	ZONE	DRA	CHKR	APRV	DATE
PC104235	01	A	PRODUCTION RELEASE AS-BUILT	–	VS	VS	KT	06/17/10

PROJECT:
ARECIBO OBSERVATORY SWITCHGEAR
SG S1B DOOR PANEL LAYOUT
DISTRIBUTOR:
CUMMINS CARIBBEAN
7071681

DO NOT SCALE PRINT

ANG TOL | DRAWN TO SCALE OF

AUTOCAD DWG

SIM TO | COPIED FROM | THREE ANGLE PROJECTION

THIS DOCUMENT IS THE PROPERTY OF CUMMINS POWER GENERATION. IT CONTAINS PROPRIETARY AND CONFIDENTIAL INFORMATION WHICH MUST NOT BE DUPLICATED, USED OR DISCLOSED OTHER THAN EXPRESSLY AUTHORIZED BY CUMMINS POWER GENERATION OR ITS REPRESENTATIVE

PART NO.	DWG SIZE	DESCRIPTION OF MATERIAL	REF DES

	NAME	DATE
DR	V.SAKLANI	06/17/10
CHKR ☐ MFG ☐	V. SIVAN	06/17/10
APPROVED	K.TWUMASI	06/17/10

FOR INTERPRETATION OF DIMENSIONING AND TOLERANCING, SEE ANSI Y14.5M-1982

MODEL FIRST USED ON: PCIL2004R-772F

SITE CODE: PGA

CUMMINS POWER GENERATION
1400 73rd AVE. NE
MINNEAPOLIS, MN 55432

TITLE: WD-SCHEMATISC

DWG NO. A030S865 | SHEET 42 OF 61 | DWG SIZE D

TAGS	QTY	SUB	CATALOG	CPG LEGACY	MFG	DESCRIPTION
KP1531	1		A005P688	0307-3033-08	SCHWEITZER	PROTECTIVE RELAY (SEL 300G MULTIFUNCT) SEL-300G 48-125 VDC PS/ 125 VDC CV W/ DIFFERENTIAL PROJECTION MOUNT 0300G105325XX4X
LOR1618	1		A005R200	0307-2981-09	ELECTROSWITCH	LOCKOUT RELAY /W INDICATOR 4 DECK 125VDC RED LED INDICATOR, MAINTAINED CONTACTS 20A, 600V 78PA04D-011
LT1622	1		A000H908	0308-1117-02	ELECTROSWITCH	BEZEL - BREAKER STATUS LIGHTS BREAKER STATUS 48-125 VDC RED & GRN LED INDICATED 658PB201LA
TSW1523A	1		A006X609	0308-1156-01	ABB	RELAY TEST SWITCH - 6 CURRENT, 4 POTENTIAL 4 POLE 6 POLE 498A010G01
TSW1523	1		A014T691	0308-1156-05	ABB	RELAY TEST SWITCH - 8 CURRENT 8 POLE 9672A10G01

PC NO.	LTR	NO.	REVISION	ZONE	DRA	CHKR	APRV	DATE
PC104235	01	A	PRODUCTION RELEASE AS-BUILT	-	VS	VS	KT	06/17/10

PROJECT:
ARECIBO OBSERVATORY SWITCHGEAR
SG S1B DOOR PANEL LAYOUT BOM
DISTRIBUTOR:
CUMMINS CARIBBEAN
7071681

DO NOT SCALE PRINT

ANG TOL | DRAWN TO SCALE OF

AUTOCAD DWG

SIM TO | COPIED FROM | THREE ANGLE PROJECTION

THIS DOCUMENT IS THE PROPERTY OF CUMMINS POWER GENERATION. IT CONTAINS PROPRIETARY AND CONFIDENTIAL INFORMATION WHICH MUST NOT BE DUPLICATED, USED OR DISCLOSED OTHER THAN EXPRESSLY AUTHORIZED BY CUMMINS POWER GENERATION OR ITS REPRESENTATIVE

PART NO.	DWG SIZE	DESCRIPTION OF MATERIAL	REF DES

	NAME	DATE
DR	V.SAKLANI	06/17/10
CHKR	V. SIVAN	06/17/10
APPROVED	K.TWUMASI	06/17/10

FOR INTERPRETATION OF DIMENSIONING AND TOLERANCING, SEE ANSI Y14.5M-1982

MODEL FIRST USED ON PCIL2004R-772F

SITE CODE PGA

CUMMINS POWER GENERATION
1400 73rd AVE.NE
MINNEAPOLIS, MN 55432

TITLE WD-SCHEMATISC

DWG NO. A030S865

SHEET 43 OF 61

DWG SIZE D

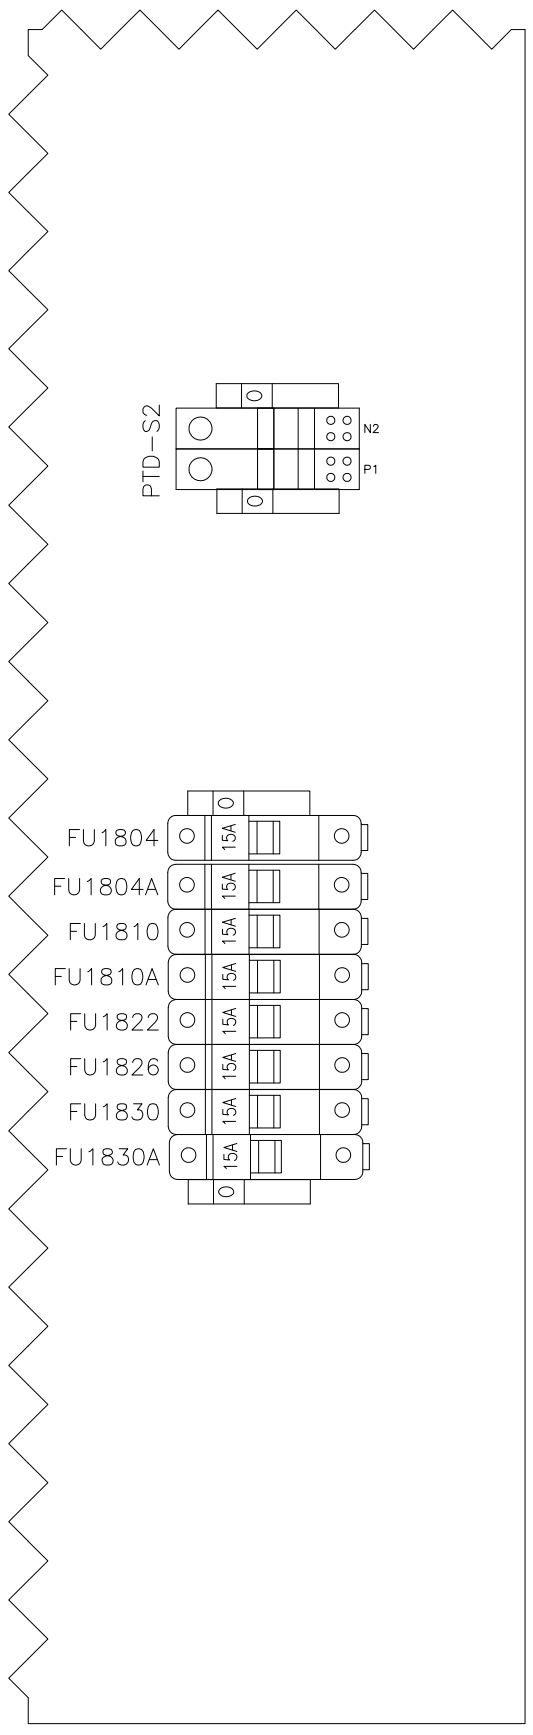

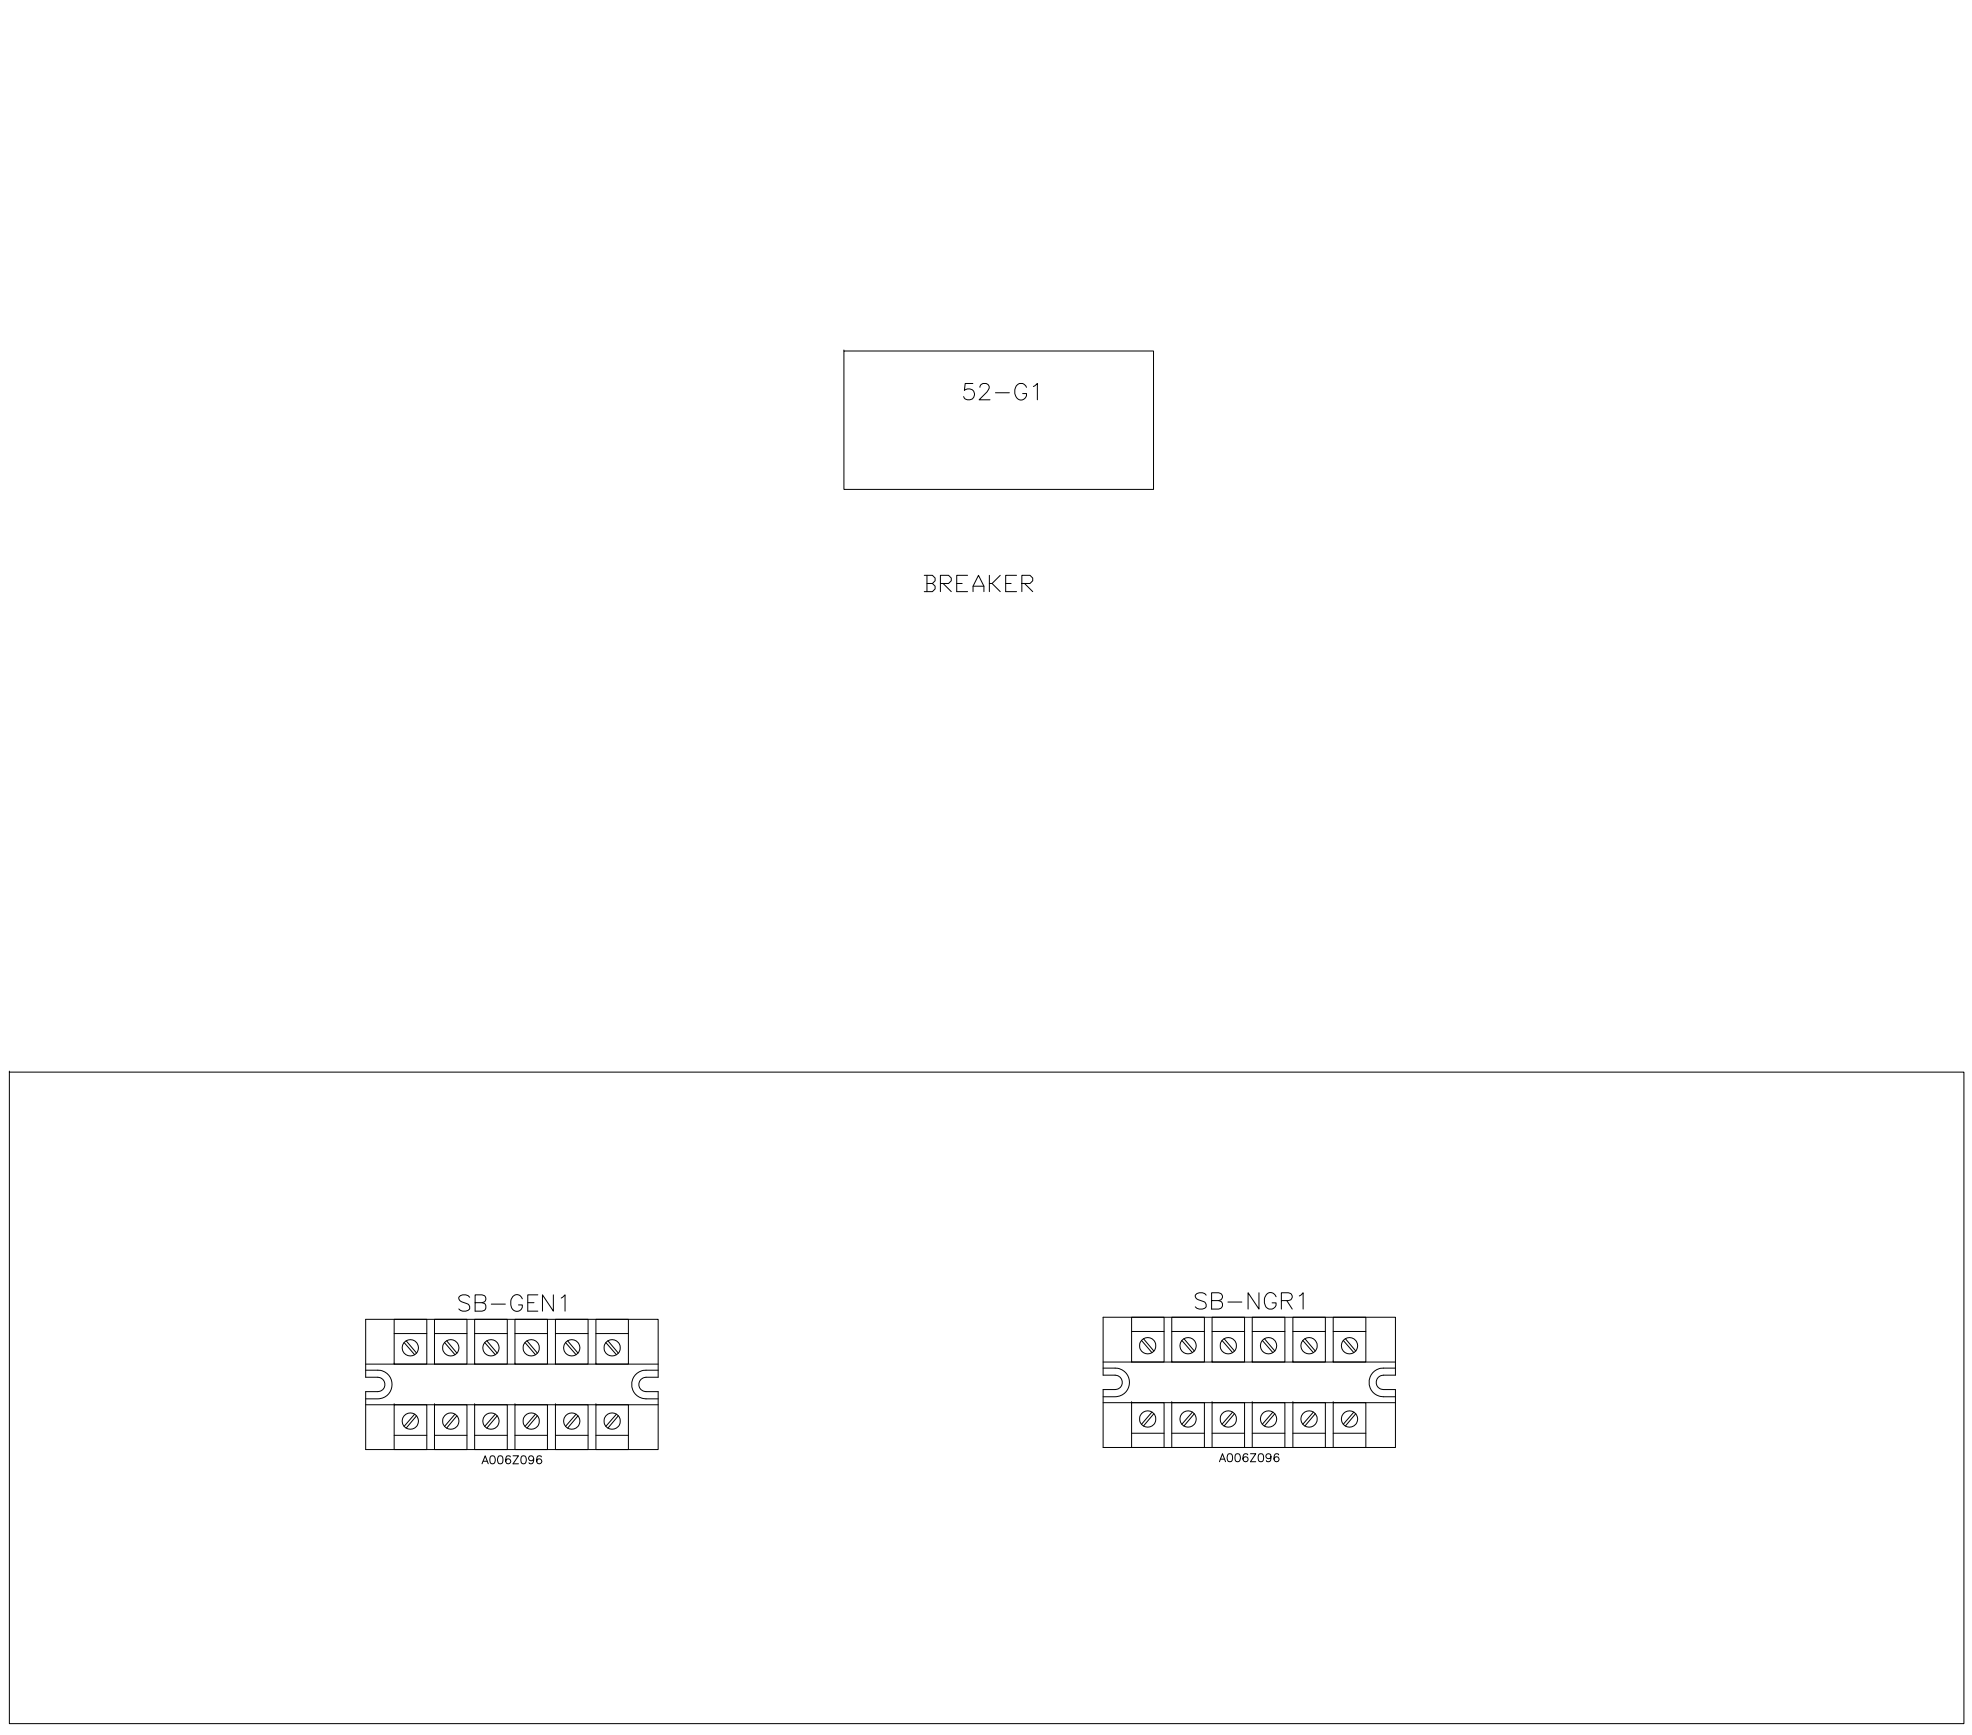

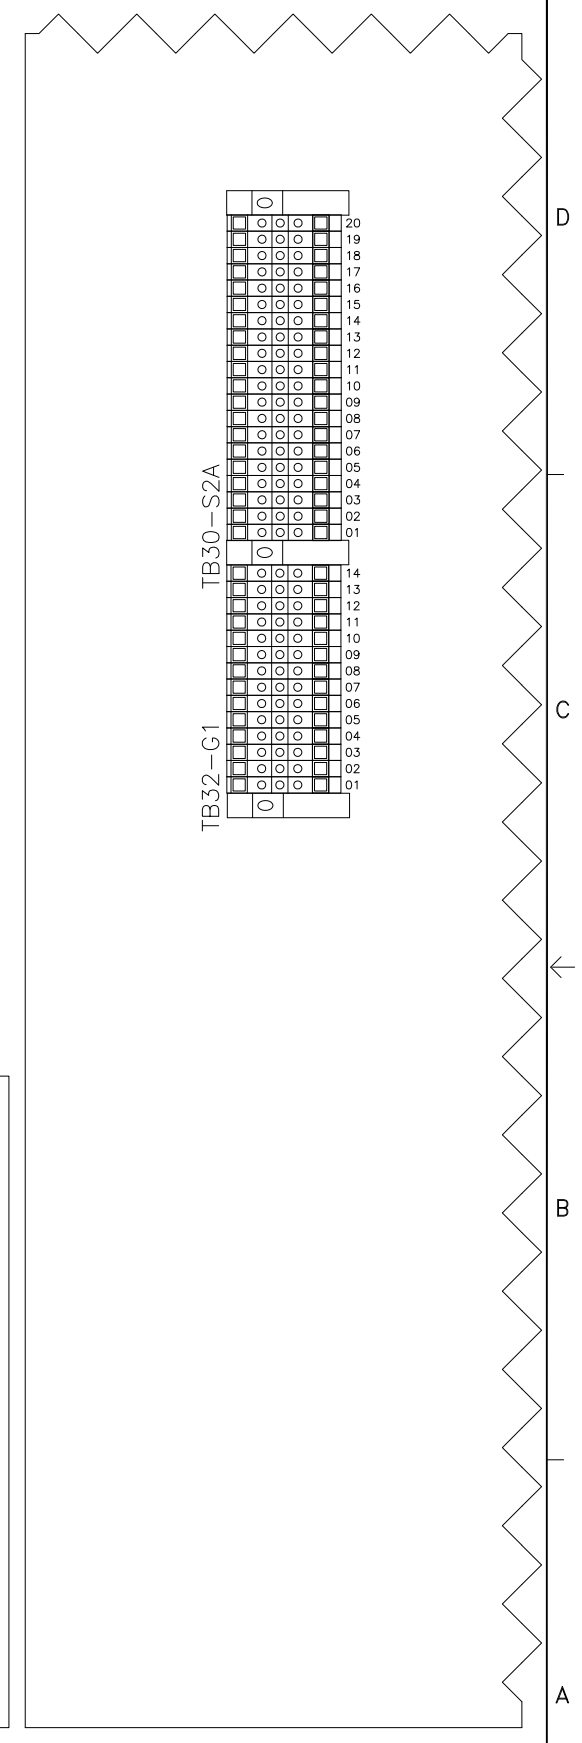

PC NO.	LTR	NO.	REVISION	ZONE	DRA	CHKR	APRV	DATE
PC104235	01	A	PRODUCTION RELEASE AS-BUILT	–	VS	VS	KT	06/17/10

PROJECT:
ARECIBO OBSERVATORY SWITCHGEAR
SG S2A CELL PANEL LAYOUT
DISTRIBUTOR:
CUMMINS CARIBBEAN
7071681

DO NOT SCALE PRINT

ANG TOL | DRAWN TO SCALE OF

AUTOCAD DWG

SIM TO | COPIED FROM | THREE ANGLE PROJECTION

THIS DOCUMENT IS THE PROPERTY OF CUMMINS POWER GENERATION. IT CONTAINS PROPRIETARY AND CONFIDENTIAL INFORMATION WHICH MUST NOT BE DUPLICATED, USED OR DISCLOSED OTHER THAN EXPRESSLY AUTHORIZED BY CUMMINS POWER GENERATION OR ITS REPRESENTATIVE

PART NO.	DWG SIZE	DESCRIPTION OF MATERIAL	REF DES

	NAME	DATE
DR	V.SAKLANI	06/17/10
CHKR / MFG	V. SIVAN	06/17/10
APPROVED	K.TWUMASI	06/17/10

FOR INTERPRETATION OF DIMENSIONING AND TOLERANCING, SEE ANSI Y14.5M-1982

MODEL FIRST USED ON PCIL2004R-772F

SITE CODE PGA

CUMMINS POWER GENERATION
1400 73rd AVE.NE
MINNEAPOLIS, MN 55432

TITLE WD-SCHEMATISC

DWG NO. A030S865 | SHEET 44 OF 61 | DWG SIZE D

TAGS	QTY	SUB	CATALOG	CPG LEGACY	MFG	DESCRIPTION
52-G1	1		MV UPPER CELL		SQUARE D	CIRCUIT BREAKER VENDOR
FU1804 FU1804A FU1810 FU1810A FU1822 FU1826 FU1830 FU1830A	8	*1	A002K943	0321-0363-30	BUSSMANN	FUSE - CLASS CC TIME DELAY, CURRENT LIMITING 15AMPS 600VAC LP-CC-15 USE WITH FUSE BLOCK 0321-0344
		*1	A002L124	0321-0344	GOULD	1 POLE FUSE BLOCK - CLASS CC FUSE HOLDER 1/10-30AMPS 600VAC PRESSURE PLATE TERM USCC1 USE WITH FUSES LP-CC*
SB-GEN1 SB-NGR1	2		A006Z096	0332-3178-01	CUMMINS	TERMINAL BLOCK SHORTING BLOCK 600V, 30A 6 TERMINAL
PTD-S2	2		SQD PTD		SQUARE D	SUPPLIED BY SQUARE D TERMINAL DC BUS TERMINAL VENDOR SUPPLIED
STA-S2 STG-S2	2		SQD SHORTING BLOCK		SQUARE D	SUPPLIED BY SQUARE D SHORTING BLOCK 6 TERMINAL BY SQUARE D
TB30-S2A TB32-G1	34		A006Z117	0332-3125-01	WEIDMULLER	TERMINAL BLOCK SINGLE LEVEL 600V, 20A SINGLE LEVEL, FEED THROUGH 22-12 AWG 3804.6

PC NO.	LTR	NO.	REVISION	ZONE	DRA	CHKR	APRV	DATE
PC104235	01	A	PRODUCTION RELEASE AS-BUILT	-	VS	VS	KT	06/17/10

PROJECT:
ARECIBO OBSERVATORY SWITCHGEAR
SG S2A CELL PANEL LAYOUT BOM
DISTRIBUTOR:
CUMMINS CARIBBEAN
7071681

DO NOT SCALE PRINT

ANG TOL | DRAWN TO SCALE OF

AUTOCAD DWG

SIM TO | COPIED FROM | THREE ANGLE PROJECTION

THIS DOCUMENT IS THE PROPERTY OF CUMMINS POWER GENERATION. IT CONTAINS PROPRIETARY AND CONFIDENTIAL INFORMATION WHICH MUST NOT BE DUPLICATED, USED OR DISCLOSED OTHER THAN EXPRESSLY AUTHORIZED BY CUMMINS POWER GENERATION OR ITS REPRESENTATIVE

PART NO.	DWG SIZE	DESCRIPTION OF MATERIAL	REF DES

	NAME	DATE
DR	V.SAKLANI	06/17/10
CHKR ☐ MFG ☐	V. SIVAN	06/17/10
APPROVED	K.TWUMASI	06/17/10

FOR INTERPRETATION OF DIMENSIONING AND TOLERANCING, SEE ANSI Y14.5M-1982

MODEL FIRST USED ON PCIL2004R-772F

SITE CODE PGA

CUMMINS POWER GENERATION
1400 73rd AVE. NE
MINNEAPOLIS, MN 55432

TITLE WD-SCHEMATISC

DWG NO. A030S865 | SHEET 45 OF 61 | DWG SIZE D

KP1731

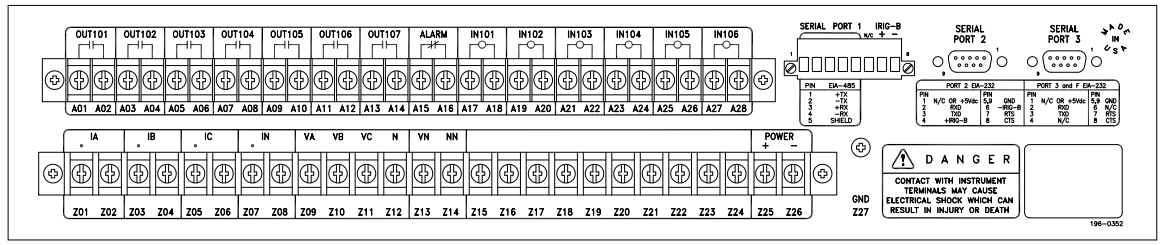

A005P688
SEL 300G
52-G1

TSW1723A

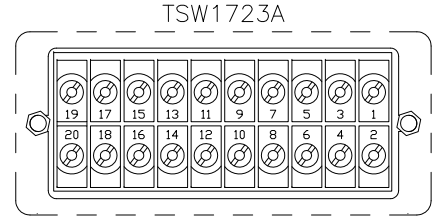

A006X609

TSW1723

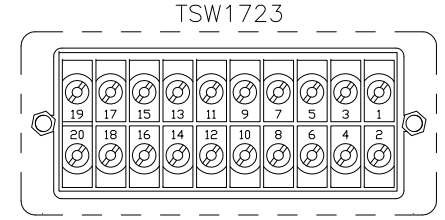

A014T691

LT1822

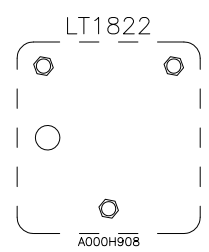

A000H908

LOR1818

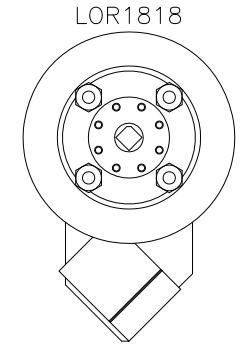

A005R200

REAR DOOR VIEW

PC NO.	LTR	NO.	REVISION	ZONE	DRA	CHKR	APRV	DATE
PC104235	01	A	PRODUCTION RELEASE AS-BUILT	–	VS	VS	KT	06/17/10

PROJECT:
ARECIBO OBSERVATORY SWITCHGEAR
SG S2A DOOR PANLE LAYOUT
DISTRIBUTOR:
CUMMINS CARIBBEAN
7071681

DO NOT SCALE PRINT

ANG TOL | DRAWN TO SCALE OF

AUTOCAD DWG

SIM TO | COPIED FROM | THREE ANGLE PROJECTION

THIS DOCUMENT IS THE PROPERTY OF CUMMINS POWER GENERATION. IT CONTAINS PROPRIETARY AND CONFIDENTIAL INFORMATION WHICH MUST NOT BE DUPLICATED, USED OR DISCLOSED OTHER THAN EXPRESSLY AUTHORIZED BY CUMMINS POWER GENERATION OR ITS REPRESENTATIVE

PART NO.	DWG SIZE	DESCRIPTION OF MATERIAL	REF DES

	NAME	DATE
DR	V.SAKLANI	06/17/10
CHKR / MFG	V. SIVAN	06/17/10
APPROVED	K.TWUMASI	06/17/10

FOR INTERPRETATION OF DIMENSIONING AND TOLERANCING, SEE ANSI Y14.5M-1982

MODEL FIRST USED ON PCIL2004R-772F

SITE CODE PGA

CUMMINS POWER GENERATION
1400 73rd AVE.NE
MINNEAPOLIS, MN 55432

TITLE WD-SCHEMATISC

DWG NO. A030S865 | SHEET 46 OF 61 | DWG SIZE D

TAGS	QTY	SUB	CATALOG	CPG LEGACY	MFG	DESCRIPTION
KP1731	1		A005P688	0307-3033-08	SCHWEITZER	PROTECTIVE RELAY (SEL 300G MULTIFUNCT) SEL-300G 48-125 VDC PS/ 125 VDC CV W/ DIFFERENTIAL PROJECTION MOUNT 0300G105325XX4X
LOR1818	1		A005R200	0307-2981-09	ELECTROSWITCH	LOCKOUT RELAY /W INDICATOR 4 DECK 125VDC RED LED INDICATOR, MAINTAINED CONTACTS 20A, 600V 78PAD4D-011
LT1822	1		A000H908	0308-1117-02	ELECTROSWITCH	BEZEL - BREAKER STATUS LIGHTS BREAKER STATUS 48-125 VDC RED & GRN LED INDICATED 658PB201LA
TSW1723A	1		A006X609	0308-1156-01	ABB	RELAY TEST SWITCH - 6 CURRENT, 4 POTENTIAL 4 POLE 6 POLE 498A010G01
TSW1723	1		A014T691	0308-1156-05	ABB	RELAY TEST SWITCH - 8 CURRENT 8 POLE 9672A10G01

PC NO.	LTR	NO.	REVISION	ZONE	DRA	CHKR	APRV	DATE
PC104235	01	A	PRODUCTION RELEASE AS-BUILT	-	VS	VS	KT	06/17/10

PROJECT:
ARECIBO OBSERVATORY SWITCHGEAR
SG S2A DOOR PANEL LAYOUT BOM
DISTRIBUTOR:
CUMMINS CARIBBEAN
7071681

DO NOT SCALE PRINT

ANG TOL | DRAWN TO SCALE OF

AUTOCAD DWG

SIM TO | COPIED FROM | THREE ANGLE PROJECTION

THIS DOCUMENT IS THE PROPERTY OF CUMMINS POWER GENERATION. IT CONTAINS PROPRIETARY AND CONFIDENTIAL INFORMATION WHICH MUST NOT BE DUPLICATED, USED OR DISCLOSED OTHER THAN EXPRESSLY AUTHORIZED BY CUMMINS POWER GENERATION OR ITS REPRESENTATIVE

PART NO.	DWG SIZE	DESCRIPTION OF MATERIAL	REF DES

	NAME	DATE
DR	V.SAKLANI	06/17/10
CHKR	V. SIVAN	06/17/10
MFG		
APPROVED	K.TWUMASI	06/17/10

FOR INTERPRETATION OF DIMENSIONING AND TOLERANCING, SEE ANSI Y14.5M-1982

MODEL FIRST USED ON PCIL2004R-772F

SITE CODE PGA

CUMMINS POWER GENERATION
1400 73rd AVE.NE
MINNEAPOLIS, MN 55432

TITLE WD-SCHEMATISC

DWG NO. A030S865 | SHEET 47 OF 61 | DWG SIZE D

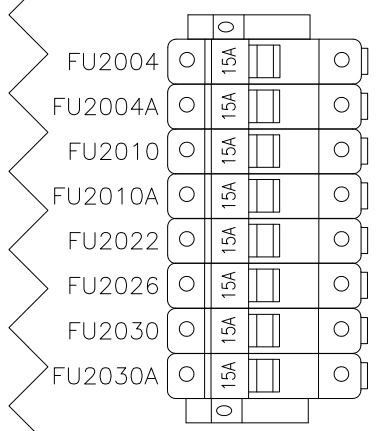

BREAKER

52-G2

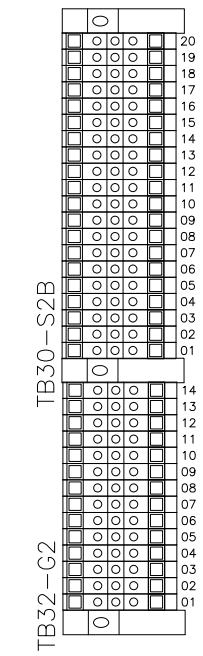

PC NO.	LTR	NO.	REVISION	ZONE	DRA	CHKR	APRV	DATE
PC104235	01	A	PRODUCTION RELEASE AS-BUILT	–	VS	VS	KT	06/17/10

PROJECT:
ARECIBO OBSERVATORY SWITCHGEAR
SG S2B CELL PANEL LAYOUT
DISTRIBUTOR:
CUMMINS CARIBBEAN
7071681

DO NOT SCALE PRINT

ANG TOL | DRAWN TO SCALE OF

AUTOCAD DWG

SIM TO | COPIED FROM | THREE ANGLE PROJECTION

THIS DOCUMENT IS THE PROPERTY OF CUMMINS POWER GENERATION. IT CONTAINS PROPRIETARY AND CONFIDENTIAL INFORMATION WHICH MUST NOT BE DUPLICATED, USED OR DISCLOSED OTHER THAN EXPRESSLY AUTHORIZED BY CUMMINS POWER GENERATION OR ITS REPRESENTATIVE

PART NO.	DWG SIZE	DESCRIPTION OF MATERIAL	REF DES

	NAME	DATE
DR	V.SAKLANI	06/17/10
CHKR	V. SIVAN	06/17/10
MFG		
APPROVED	K.TWUMASI	06/17/10

FOR INTERPRETATION OF DIMENSIONING AND TOLERANCING, SEE ANSI Y14.5M-1982

MODEL FIRST USED ON PCIL2004R-772F

SITE CODE PGA

CUMMINS POWER GENERATION
1400 73rd AVE. NE
MINNEAPOLIS, MN 55432

TITLE WD-SCHEMATISC

DWG NO. A030S865 | SHEET 48 OF 61 | DWG SIZE D

TAGS	QTY	SUB	CATALOG	CPG LEGACY	MFG	DESCRIPTION
52-G2	1		MV LOWER CELL		SQUARE D	CIRCUIT BREAKER VENDOR
FU2004 FU2004A FU2010 FU2010A FU2022 FU2026 FU2030 FU2030A	8	*1	A002K943	0321-0363-30	BUSSMANN	FUSE - CLASS CC TIME DELAY, CURRENT LIMITING 15AMPS 600VAC LP-CC-15 USE WITH FUSE BLOCK 0321-0344
		*1	A002L124	0321-0344	GOULD	1 POLE FUSE BLOCK - CLASS CC FUSE HOLDER 1/10-30AMPS 600VAC PRESSURE PLATE TERM USCC1 USE WITH FUSES LP-CC*
SB-GEN2 SB-NGR2	2		A006Z096	0332-3178-01	CUMMINS	TERMINAL BLOCK SHORTING BLOCK 600V, 30A 6 TERMINAL
STN-S2 STT-S2	2		SQD SHORTING BLOCK		SQUARE D	SUPPLIED BY SQUARE D SHORTING BLOCK 6 TERMINAL BY SQUARE D
TB30-S2B TB32-G2	34		A006Z117	0332-3125-01	WEIDMULLER	TERMINAL BLOCK SINGLE LEVEL 600V, 20A SINGLE LEVEL, FEED THROUGH 22-12 AWG 3804.6

PC NO.	LTR	NO.	REVISION	ZONE	DRA	CHKR	APRV	DATE
PC104235	01	A	PRODUCTION RELEASE AS-BUILT	-	VS	VS	KT	06/17/10

PROJECT:
ARECIBO OBSERVATORY SWITCHGEAR
SG S2B CELL PANEL LAYOUT BOM
DISTRIBUTOR:
CUMMINS CARIBBEAN
7071681

DO NOT SCALE PRINT

ANG TOL | DRAWN TO SCALE OF

AUTOCAD DWG

SIM TO | COPIED FROM | THREE ANGLE PROJECTION

THIS DOCUMENT IS THE PROPERTY OF CUMMINS POWER GENERATION. IT CONTAINS PROPRIETARY AND CONFIDENTIAL INFORMATION WHICH MUST NOT BE DUPLICATED, USED OR DISCLOSED OTHER THAN EXPRESSLY AUTHORIZED BY CUMMINS POWER GENERATION OR ITS REPRESENTATIVE

PART NO.	DWG SIZE	DESCRIPTION OF MATERIAL	REF DES

	NAME	DATE
DR	V.SAKLANI	06/17/10
CHKR / MFG	V. SIVAN	06/17/10
APPROVED	K.TWUMASI	06/17/10

FOR INTERPRETATION OF DIMENSIONING AND TOLERANCING, SEE ANSI Y14.5M-1982

MODEL FIRST USED ON PCIL2004R-772F

SITE CODE PGA

CUMMINS POWER GENERATION
1400 73rd AVE. NE
MINNEAPOLIS, MN 55432

TITLE WD-SCHEMATISC

DWG NO. A030S865 | SHEET 49 OF 61 | DWG SIZE D

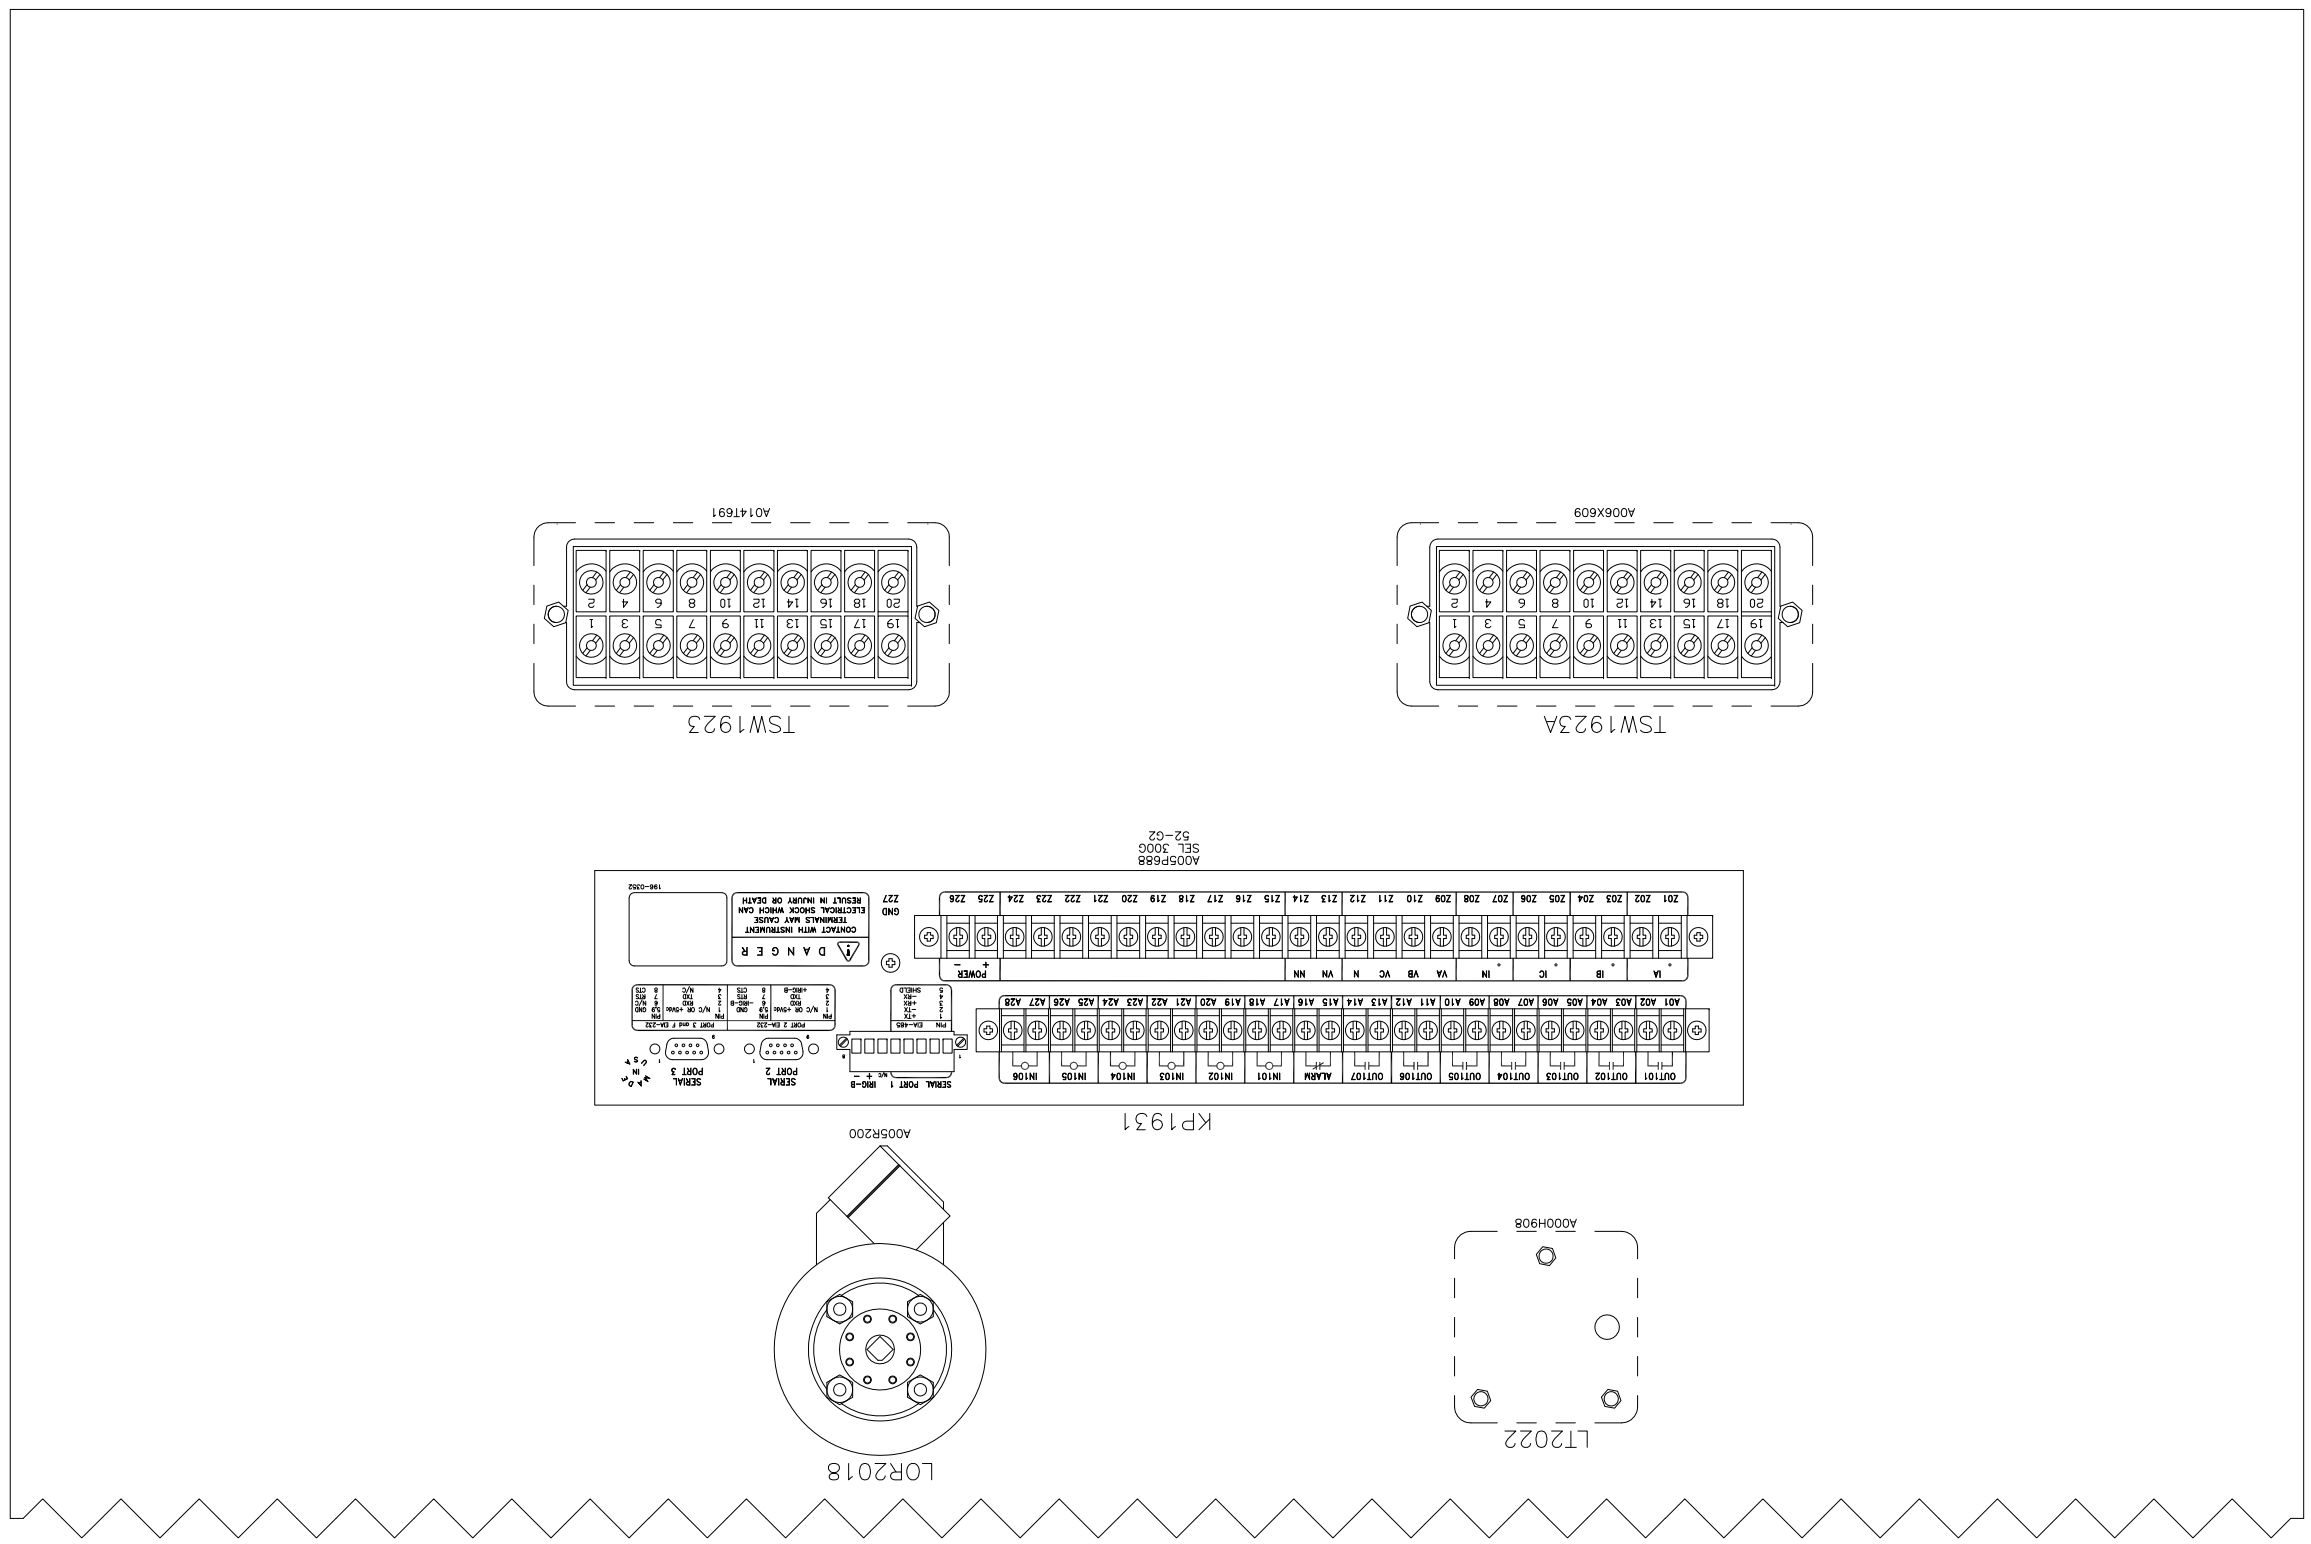

PC NO.	LTR	NO.	REVISION	ZONE	DRA	CHKR	APRV	DATE

PC NO.	LTR	NO.	REVISION	ZONE	DRA	CHKR	APRV	DATE
PC104235	01	A	PRODUCTION RELEASE AS-BUILT	–	VS	VS	KT	06/17/10

PROJECT:
ARECIBO OBSERVATORY SWITCHGEAR
SG 52B DOOR PANEL LAYOUT
DISTRIBUTOR:
CUMMINS CARIBBEAN
707168I

ANG TOL	DRAWN TO SCALE OF
THIS DOCUMENT IS THE PROPERTY OF CUMMINS POWER GENERATION. IT CONTAINS PROPRIETARY AND CONFIDENTIAL INFORMATION WHICH MUST NOT BE REPRODUCED, USED OR DISCLOSED EITHER IN WHOLE OR IN PART WITHOUT THE EXPRESS WRITTEN PERMISSION OF CUMMINS POWER GENERATION OR ITS REPRESENTATIVE	AUTOCAD DWG
THIRD ANGLE PROJECTION	SW 10
COMPD TRGW	DO NOT SCALE PRINT
Chkd MFG	OR V.SAKLANI 06/17/10
	V. SIVAN 06/17/10
	APPROVED K.TMUMASI 06/17/10
	SITE CODE
FOR INTERPRETATION OF DIMENSIONING AND TOLERANCING, SEE ANSI Y14.5M-1982	MODEL FIRST USED ON PCLL2004R-772F PGA
	TITLE WD-SCHEMATISC
	CUMMINS POWER GENERATION 1400 73rd AVE NE MINNEAPOLIS, MN 55432
	DWG NO. A030S865 SHEET 50 of 61 DWG SIZE D

PART NO.	DWG SIZE	DESCRIPTION OF MATERIAL	REF DES

TAGS	QTY	SUB	CATALOG	CPG LEGACY	MFG	DESCRIPTION
KP1931	1		A005P688	0307-3033-08	SCHWEITZER	PROTECTIVE RELAY (SEL 300G MULTIFUNCT) SEL-300G 48-125 VDC PS/ 125 VDC CV W/ DIFFERENTIAL PROJECTION MOUNT 0300G105325XX4X
LOR2018	1		A005R200	0307-2981-09	ELECTROSWITCH	LOCKOUT RELAY /W INDICATOR 4 DECK 125VDC RED LED INDICATOR, MAINTAINED CONTACTS 20A, 600V 78PA04D-011
LT2022	1		A000H908	0308-1117-02	ELECTROSWITCH	BEZEL - BREAKER STATUS LIGHTS BREAKER STATUS 48-125 VDC RED & GRN LED INDICATED 65BPB201LA
TSW1923A	1		A006X609	0308-1156-01	ABB	RELAY TEST SWITCH - 6 CURRENT, 4 POTENTIAL 4 POLE 6 POLE 49BA010G01
TSW1923	1		A014T691	0308-1156-05	ABB	RELAY TEST SWITCH - 8 CURRENT 8 POLE 9672A10G01

PC NO.	LTR	NO.	REVISION	ZONE	DRA	CHKR	APRV	DATE
PC104235	01	A	PRODUCTION RELEASE AS-BUILT	-	VS	VS	KT	06/17/10

PROJECT:
ARECIBO OBSERVATORY SWITCHGEAR
SG S2B DOOR PANEL LAYOUT BOM
DISTRIBUTOR:
CUMMINS CARIBBEAN
7071681

DO NOT SCALE PRINT

AUTOCAD DWG

SIM TO
COPIED FROM
THREE ANGLE PROJECTION
ANG TOL
DRAWN TO SCALE OF

THIS DOCUMENT IS THE PROPERTY OF CUMMINS POWER GENERATION. IT CONTAINS PROPRIETARY AND CONFIDENTIAL INFORMATION WHICH MUST NOT BE DUPLICATED, USED OR DISCLOSED OTHER THAN EXPRESSLY AUTHORIZED BY CUMMINS POWER GENERATION OR ITS REPRESENTATIVE

PART NO.	DWG SIZE	DESCRIPTION OF MATERIAL	REF DES

	NAME	DATE
DR	V.SAKLANI	06/17/10
CHKR / MFG	V. SIVAN	06/17/10
APPROVED	K.TWUMASI	06/17/10

FOR INTERPRETATION OF DIMENSIONING AND TOLERANCING, SEE ANSI Y14.5M-1982

MODEL FIRST USED ON PCIL2004R-772F

SITE CODE PGA

CUMMINS POWER GENERATION
1400 73rd AVE.NE
MINNEAPOLIS, MN 55432

TITLE WD-SCHEMATISC

DWG NO. A030S865

SHEET 51 OF 61

DWG SIZE D

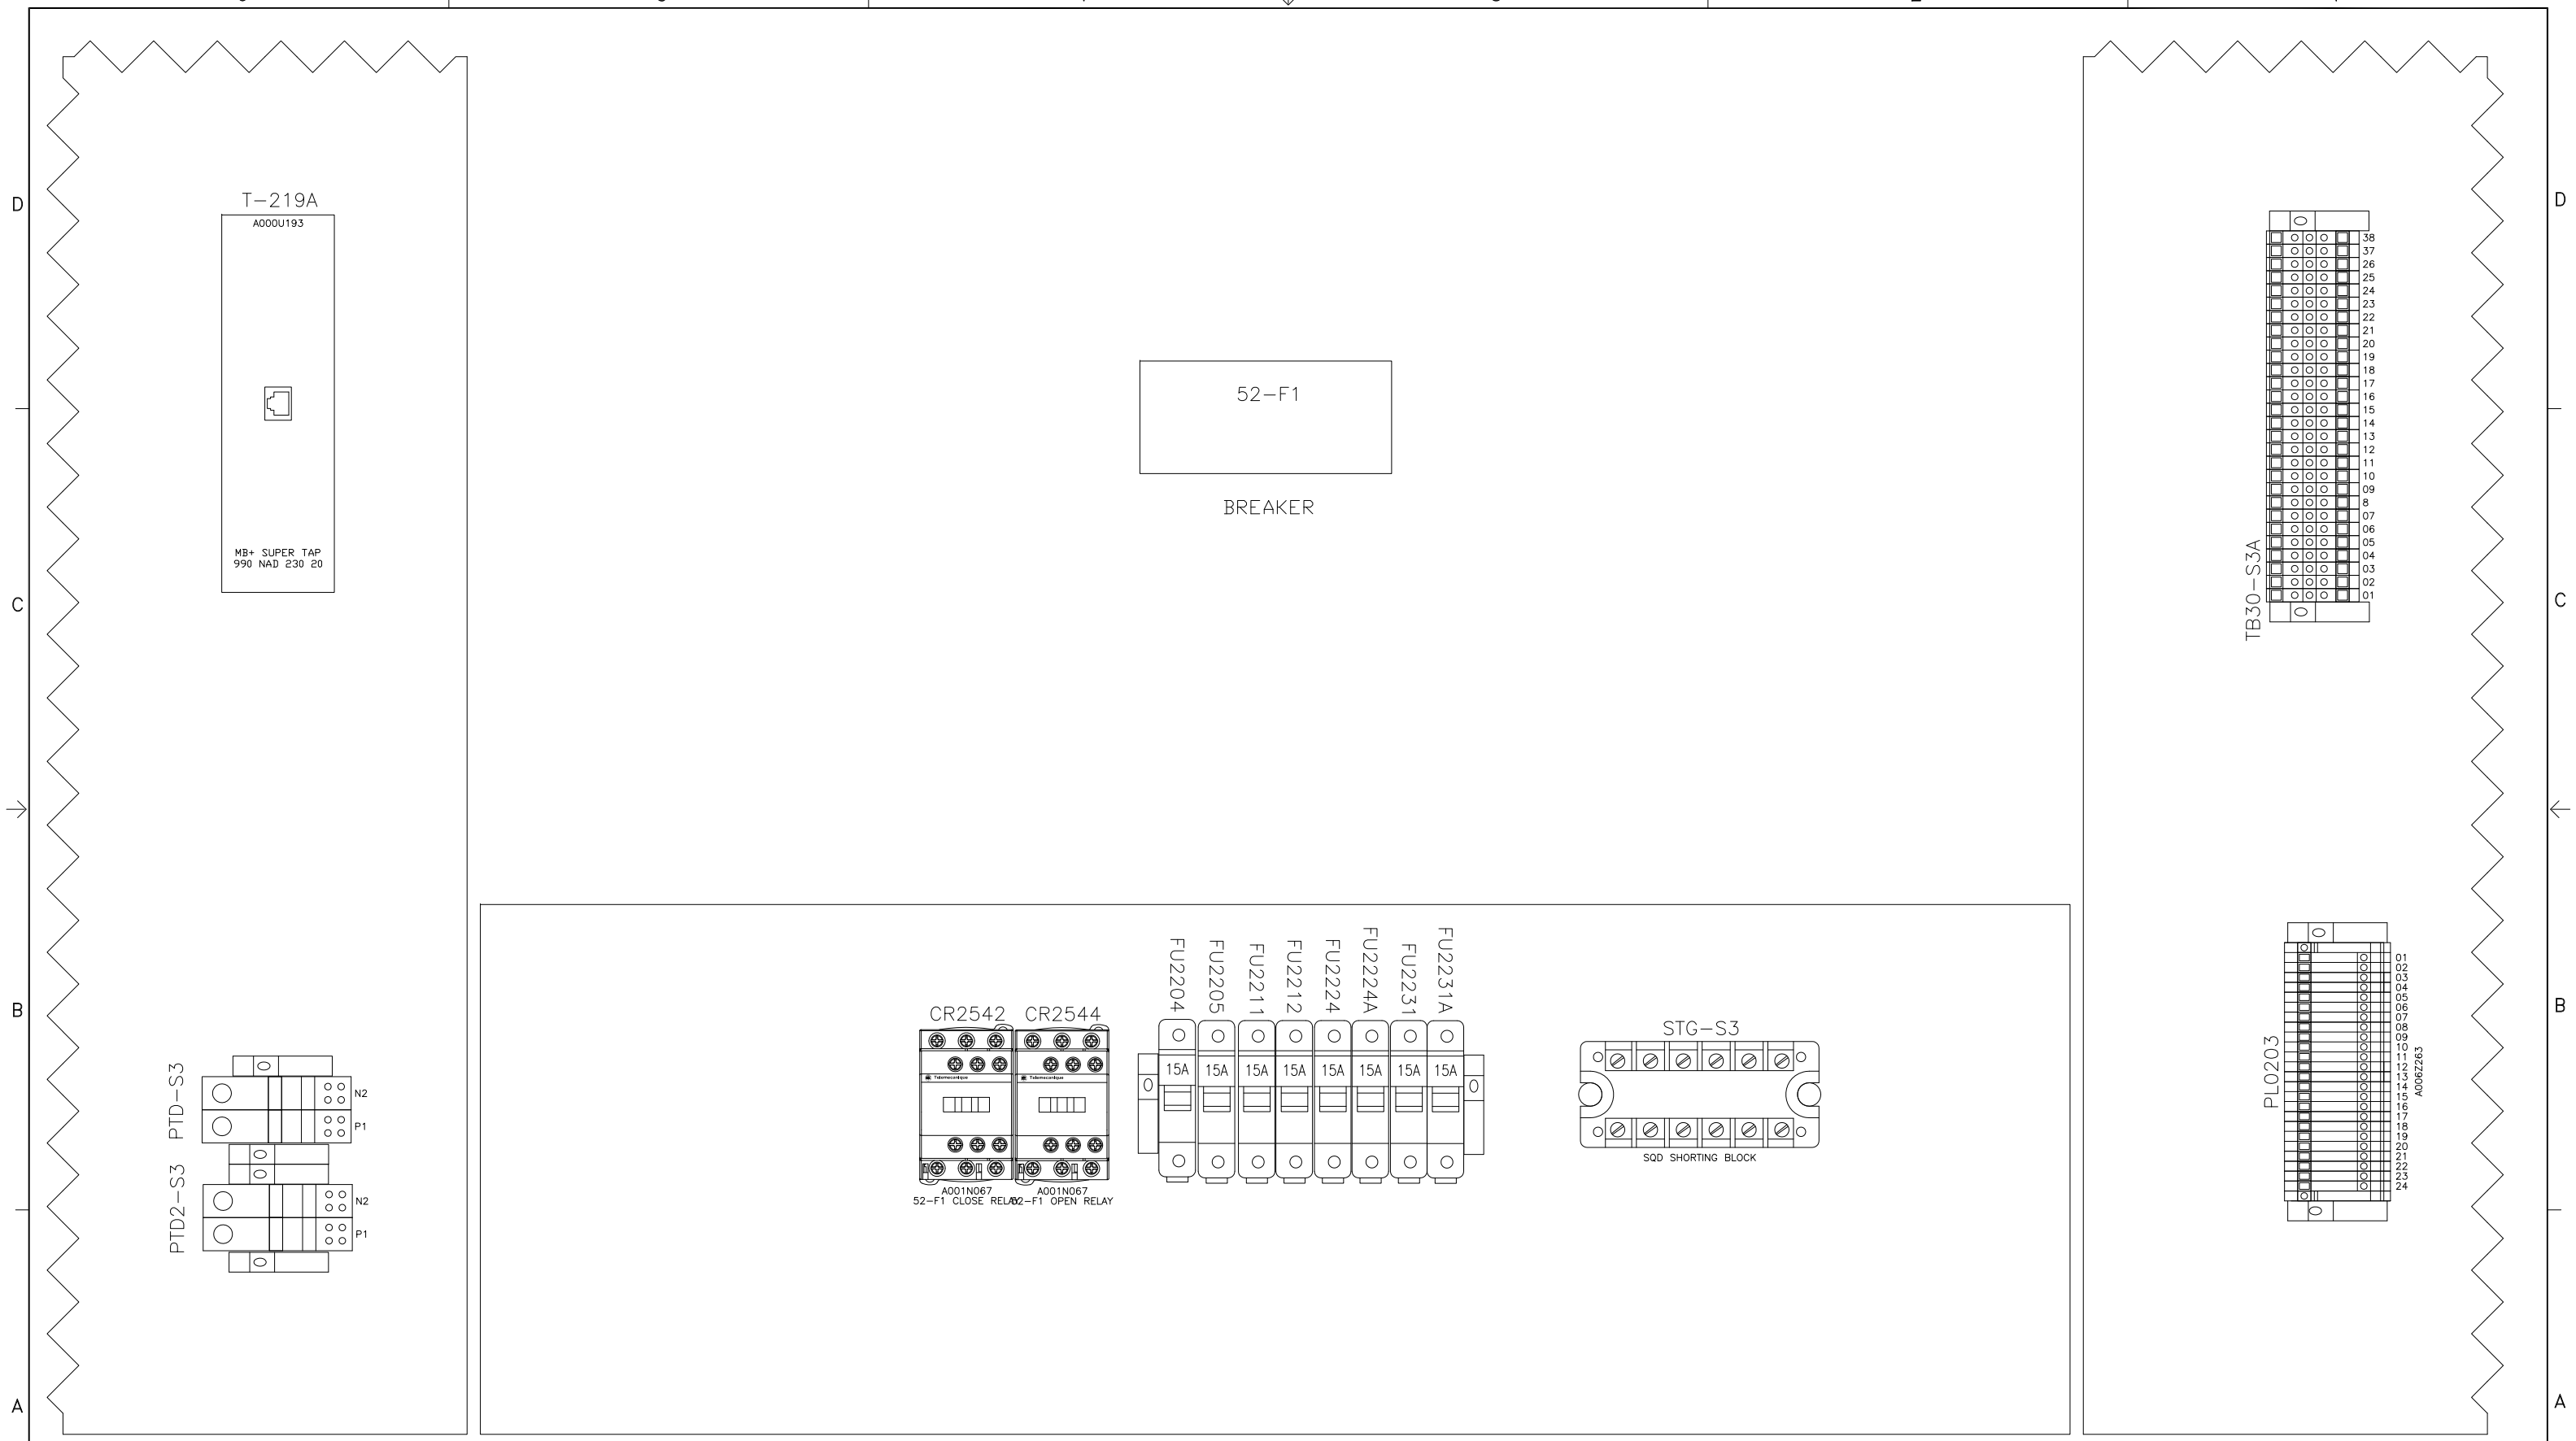

PC NO.	LTR	NO.	REVISION	ZONE	DRA	CHKR	APRV	DATE
PC104235	01	A	PRODUCTION RELEASE AS-BUILT	–	VS	VS	KT	06/17/10

PROJECT:
ARECIBO OBSERVATORY SWITCHGEAR
SG S3A CELL PANEL LAYOUT
DISTRIBUTOR:
CUMMINS CARIBBEAN
7071681

DO NOT SCALE PRINT

AUTOCAD DWG

PART NO.	DWG SIZE	DESCRIPTION OF MATERIAL	REF DES

	NAME	DATE
DR	V.SAKLANI	06/17/10
CHKR	V. SIVAN	06/17/10
APPROVED	K.TWUMASI	06/17/10

SIM TO
COPIED FROM
THREE ANGLE PROJECTION
ANG TOL
DRAWN TO SCALE OF

THIS DOCUMENT IS THE PROPERTY OF CUMMINS POWER GENERATION. IT CONTAINS PROPRIETARY AND CONFIDENTIAL INFORMATION WHICH MUST NOT BE DUPLICATED, USED OR DISCLOSED OTHER THAN EXPRESSLY AUTHORIZED BY CUMMINS POWER GENERATION OR ITS REPRESENTATIVE

FOR INTERPRETATION OF DIMENSIONING AND TOLERANCING, SEE ANSI Y14.5M-1982

MODEL FIRST USED ON PCIL2004R-772F

SITE CODE PGA

CUMMINS POWER GENERATION
1400 73rd AVE. NE
MINNEAPOLIS, MN 55432

TITLE WD-SCHEMATISC

DWG NO. A030S865

SHEET 52 OF 61

DWG SIZE D

TAGS	QTY	SUB	CATALOG	CPG LEGACY	MFG	DESCRIPTION
T-219A	1		A000U193	0324-0027-01	MODICON	MODBUS PLUS SUPER TAP CABLE TAP W/ RJ45 PORT 990 NAD 230 20
PL0203	1		A006Z263	0332-3482-04	WEIDMULLER	TERMINAL - PLUGABLE, SIDE MOUNT, 24 POLE ASSEMBLY 24 22 - 12 AWG
52-F1	1		MV UPPER CELL		SQUARE D	CIRCUIT BREAKER VENDOR
CR2542 CR2544	2		A001N067	0307-2900-05	TELEMECHANIQUE	CONTACTOR-LOW PWR COIL, 24VDC CONTACTOR 24 VDC 4 NO,1 NC, 18A/32A LC1D18BL
FU2204 FU2205 FU2211 FU2212 FU2224 FU2224A FU2231 FU2231A	8	*1	A002K943	0321-0363-30	BUSSMANN	FUSE - CLASS CC TIME DELAY, CURRENT LIMITING 15AMPS 600VAC LP-CC-15 USE WITH FUSE BLOCK 0321-0344
		*1	A002L124	0321-0344	GOULD	1 POLE FUSE BLOCK - CLASS CC FUSE HOLDER 1/10-30AMPS 600VAC PRESSURE PLATE TERM USCC1 USE WITH FUSES LP-CC*
PTD-S3 PTD2-S3	4		SQD PTD		SQUARE D	SUPPLIED BY SQUARE D TERMINAL DC BUS TERMINAL VENDOR SUPPLIED
STG-S3	1		SQD SHORTING BLOCK		SQUARE D	SUPPLIED BY SQUARE D SHORTING BLOCK 6 TERMINAL BY SQUARE D
TB30-S3A	26		A006Z117	0332-3125-01	WEIDMULLER	TERMINAL BLOCK SINGLE LEVEL 600V, 20A SINGLE LEVEL, FEED THROUGH 22-12 AWG 3804.6

PC NO.	LTR	NO.	REVISION	ZONE	DRA	CHKR	APRV	DATE
PC104235	01	A	PRODUCTION RELEASE AS-BUILT	-	VS	VS	KT	06/17/10

PROJECT:
ARECIBO OBSERVATORY SWITCHGEAR
SG S3A PANEL LAYOUT BOM
DISTRIBUTOR:
CUMMINS CARIBBEAN
7071681

DO NOT SCALE PRINT

AUTOCAD DWG

SIM TO
COPIED FROM
THREE ANGLE PROJECTION
ANG TOL
DRAWN TO SCALE OF

THIS DOCUMENT IS THE PROPERTY OF CUMMINS POWER GENERATION. IT CONTAINS PROPRIETARY AND CONFIDENTIAL INFORMATION WHICH MUST NOT BE DUPLICATED, USED OR DISCLOSED OTHER THAN EXPRESSLY AUTHORIZED BY CUMMINS POWER GENERATION OR ITS REPRESENTATIVE

PART NO.	DWG SIZE	DESCRIPTION OF MATERIAL	REF DES

	NAME	DATE
DR	V.SAKLANI	06/17/10
CHKR / MFG	V. SIVAN	06/17/10
APPROVED	K.TWUMASI	06/17/10

FOR INTERPRETATION OF DIMENSIONING AND TOLERANCING, SEE ANSI Y14.5M-1982

MODEL FIRST USED ON PCIL2004R-772F

SITE CODE PGA

CUMMINS POWER GENERATION
1400 73rd AVE NE
MINNEAPOLIS, MN 55432

TITLE WD-SCHEMATISC

DWG NO. A030S865 SHEET 53 OF 61 DWG SIZE D

KP2124

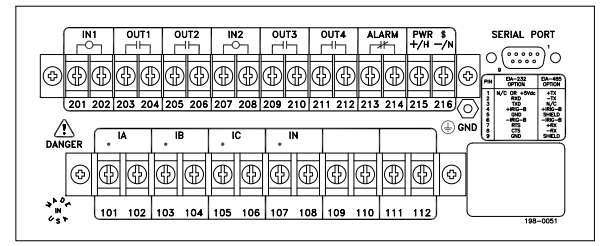

A005P719
SEL551
52-F1

TSW2117

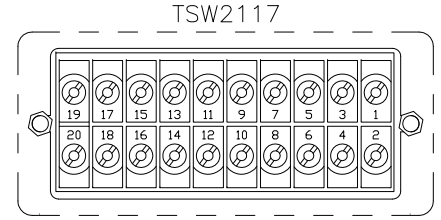

A014T691

SS2205

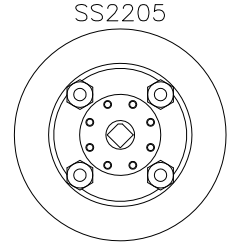

A006X504

SS2206

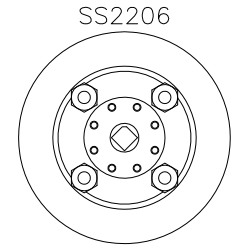

A006X492

LOR2219

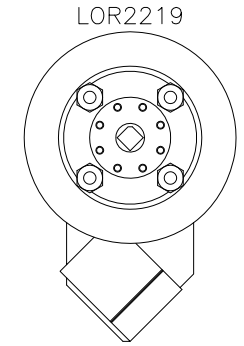

A005R200

REAR DOOR VIEW

PC NO.	LTR	NO.	REVISION	ZONE	DRA	CHKR	APRV	DATE
PC104235	01	A	PRODUCTION RELEASE AS-BUILT	–	VS	VS	KT	06/17/10

PROJECT:
ARECIBO OBSERVATORY SWITCHGEAR
SG S3A DOOR PANEL LAYOUT
DISTRIBUTOR:
CUMMINS CARIBBEAN
7071681

DO NOT SCALE PRINT

ANG TOL | DRAWN TO SCALE OF

AUTOCAD DWG

SIM TO | COPIED FROM | THREE ANGLE PROJECTION

THIS DOCUMENT IS THE PROPERTY OF CUMMINS POWER GENERATION. IT CONTAINS PROPRIETARY AND CONFIDENTIAL INFORMATION WHICH MUST NOT BE DUPLICATED, USED OR DISCLOSED OTHER THAN EXPRESSLY AUTHORIZED BY CUMMINS POWER GENERATION OR ITS REPRESENTATIVE

PART NO.	DWG SIZE	DESCRIPTION OF MATERIAL	REF DES

	NAME	DATE
DR	V.SAKLANI	06/17/10
CHKR	V. SIVAN	06/17/10
MFG		
APPROVED	K.TWUMASI	06/17/10

FOR INTERPRETATION OF DIMENSIONING AND TOLERANCING, SEE ANSI Y14.5M-1982

MODEL FIRST USED ON PCIL2004R-772F

SITE CODE PGA

CUMMINS POWER GENERATION
1400 73rd AVE. NE
MINNEAPOLIS, MN 55432

TITLE WD-SCHEMATISC

DWG NO. A030S865 | SHEET 54 OF 61 | DWG SIZE D

TAGS	QTY	SUB	CATALOG	CPG LEGACY	MFG	DESCRIPTION
KP2124	1		A005P719	0307-3032-06	SCHWEITZER	PROTECTIVE RELAY (SEL 551 MULTIFUNCT) SEL-551 48-125 VDC PS/ 125 VDC CV RS232 COMMUNICATION PORT PROJECTION MOUNT 0551003X551X
LOR2219	1		A005R200	0307-2981-09	ELECTROSWITCH	LOCKOUT RELAY /W INDICATOR 4 DECK 125VDC RED LED INDICATOR, MAINTAINED CONTACTS 20A, 600V 78PA04D-011
SS2206	1		A006X492	0308-1112-02	ELECTROSWITCH	SWITCH-ROTARY - 3 POS, SPRG RTRN FRM BOTH BREAKER CONTROL SWITCH 48-125VDC 20A, 1 DECK, TRIP/CLOSE LED INDICATED, PISTOL HANDLE 24PB38D
SS2205	1		A006X504	0308-1111-05	ELECTROSWITCH	SWITCH ROTARY - 2 POS MAINT -ILLUM MODE 24VDC 20A, 4 DECK, 8 C FORM AUTO/MANUAL, LED INDICATED, PISTOL HANDLE 24PK204LA
TSW2117	1		A014T691	0308-1156-05	ABB	RELAY TEST SWITCH - 8 CURRENT 8 POLE 9672A10G01

PC NO.	LTR	NO.	REVISION	ZONE	DRA	CHKR	APRV	DATE
PC104235	01	A	PRODUCTION RELEASE AS-BUILT	-	VS	VS	KT	06/17/10

PROJECT:
ARECIBO OBSERVATORY SWITCHGEAR
SG S3A DOOR PANEL LAYOUT BOM
DISTRIBUTOR:
CUMMINS CARIBBEAN
7071681

DO NOT SCALE PRINT

ANG TOL | DRAWN TO SCALE OF

AUTOCAD DWG

SIM TO | COPIED FROM | THREE ANGLE PROJECTION

THIS DOCUMENT IS THE PROPERTY OF CUMMINS POWER GENERATION. IT CONTAINS PROPRIETARY AND CONFIDENTIAL INFORMATION WHICH MUST NOT BE DUPLICATED, USED OR DISCLOSED OTHER THAN EXPRESSLY AUTHORIZED BY CUMMINS POWER GENERATION OR ITS REPRESENTATIVE

PART NO.	DWG SIZE	DESCRIPTION OF MATERIAL	REF DES

	NAME	DATE
DR	V.SAKLANI	06/17/10
CHKR	V. SIVAN	06/17/10
MFG		
APPROVED	K.TWUMASI	06/17/10

FOR INTERPRETATION OF DIMENSIONING AND TOLERANCING, SEE ANSI Y14.5M-1982

MODEL FIRST USED ON PCIL2004R-772F

SITE CODE PGA

CUMMINS POWER GENERATION
1400 73rd AVE.NE
MINNEAPOLIS, MN 55432

TITLE WD-SCHEMATISC

DWG NO. A030S865 | SHEET 55 OF 61 | DWG SIZE D

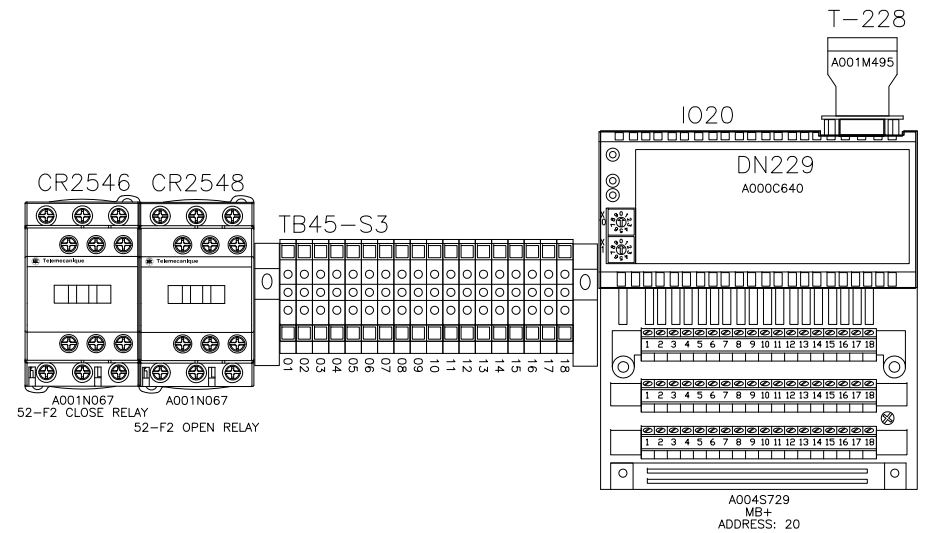

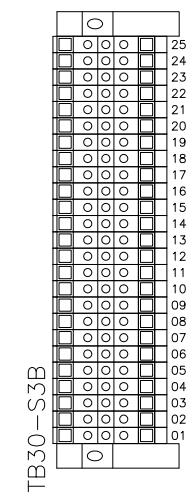

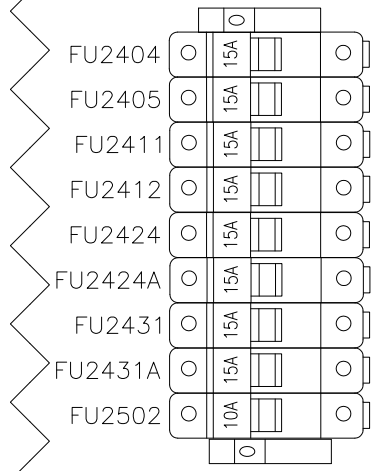

BREAKER

52-F2

PC NO.	LTR	NO.	REVISION	ZONE	DRA	CHKR	APRV	DATE
PC104235	01	A	PRODUCTION RELEASE AS-BUILT	–	VS	VS	KT	06/17/10

PROJECT:
ARECIBO OBSERVATORY SWITCHGEAR
SG S3B CELL PANEL LAYOUT
DISTRIBUTOR:
CUMMINS CARIBBEAN
7071681

DO NOT SCALE PRINT

AUTOCAD DWG

	NAME	DATE
DR	V.SAKLANI	06/17/10
CHKR	V. SIVAN	06/17/10
APPROVED	K.TWUMASI	06/17/10

MODEL FIRST USED ON PCIL2004R-772F

SITE CODE PGA

CUMMINS POWER GENERATION
1400 73rd AVE. NE
MINNEAPOLIS, MN 55432

TITLE WD-SCHEMATISC

DWG NO. A030S865 SHEET 56 OF 61 DWG SIZE D

TAGS	QTY	SUB	CATALOG	CPG LEGACY	MFG	DESCRIPTION
T-228	1		A001M495	0323-1735-02	MODICON	CONNECTOR - MODBUS TERMINATING KIT CONNECTOR TWO PER KIT ASMBKT-185
52-F2	1		MV LOWER CELL		SQUARE D	CIRCUIT BREAKER VENDOR
CR2546 CR2548	2		A001N067	0307-2900-05	TELEMECHANIQUE	CONTACTOR-LOW PWR COIL, 24VDC CONTACTOR 24 VDC 4 NO,1 NC, 18A/32A LC1D18BL
FU2404 FU2405 FU2411 FU2412 FU2424 FU2424A FU2431 FU2431A	8	*1	A002K943	0321-0363-30	BUSSMANN	FUSE - CLASS CC TIME DELAY, CURRENT LIMITING 15AMPS 600VAC LP-CC-15 USE WITH FUSE BLOCK 0321-0344
		*1	A002L124	0321-0344	GOULD	1 POLE FUSE BLOCK - CLASS CC FUSE HOLDER 1/10-30AMPS 600VAC PRESSURE PLATE TERM USCC1 USE WITH FUSES LP-CC*
FU2502	1	*1	A002K944	0321-0363-28	BUSSMANN	FUSE - CLASS CC TIME DELAY, CURRENT LIMITING 10AMPS 600VAC LP-CC-10 USE WITH FUSE BLOCK 0321-0344
		*1	A002L124	0321-0344	GOULD	1 POLE FUSE BLOCK - CLASS CC FUSE HOLDER 1/10-30AMPS 600VAC PRESSURE PLATE TERM USCC1 USE WITH FUSES LP-CC*
DN229	1		A000C640	0326-0205	MODICON	ADAPTER-COMMUNICATION MOMENTUM COMMUNICATION COMMUNICATION ADAPTER MB+ SINGLE PORT, 984 DATA FORMAT 170NEF11021
IO20	1	*1	A004S729	0326-0203-02	MODICON	DISCRETE INPUT/OUTPUT MODULE MOMENTUM DISCRETE COMBINATION 24VDC 16 POINT INPUT, 16 POINT OUTPUT 170ADM35011
		*1	A005L063	0332-3524	MODICON	TERMINAL STRIP MOMENTUM TERMINAL TERMINAL PLUG, 18 PLACE 170XTS00100
STT-S3	1		SQD SHORTING BLOCK		SQUARE D	SUPPLIED BY SQUARE D SHORTING BLOCK 6 TERMINAL BY SQUARE D
TB30-S3B TB45-S3	43		A006Z117	0332-3125-01	WEIDMULLER	TERMINAL BLOCK SINGLE LEVEL 600V, 20A SINGLE LEVEL, FEED THROUGH 22-12 AWG 3804.6
CBL226 CBL228A	2		A000Y808	0326-0149-04	MODICON	CABLE-MODBUS+ TRUNK COMMUNICATION MODBUS PLUS SPECIFY FEET NEEDED, TP-PVC VACCETED REEL

PC NO.	LTR	NO.	REVISION	ZONE	DRA	CHKR	APRV	DATE
PC104235	01	A	PRODUCTION RELEASE AS-BUILT	-	VS	VS	KT	06/17/10

PROJECT:
ARECIBO OBSERVATORY SWITCHGEAR
SG S3B CELL PANEL LAYOUT BOM
DISTRIBUTOR:
CUMMINS CARIBBEAN
7071681

DO NOT SCALE PRINT

ANG TOL | DRAWN TO SCALE OF

AUTOCAD DWG

SIM TO | COPIED FROM | THREE ANGLE PROJECTION

THIS DOCUMENT IS THE PROPERTY OF CUMMINS POWER GENERATION. IT CONTAINS PROPRIETARY AND CONFIDENTIAL INFORMATION WHICH MUST NOT BE REPRODUCED, USED OR DISCLOSED OTHER THAN EXPRESSLY AUTHORIZED BY CUMMINS POWER GENERATION OR ITS REPRESENTATIVE

PART NO.	DWG SIZE	DESCRIPTION OF MATERIAL	REF DES

	NAME	DATE
DR	V.SAKLANI	06/17/10
CHKR ☐ MFG ☐	V. SIVAN	06/17/10
APPROVED	K.TWUMASI	06/17/10

FOR INTERPRETATION OF DIMENSIONING AND TOLERANCING, SEE ANSI Y14.5M-1982

MODEL FIRST USED ON PCIL2004R-772F

SITE CODE PGA

CUMMINS POWER GENERATION
1400 73rd AVE. NE
MINNEAPOLIS, MN 55432

TITLE WD-SCHEMATISC

DWG NO. A030S865 | SHEET 57 OF 61 | DWG SIZE D

SS2406

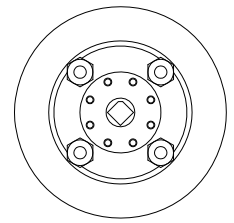

A006X492

LOR2419

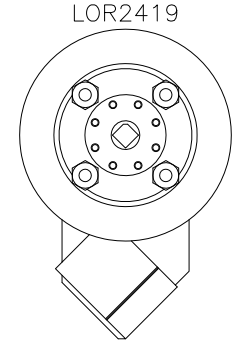

A005R200

KP2324

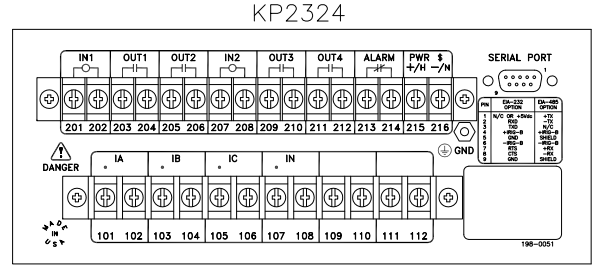

A005P719
SEL551
52-F2

TSW2317

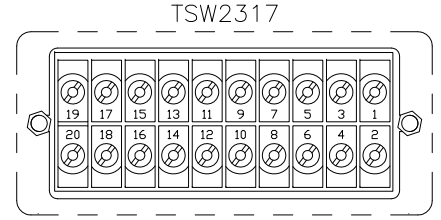

A014T691

REAR DOOR VIEW

PC NO.	LTR	NO.	REVISION	ZONE	DRA	CHKR	APRV	DATE
PC104235	01	A	PRODUCTION RELEASE AS-BUILT	–	VS	VS	KT	06/17/10

PROJECT:
ARECIBO OBSERVATORY SWITCHGEAR
SG S3B DOOR PANEL LAYOUT
DISTRIBUTOR:
CUMMINS CARIBBEAN
7071681

DO NOT SCALE PRINT

ANG TOL | DRAWN TO SCALE OF

AUTOCAD DWG

SIM TO | COPIED FROM | THREE ANGLE PROJECTION

THIS DOCUMENT IS THE PROPERTY OF CUMMINS POWER GENERATION. IT CONTAINS PROPRIETARY AND CONFIDENTIAL INFORMATION WHICH MUST NOT BE DUPLICATED, USED OR DISCLOSED OTHER THAN EXPRESSLY AUTHORIZED BY CUMMINS POWER GENERATION OR ITS REPRESENTATIVE

PART NO.	DWG SIZE	DESCRIPTION OF MATERIAL	REF DES

	NAME	DATE
DR	V.SAKLANI	06/17/10
CHKR / MFG	V. SIVAN	06/17/10
APPROVED	K.TWUMASI	06/17/10

FOR INTERPRETATION OF DIMENSIONING AND TOLERANCING, SEE ANSI Y14.5M-1982

MODEL FIRST USED ON: PCIL2004R-772F

SITE CODE: PGA

CUMMINS POWER GENERATION
1400 73rd AVE NE
MINNEAPOLIS, MN 55432

TITLE: WD-SCHEMATISC

DWG NO. A030S865 | SHEET 58 OF 61 | DWG SIZE D

TAGS	QTY	SUB	CATALOG	CPG LEGACY	MFG	DESCRIPTION
KP2324	1		A005P719	0307-3032-06	SCHWEITZER	PROTECTIVE RELAY (SEL 551 MULTIFUNCT) SEL-551 48-125 VDC PS/ 125 VDC CV RS232 COMMUNICATION PORT PROJECTION MOUNT 0551003X551X
LOR2419	1		A005R200	0307-2981-09	ELECTROSWITCH	LOCKOUT RELAY /W INDICATOR 4 DECK 125VDC RED LED INDICATOR, MAINTAINED CONTACTS 20A, 600V 78PAD4D-011
SS2406	1		A006X492	0308-1112-02	ELECTROSWITCH	SWITCH-ROTARY - 3 POS, SPRG RTRN FRM BOTH BREAKER CONTROL SWITCH 48-125VDC 20A, 1 DECK, TRIP/CLOSE LED INDICATED, PISTOL HANDLE 24PB38D
TSW2317	1		A014T691	0308-1156-05	ABB	RELAY TEST SWITCH - 8 CURRENT 8 POLE 9672A10G01

PC NO.	LTR	NO.	REVISION	ZONE	DRA	CHKR	APRV	DATE
PC104235	01	A	PRODUCTION RELEASE AS-BUILT	-	VS	VS	KT	06/17/10

PROJECT:
ARECIBO OBSERVATORY SWITCHGEAR
SG S3B DOOR PANEL LAYOUT BOM
DISTRIBUTOR:
CUMMINS CARIBBEAN
7071681

DO NOT SCALE PRINT

ANG TOL | DRAWN TO SCALE OF

AUTOCAD DWG

SIM TO | COPIED FROM | THREE ANGLE PROJECTION

THIS DOCUMENT IS THE PROPERTY OF CUMMINS POWER GENERATION. IT CONTAINS PROPRIETARY AND CONFIDENTIAL INFORMATION WHICH MUST NOT BE DUPLICATED, USED OR DISCLOSED OTHER THAN EXPRESSLY AUTHORIZED BY CUMMINS POWER GENERATION OR ITS REPRESENTATIVE

PART NO.	DWG SIZE	DESCRIPTION OF MATERIAL	REF DES

	NAME	DATE
DR	V.SAKLANI	06/17/10
CHKR	V. SIVAN	06/17/10
MFG		
APPROVED	K.TWUMASI	06/17/10

FOR INTERPRETATION OF DIMENSIONING AND TOLERANCING, SEE ANSI Y14.5M-1982

MODEL FIRST USED ON PCIL2004R-772F

SITE CODE PGA

CUMMINS POWER GENERATION
1400 73rd AVE.NE
MINNEAPOLIS, MN 55432

TITLE WD-SCHEMATISC

DWG NO. A030S865 | SHEET 59 OF 61 | DWG SIZE D

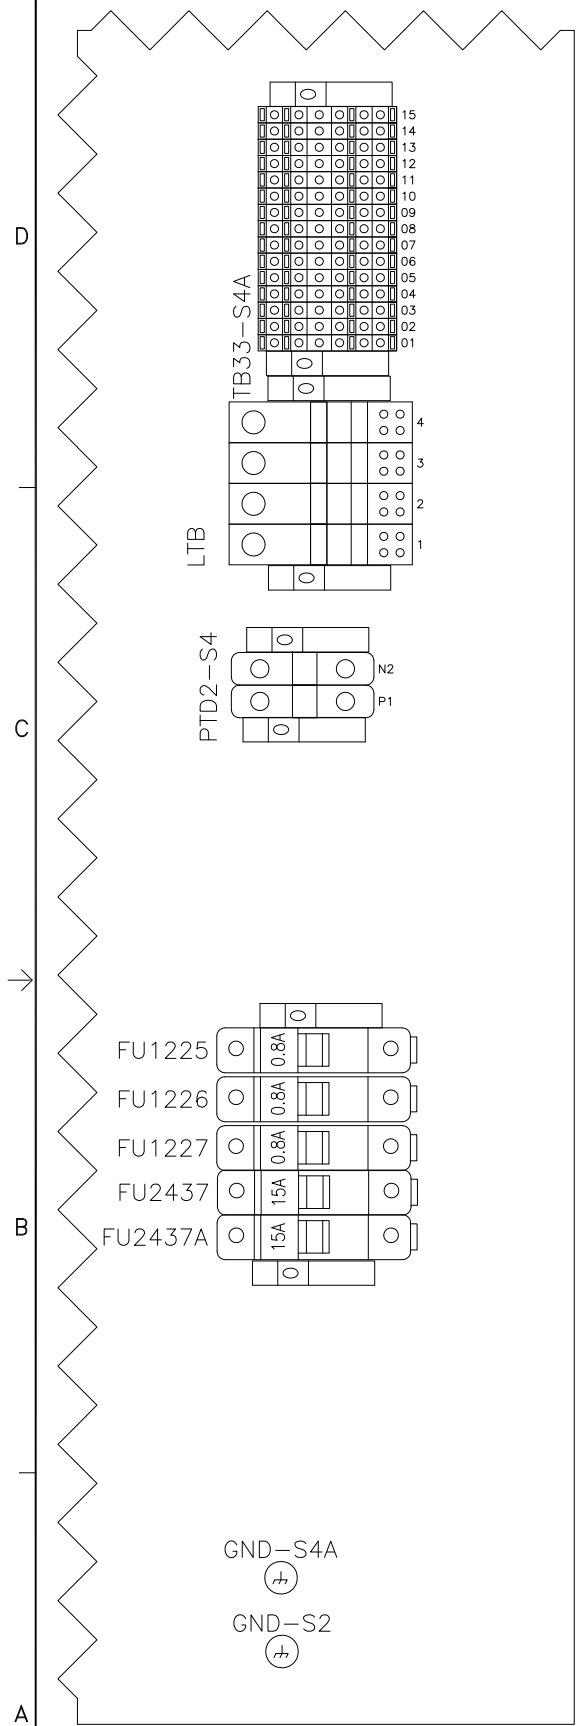

BREAKER

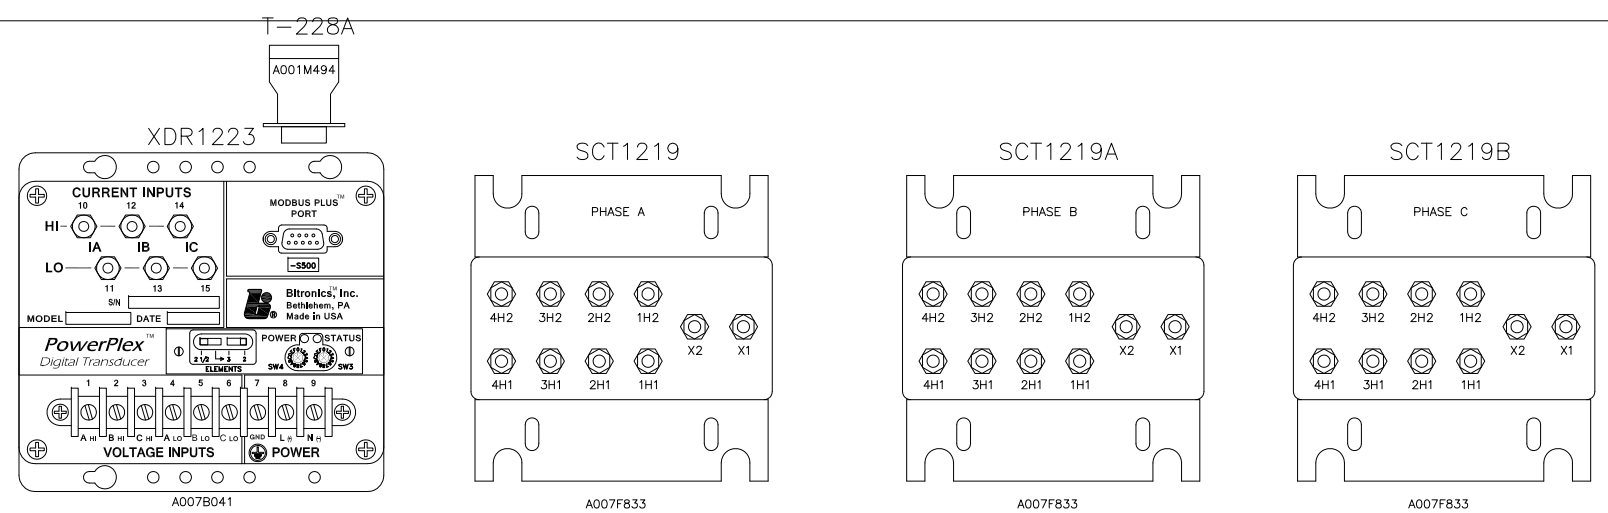

PC NO.	LTR	NO.	REVISION	ZONE	DRA	CHKR	APRV	DATE
PC104235	01	A	PRODUCTION RELEASE AS-BUILT	–	VS	VS	KT	06/17/10

PROJECT:
ARECIBO OBSERVATORY SWITCHGEAR
SG S4A CELL PANEL LAYOUT
DISTRIBUTOR:
CUMMINS CARIBBEAN
7071681

DO NOT SCALE PRINT

ANG TOL | DRAWN TO SCALE OF

AUTOCAD DWG

SIM TO | COPIED FROM | THREE ANGLE PROJECTION

THIS DOCUMENT IS THE PROPERTY OF CUMMINS POWER GENERATION. IT CONTAINS PROPRIETARY AND CONFIDENTIAL INFORMATION WHICH MUST NOT BE DUPLICATED, USED OR DISCLOSED OTHER THAN EXPRESSLY AUTHORIZED BY CUMMINS POWER GENERATION OR ITS REPRESENTATIVE

PART NO.	DWG SIZE	DESCRIPTION OF MATERIAL	REF DES

	NAME	DATE
DR	V.SAKLANI	06/17/10
CHKR	V. SIVAN	06/17/10
MFG		
APPROVED	K.TWUMASI	06/17/10

FOR INTERPRETATION OF DIMENSIONING AND TOLERANCING, SEE ANSI Y14.5M-1982

MODEL FIRST USED ON PCIL2004R-772F

SITE CODE PGA

CUMMINS POWER GENERATION
1400 73rd AVE. NE
MINNEAPOLIS, MN 55432

TITLE WD-SCHEMATISC

DWG NO. A030S865 | SHEET 60 OF 61 | DWG SIZE D

TAGS	QTY	SUB	CATALOG	CPG LEGACY	MFG	DESCRIPTION
T-228A	1		A001M494	0323-1735-01	MODICON	CONNECTOR - MODBUS INLINE KIT CONNECTOR ONE PER KIT AS-MBKT-085
FU1225 FU1226 FU1227	3	*1	A002K940	0321-0363-03	BUSSMANN	FUSE - CLASS CC TIME DELAY, CURRENT LIMITING 8/10AMPS 600VAC LP-CC-8/10 USE WITH FUSE BLOCK 0321-0344
		*1	A002L124	0321-0344	GOULD	1 POLE FUSE BLOCK - CLASS CC FUSE HOLDER 1/10-30AMPS 600VAC PRESSURE PLATE TERM USCC1 USE WITH FUSES LP-CC*
FU2437 FU2437A	2	*1	A002K943	0321-0363-30	BUSSMANN	FUSE - CLASS CC TIME DELAY, CURRENT LIMITING 15AMPS 600VAC LP-CC-15 USE WITH FUSE BLOCK 0321-0344
		*1	A002L124	0321-0344	GOULD	1 POLE FUSE BLOCK - CLASS CC FUSE HOLDER 1/10-30AMPS 600VAC PRESSURE PLATE TERM USCC1 USE WITH FUSES LP-CC*
GND-S2 GND-S4A	2		FRAME GROUND		VENDOR SOURCE CONTROLLED	GROUNDING TERMINAL LUG
LTB	4		SQD PTD		SQUARE D	SUPPLIED BY SQUARE D TERMINAL DC BUS TERMINAL VENDOR SUPPLIED
PTD2-S4	2		SQD TERMINAL		SQUARE D	SUPPLIED BY SQUARE D TERMINAL TERMINAL BLOCK VENDOR SUPPLIED
TB33-S4A	15		A006Z109	0332-3125-04	WEIDMULLER	TERMINAL BLOCK DOUBLE LEVEL 300V, 27A DOUBLE LEVEL, FEED THROUGH, WITH INTERNAL LINK 22-12 AWG 3636.6
XDR1223	1		A007B041	0326-0156-01	BITRONICS	3 PHASE MULTIFUCNTION DIGITAL TRANSDUCER, 120V INPUT DIGITAL 24VDC MODBUS PLUS PORT MTWIN3B-S500-VD10
SCT1219 SCT1219A SCT1219B	3		A007F833	0302-1974-01	INSTRUMENT TRANSFORMERS	TRANSFORMER-CURRENT SUMMING CT 4 INPUT METERING CLASS, 25-400HZ 190XSUM4

PC NO.	LTR	NO.	REVISION	ZONE	DRA	CHKR	APRV	DATE
PC104235	01	A	PRODUCTION RELEASE AS-BUILT	-	VS	VS	KT	06/17/10

PROJECT:
ARECIBO OBSERVATORY SWITCHGEAR
SG S4A CELL PANEL LAYOUT BOM
DISTRIBUTOR:
CUMMINS CARIBBEAN
7071681

DO NOT SCALE PRINT

ANG TOL | DRAWN TO SCALE OF

AUTOCAD DWG

SIM TO | COPIED FROM | THREE ANGLE PROJECTION

THIS DOCUMENT IS THE PROPERTY OF CUMMINS POWER GENERATION. IT CONTAINS PROPRIETARY AND CONFIDENTIAL INFORMATION WHICH MUST NOT BE DUPLICATED, USED OR DISCLOSED OTHER THAN EXPRESSLY AUTHORIZED BY CUMMINS POWER GENERATION OR ITS REPRESENTATIVE

PART NO.	DWG SIZE	DESCRIPTION OF MATERIAL	REF DES

	NAME	DATE
DR	V.SAKLANI	06/17/10
CHKR ☐ MFG ☐	V. SIVAN	06/17/10
APPROVED	K.TWUMASI	06/17/10

FOR INTERPRETATION OF DIMENSIONING AND TOLERANCING, SEE ANSI Y14.5M-1982

MODEL FIRST USED ON PCIL2004R-772F

SITE CODE PGA

CUMMINS POWER GENERATION
1400 73rd AVE. NE
MINNEAPOLIS, MN 55432

TITLE WD-SCHEMATISC

DWG NO. A030S865 | SHEET 61 OF 61 | DWG SIZE D